


CS 4170
 RECORD OF SURVEY FOR
 CONSUMERS POWER, INC.
 SEC. 18, T.10S, R.4W, W.M.
 BENTON COUNTY, OREGON
 Scale 1"=100'
 November 26, 1965
 Bearings based on C.S. No 4066

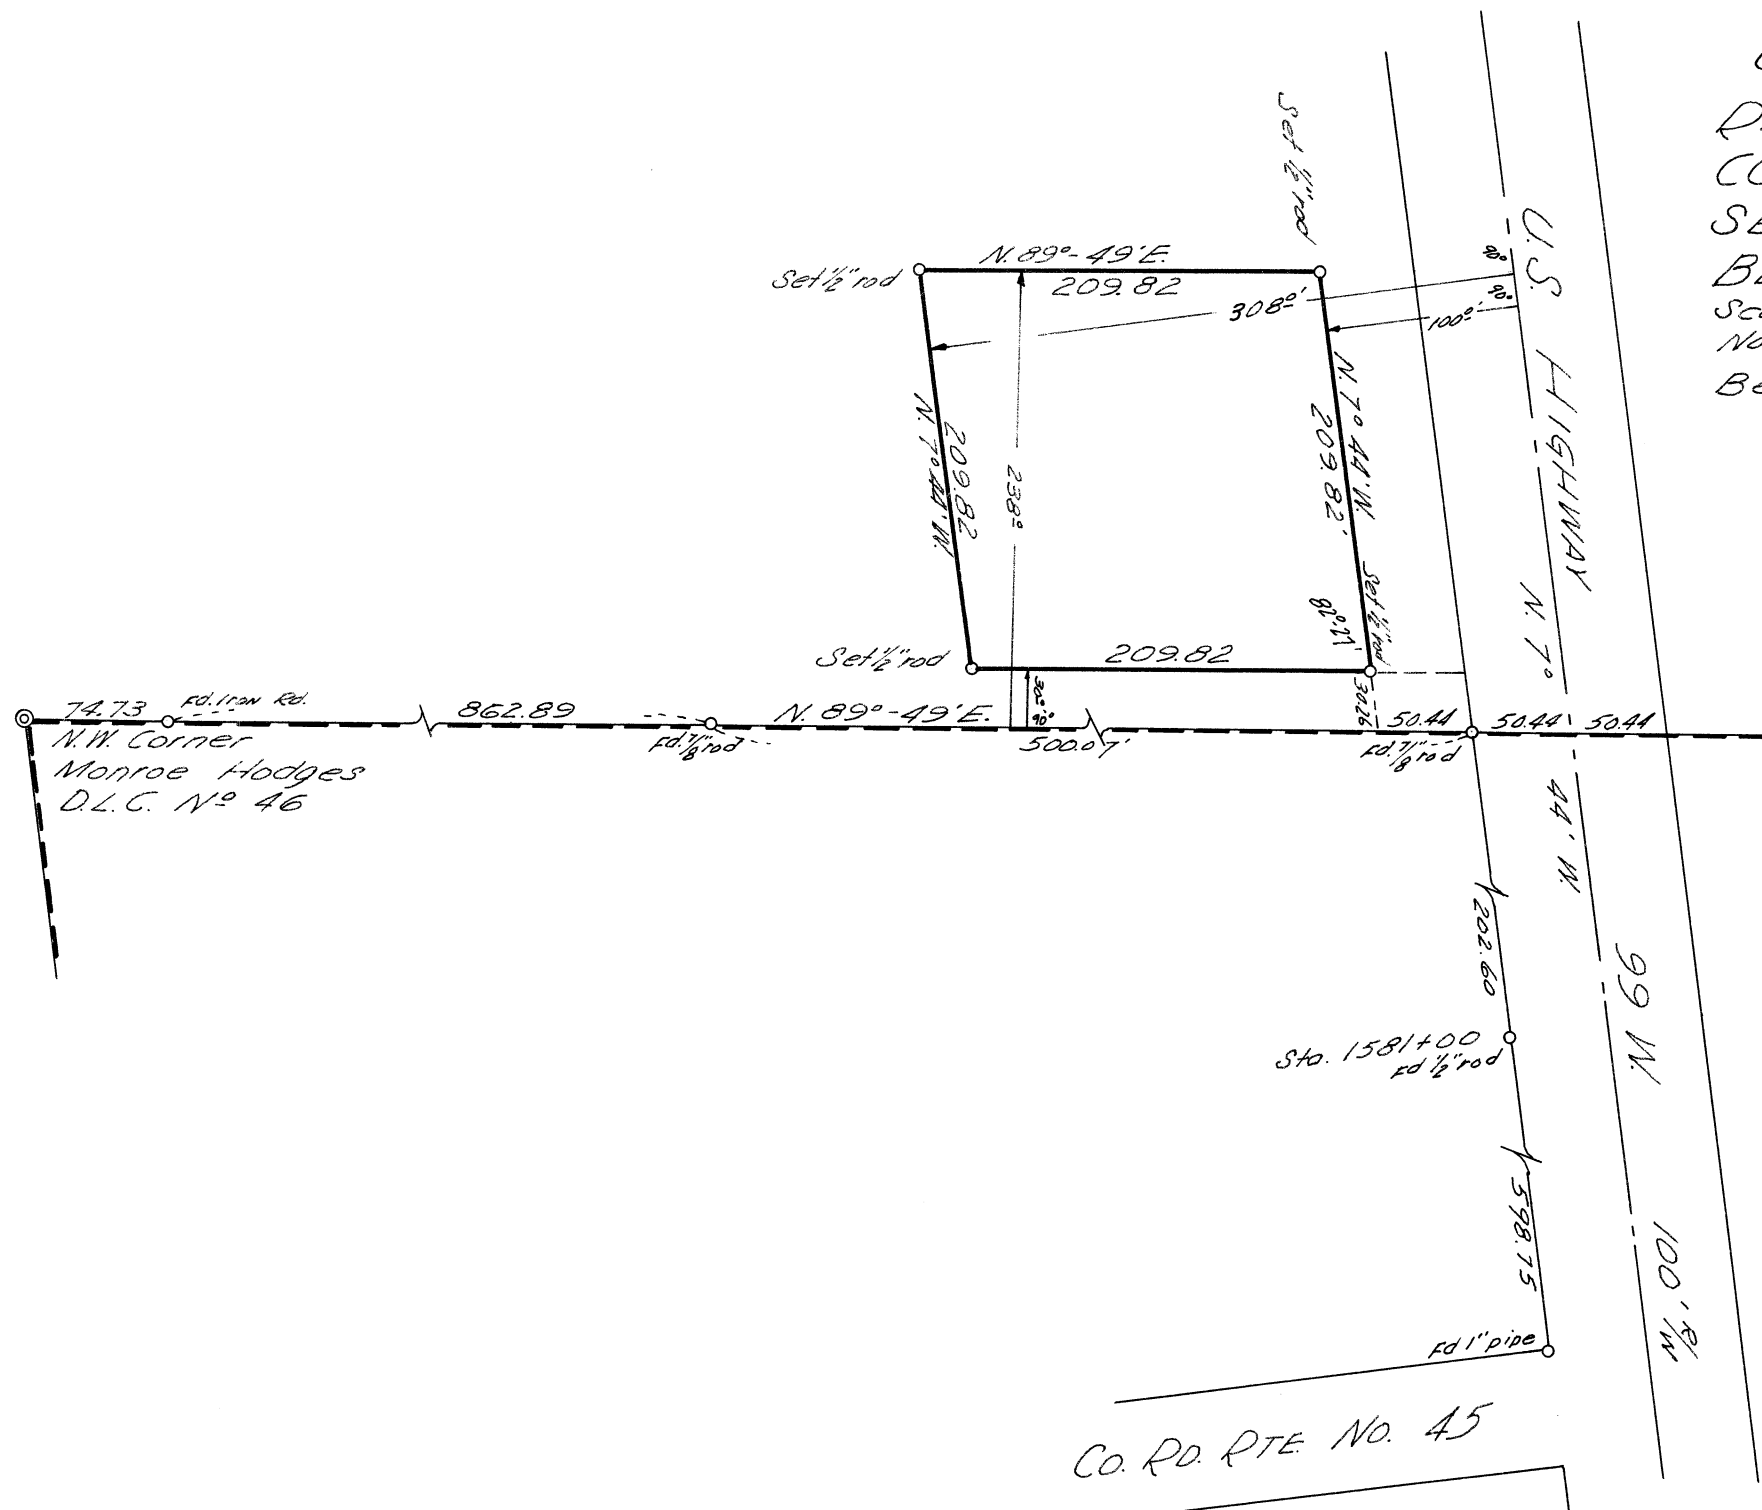

REGISTERED
 OREGON
 LAND SURVEYOR

Richard W. Fail

NOV. 4, 1955
 RICHARD W. FAIL
 357