


79

4199

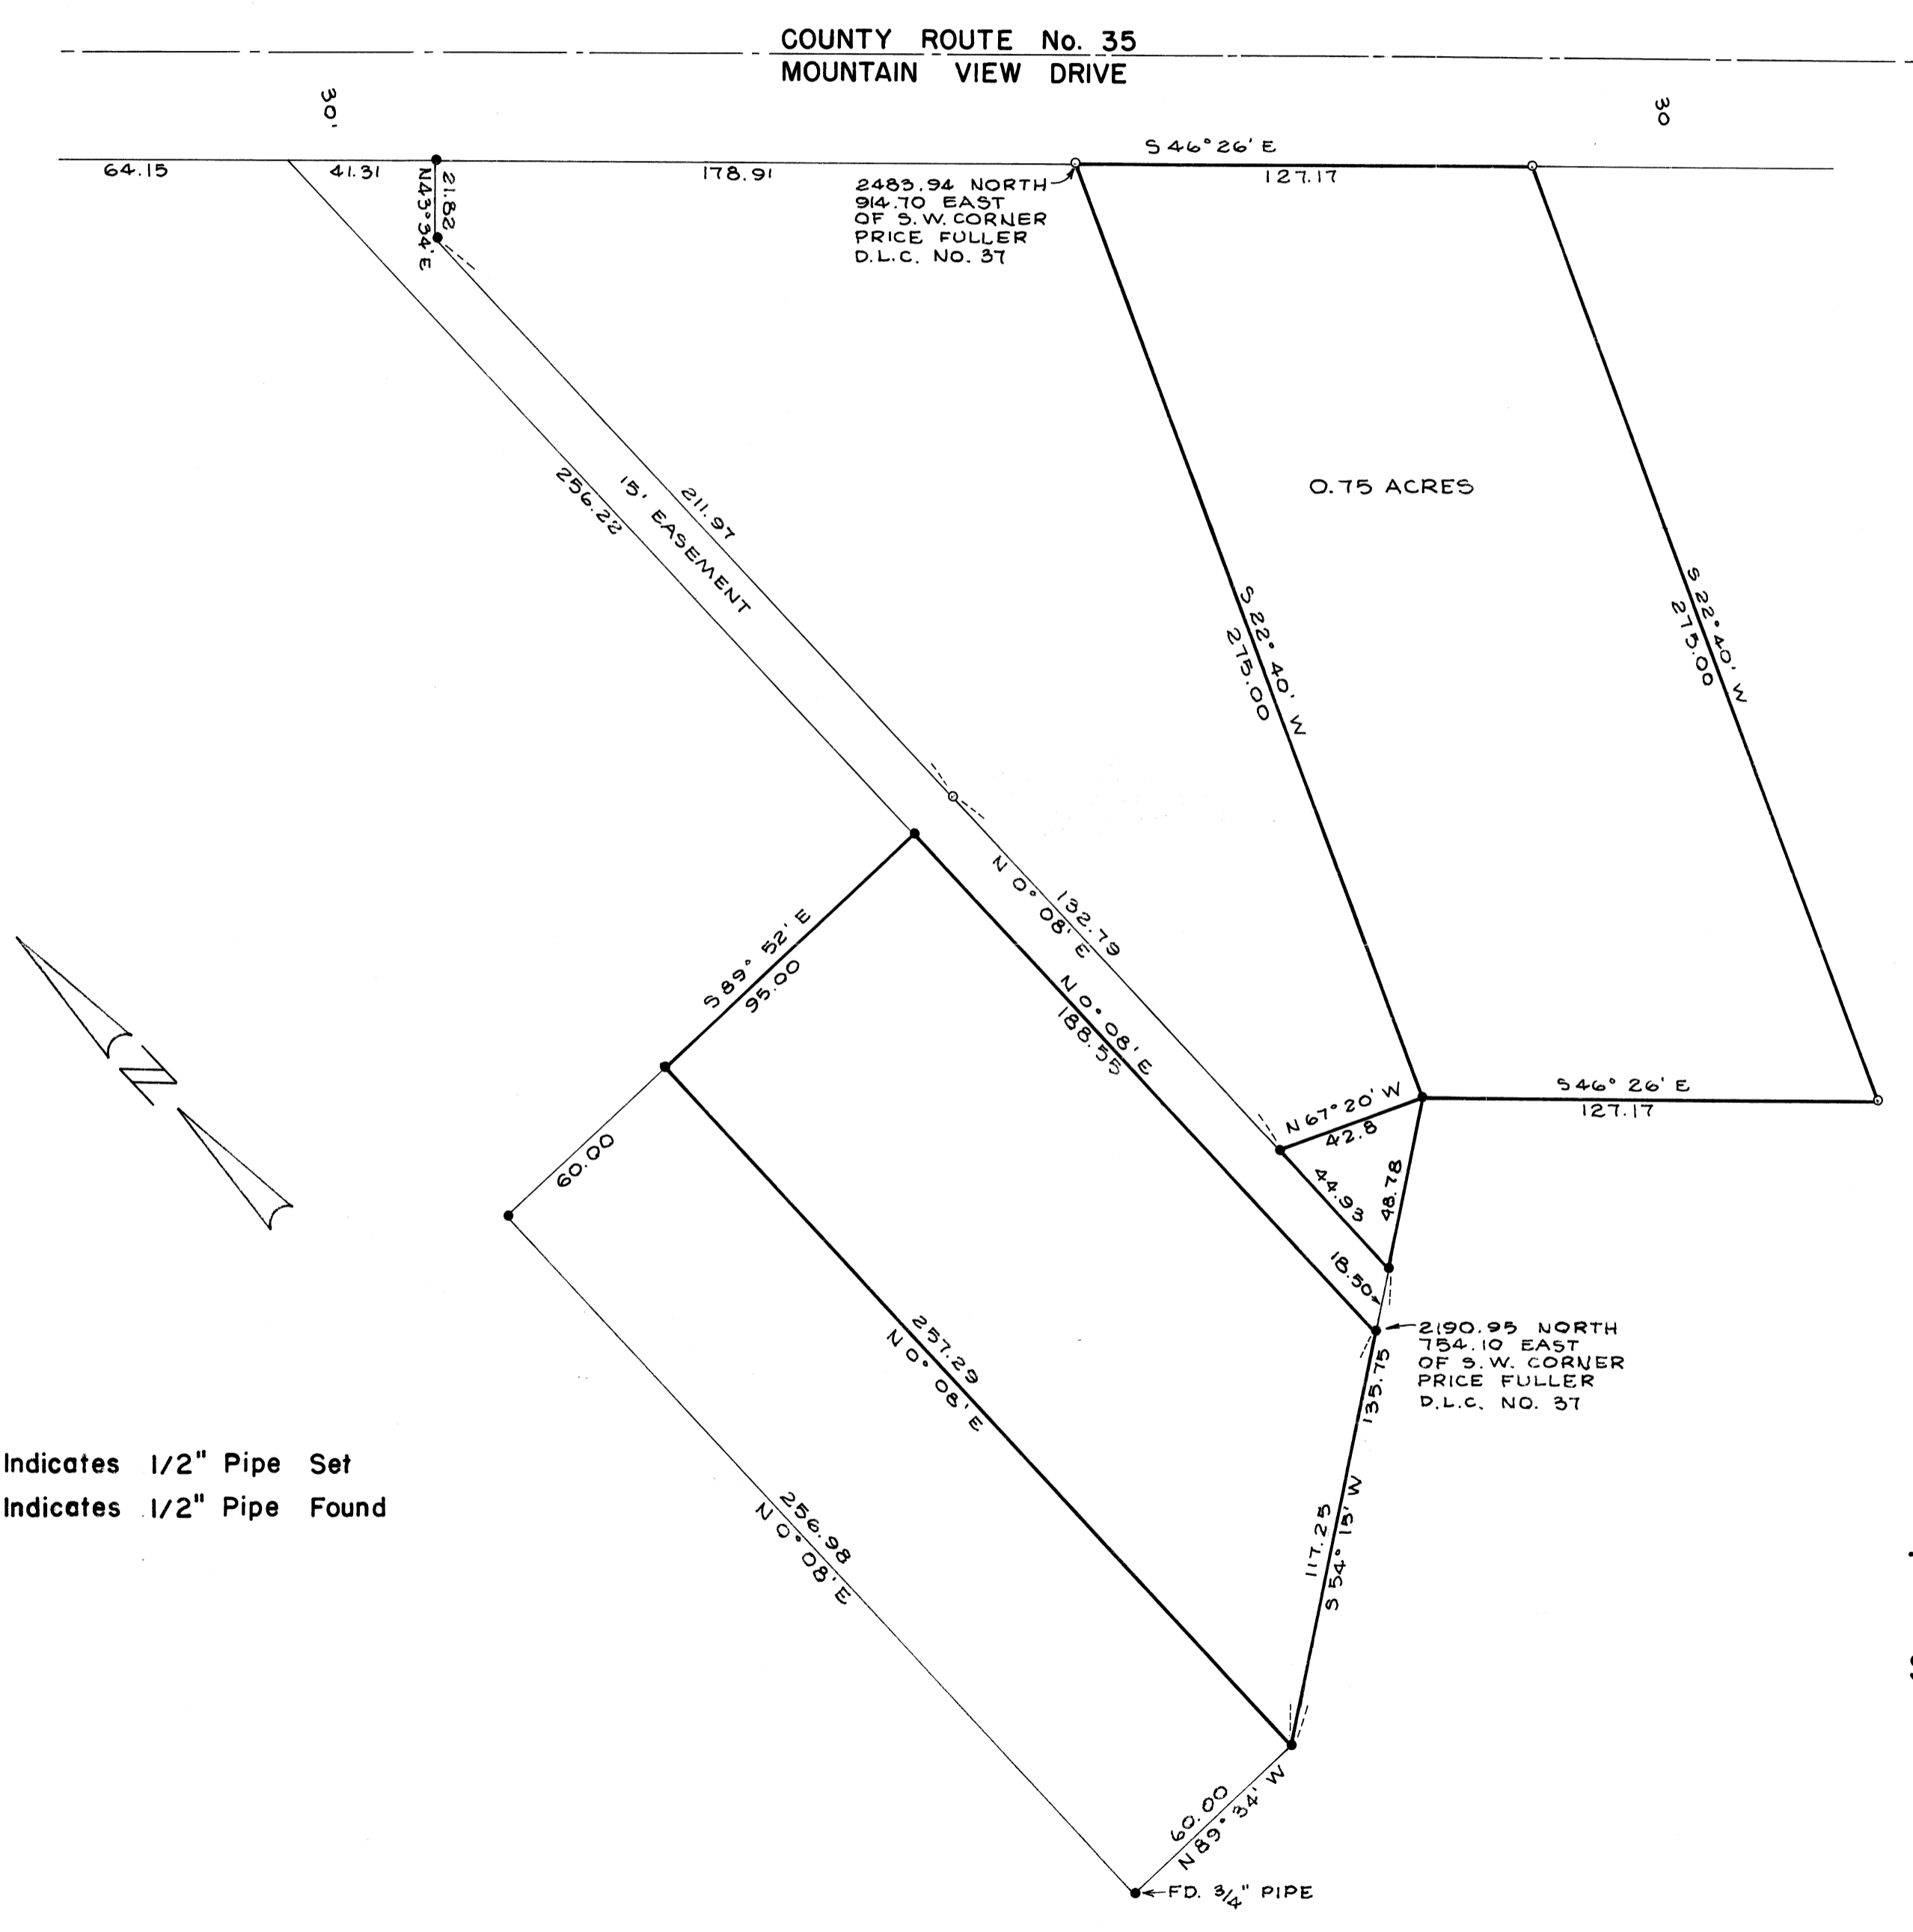

- Indicates 1/2" Pipe Set
- Indicates 1/2" Pipe Found

C.S. 4199
 SURVEY FOR
FRED PLYMPTON
 IN THE PRICE FULLER D. L. C. No. 37
 TOWNSHIP 11 SOUTH, RANGE 5 WEST OF W. M.
 BENTON COUNTY, OREGON
 SCALE: 1" = 40' JAN. 4, 1966

REGISTERED
 OREGON
 LAND SURVEYOR
Fred I. Lemke
 MAY 2, 1966
 FRED I. LEMKE
 443