


CS 4216


SURVEY FOR  
**GORDON LARSON**  
 A SOUTHERLY PORTION OF LOTS 1 & 2  
 BLOCK 3  
 SUNSET PARK SUBDIVISION  
 PHILOMATH, OREGON

SCALE 1" = 30

DEC. 16, 1965

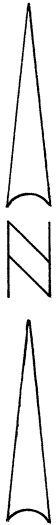

20th STREET

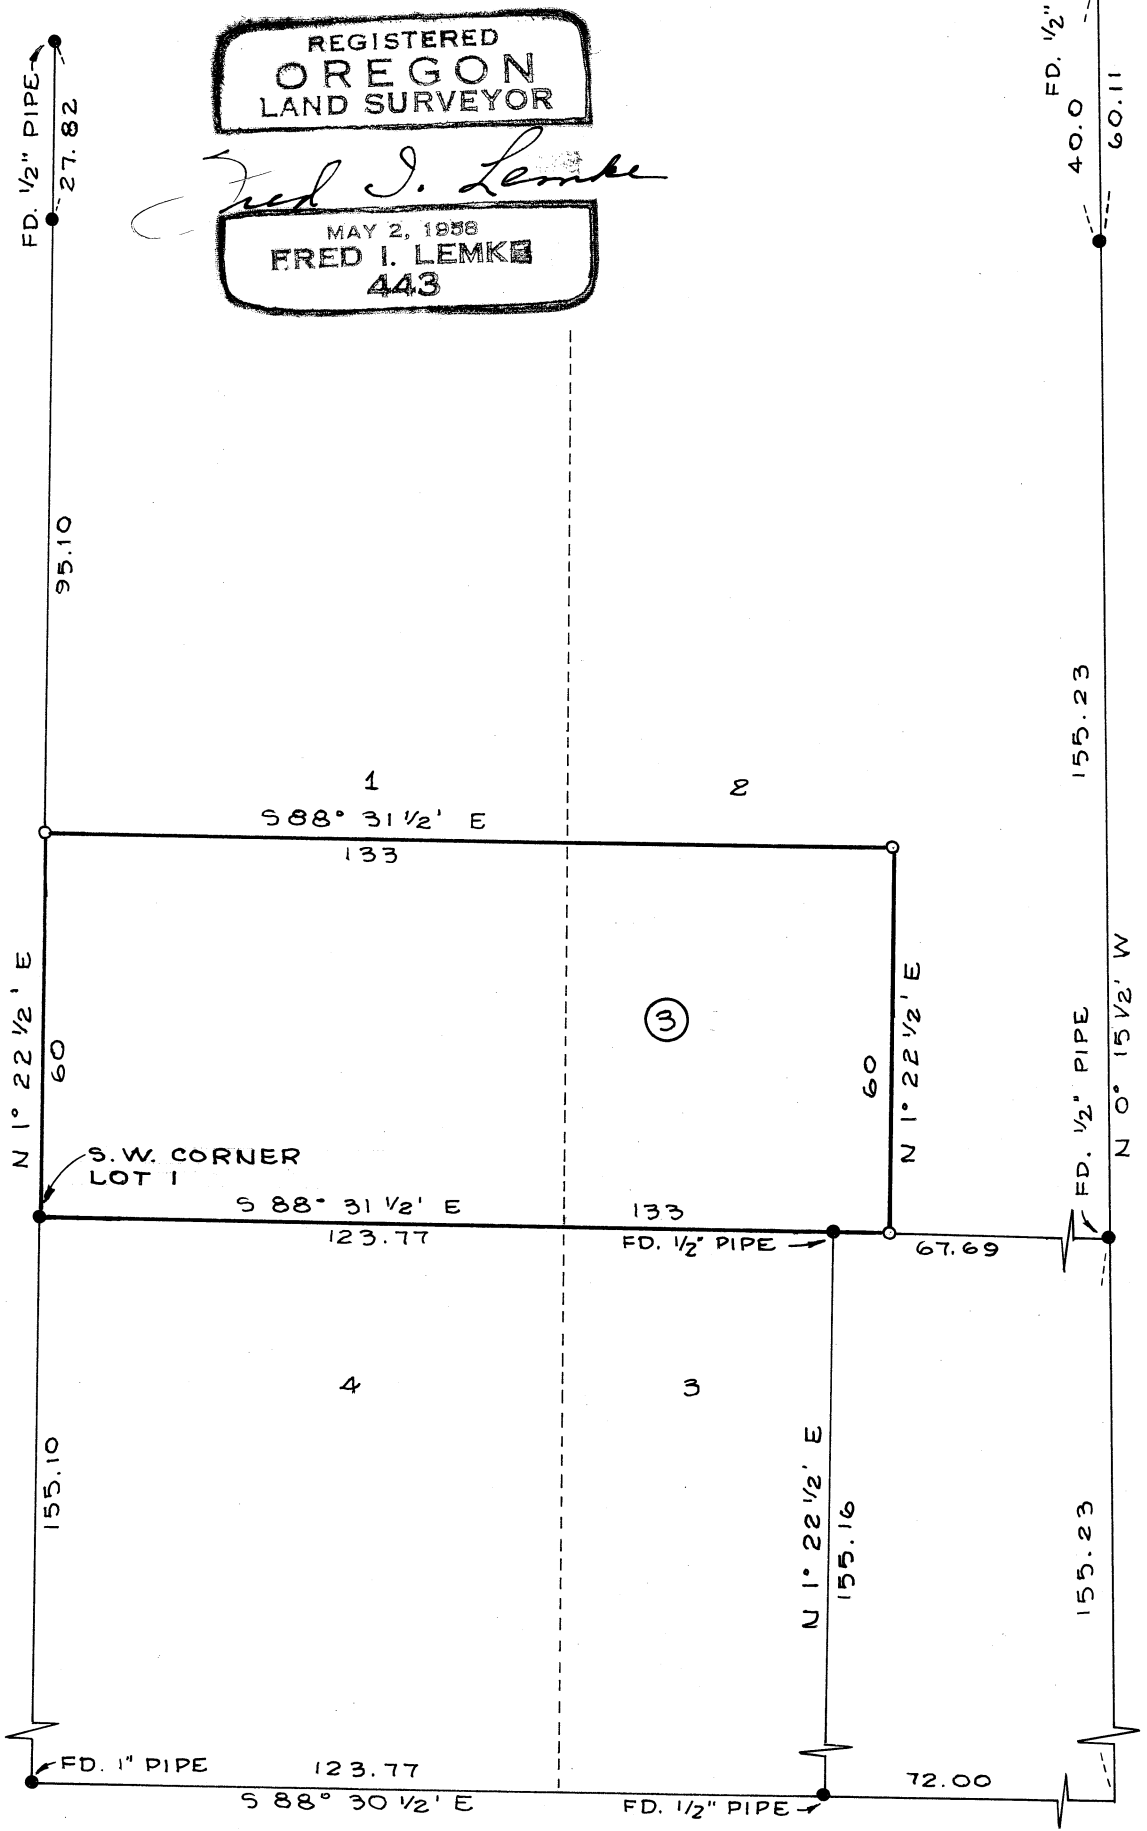

REGISTERED  
**OREGON**  
 LAND SURVEYOR

*Fred J. Lemke*

MAY 2, 1958  
**FRED I. LEMKE**  
 443

○ - INDICATES 1/2" PIPE SET  
 ● - INDICATES 3/4" PIPE FOUND EXCEPT AS NOTED

APPLEGATE STREET