


CS 4239
DON CARLSON
 SEC. 11, T. 15 S., R. 5 W., W.M.
 Benton & Lane County, Ore.
 Scale: 1" = 200' 21 April 1966
 Ref: CS 72 (Benton County)
 B. Osburn Shaw
 O. L. S. # 431

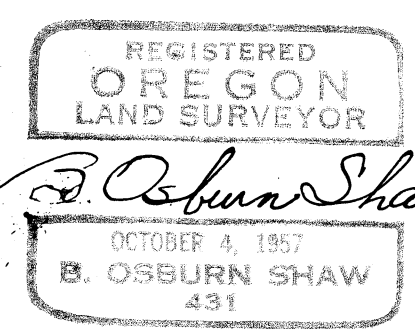

Set 5/8" Rod in R of county road
 516°16'W, 89.20)
 (36" Oak #114300
 P. Pole #114300
 382°15'W, 19.00)

4239