

CS 4281

NOTE ~


- Denotes monuments found as shown.
- Denotes 1/2" x 24" Iron rods set & brass screws set.

Measured angles, used deed distances, checked plat distances, proceeded as shown.

Basis of Bearings - From Plat.

BOUNDARY SURVEY

PART OF LOTS 1, 2 & 3, BLOCK 2
 HIGHLAND LAWN ACRES
 CITY OF CORVALLIS
 BENTON Co. OREGON
 SCALE 1" = 200' 6-23-66

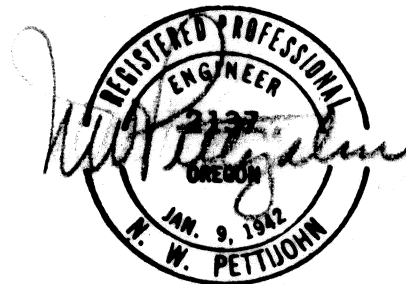

PETTIJOHN ENGINEERING CO.

AT 2-0901 4145 N. E. GULLY BLVD.
 PORTLAND 18, OREGON

66-269

T 115, R 5W BN 6331

BN 4531