


4345

SPRICK ROOFING CO. SURVEY
IN RAYBURN ADDITION
CORVALLIS, OREGON
SCALE 1"=50' 1-6-67

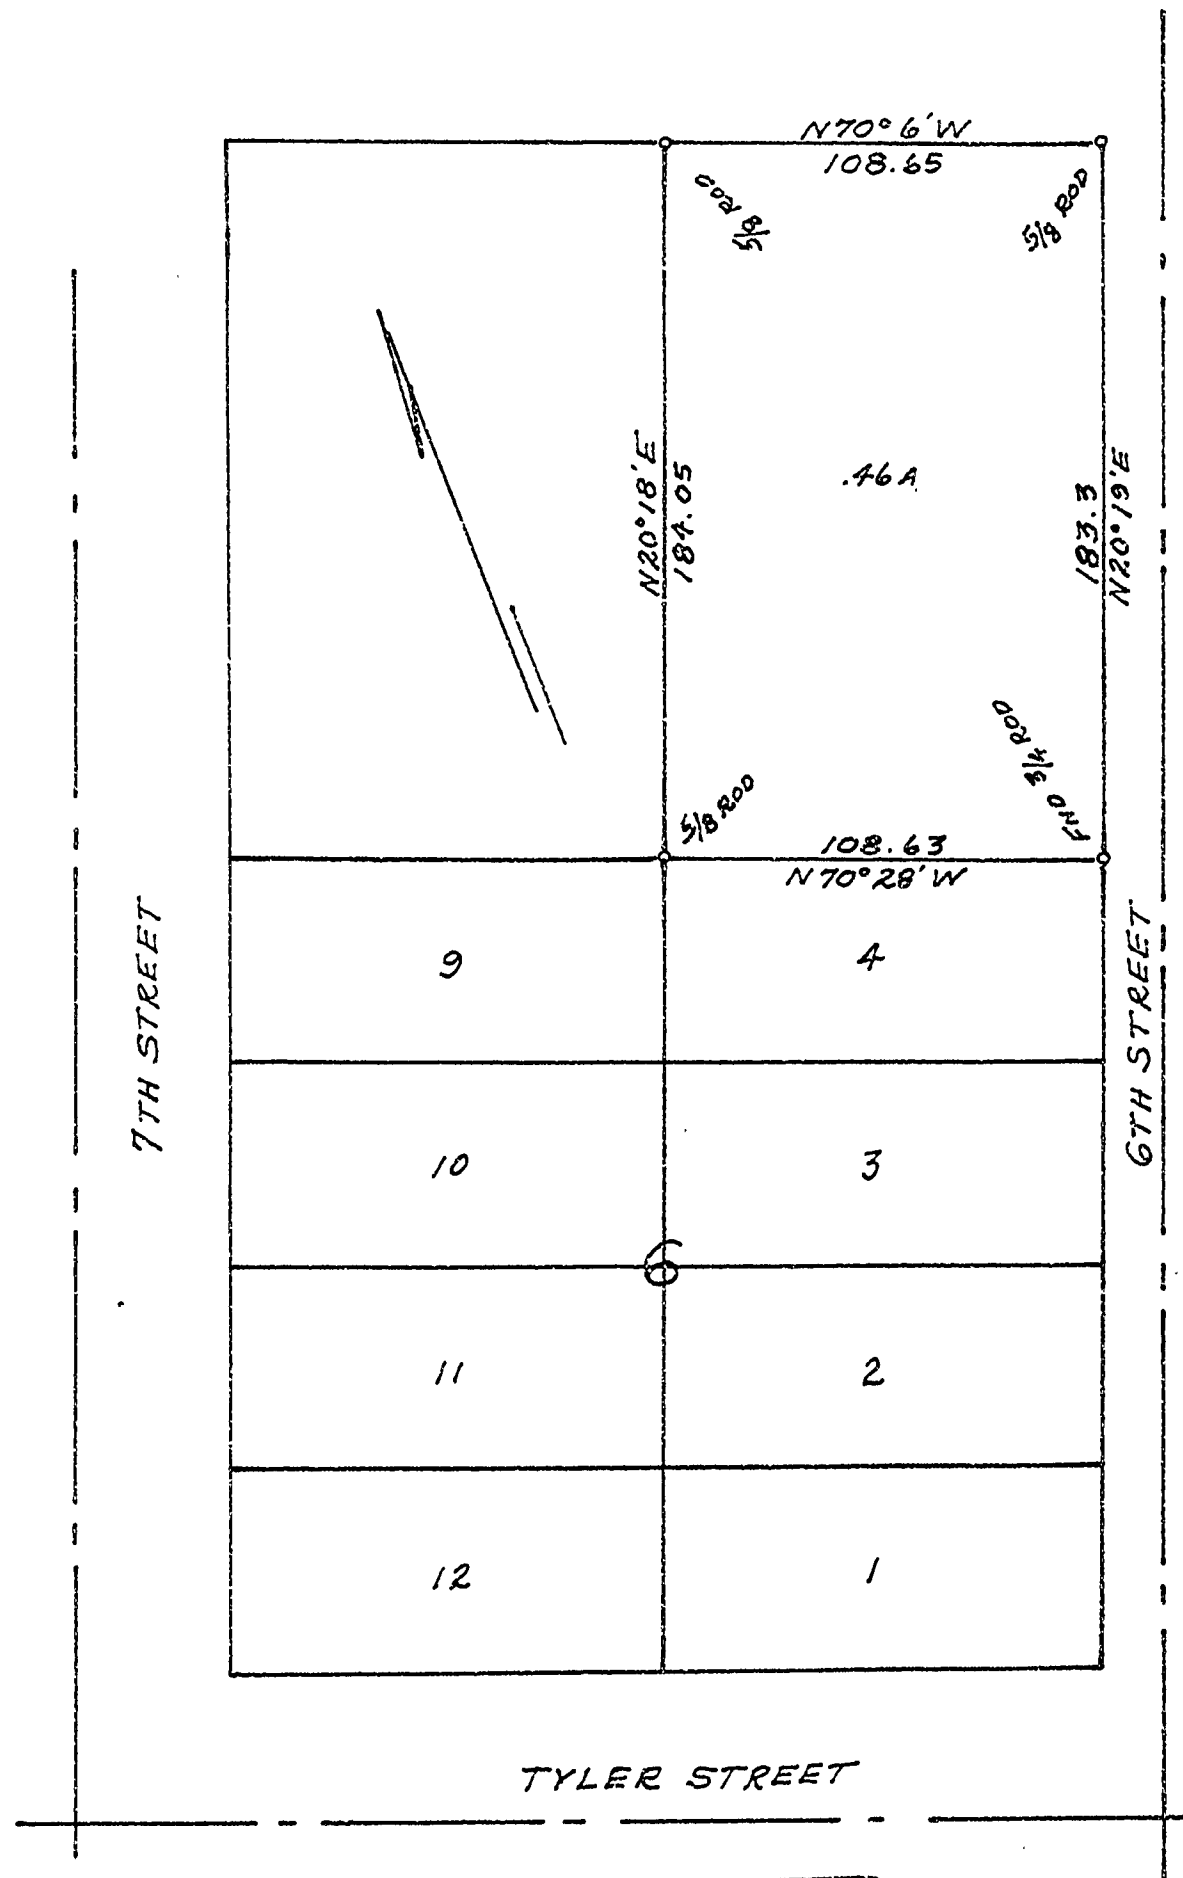

REGISTERED
OREGON
LAND SURVEYOR

R. O. Cronmiller

OCTOBER 15, 1966
RONALD O. CRONMILLER
387