

C.S. 4368

GEORGE KOUNS


NE 1/4 SEC. 3, T.11S, R.4W.

MARCH 23, 1967

BERT W. UDELL

R.P.E. 2301

SCALE 1" = 200'

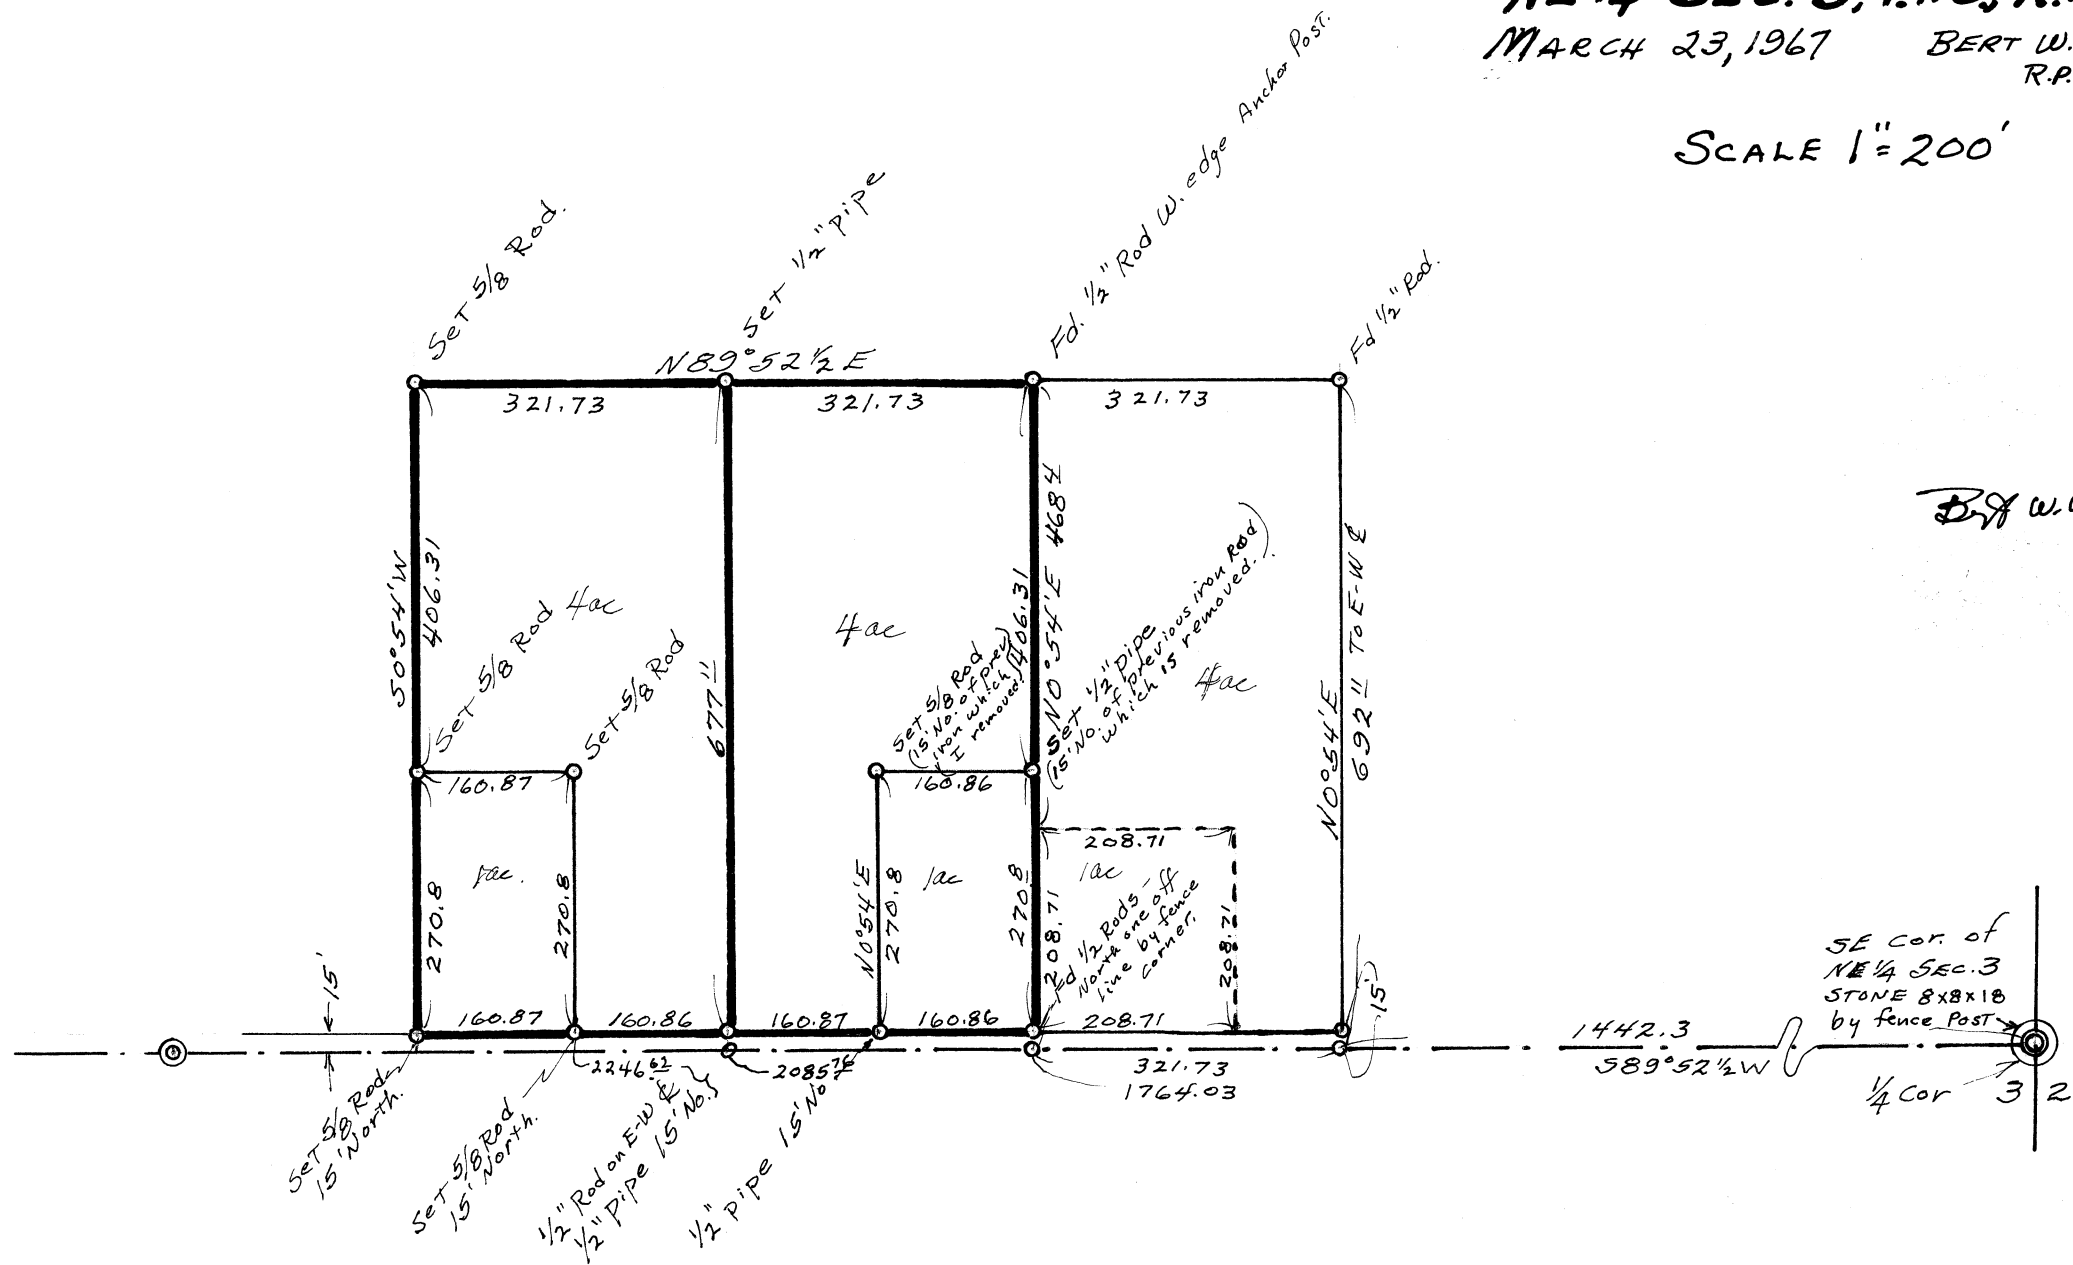

Bert W. Udell

SE Cor. of
NE 1/4 SEC. 3
STONE 8x8x18
by fence POST

1/4 Cor 3 2