


4387

SURVEY FOR
ELZIE BUCK
A WESTERLY PORTION OF BLOCK 1
SUNSET PARK ADDITION TO CITY OF PHILOMATH
PHILOMATH, OREGON
SCALE: 1" = 30' JUNE 20, 1966

- DENOTES 5/8" ROD SET
- DENOTES 3/4" PIPE FOUND

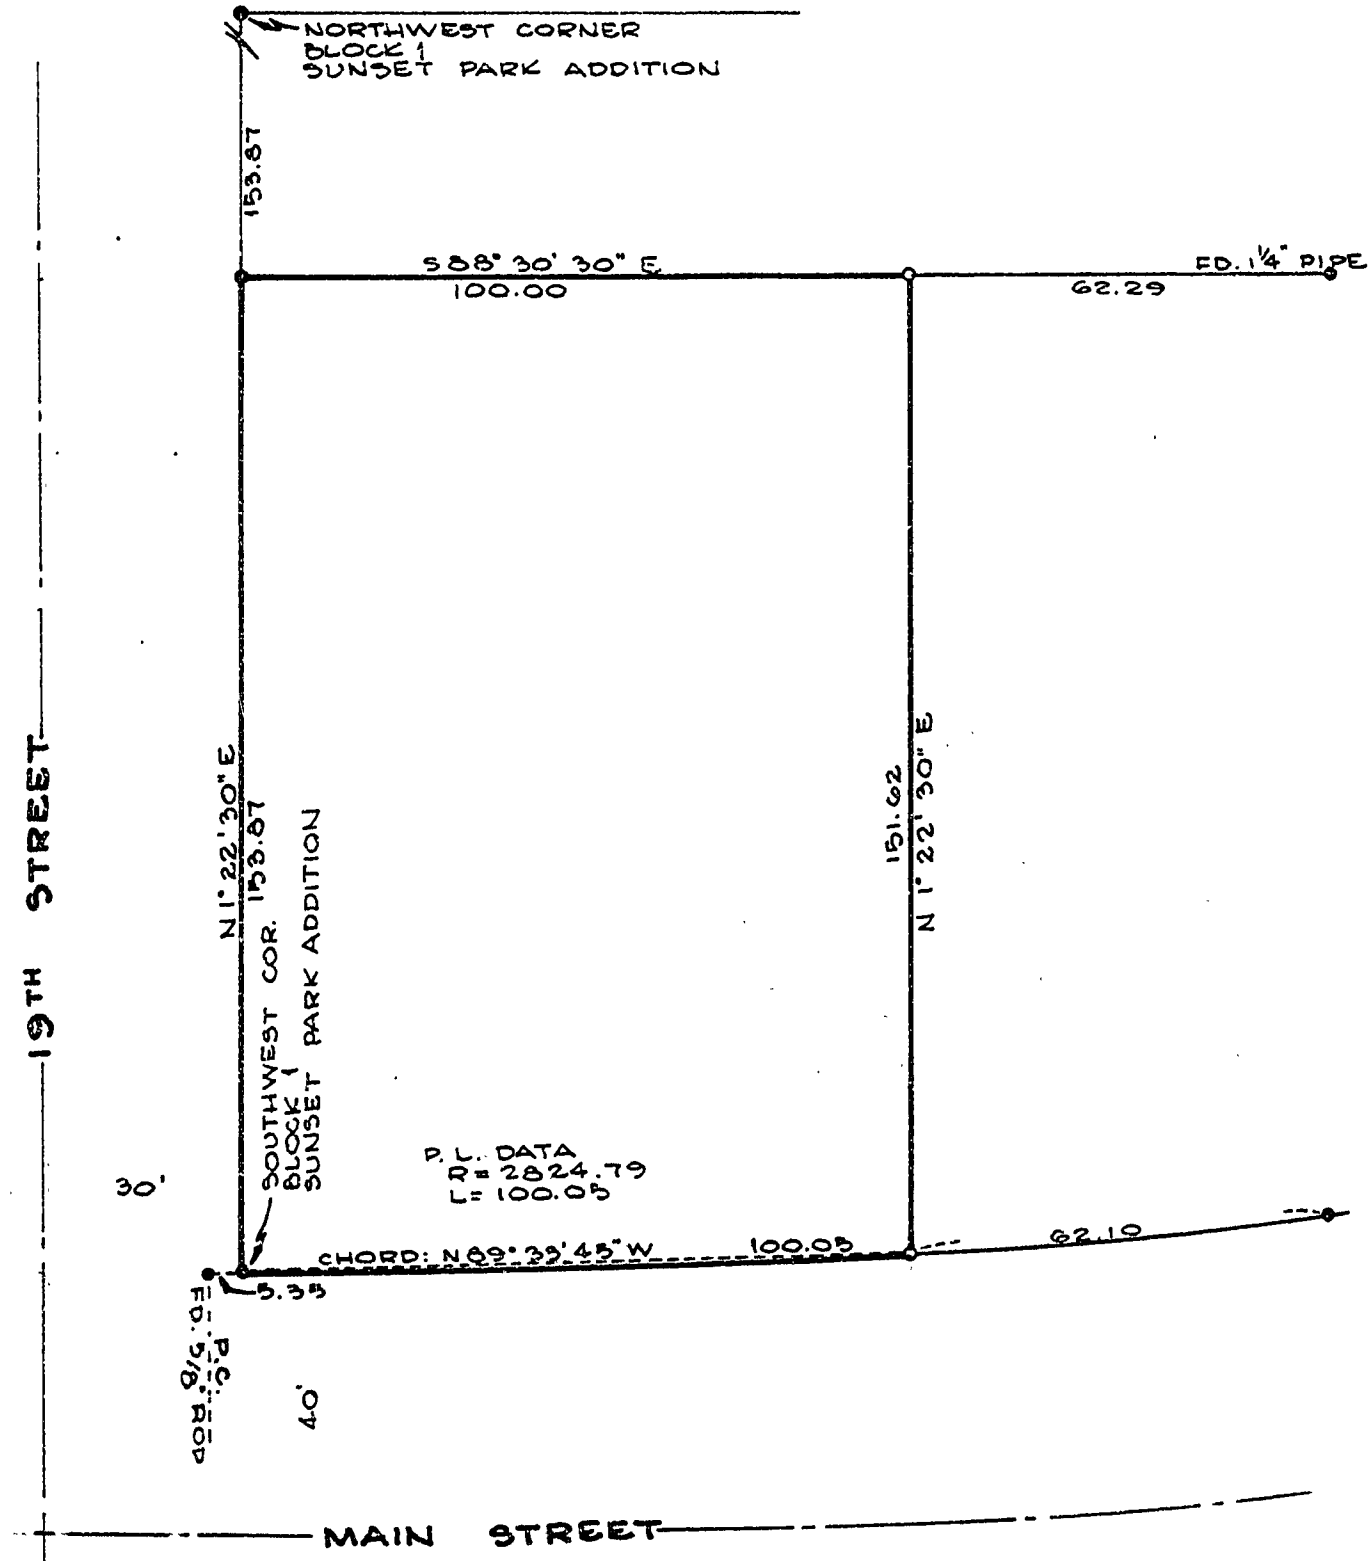

REGISTERED
OREGON
LAND SURVEYOR

Fred I. Lemke

MAY 2, 1958
FRED I. LEMKE
443