

C.S. 4396

FRANCES V GELLATLY



ELIJAH LIGGETTS DLC No 52, T 12 S, R 5 W

Scale 1" = 5 chains

MAY 15 1967

BERT W. UDELL RPE# 2307

By Ralph D. Wilkinson RPE# 3759

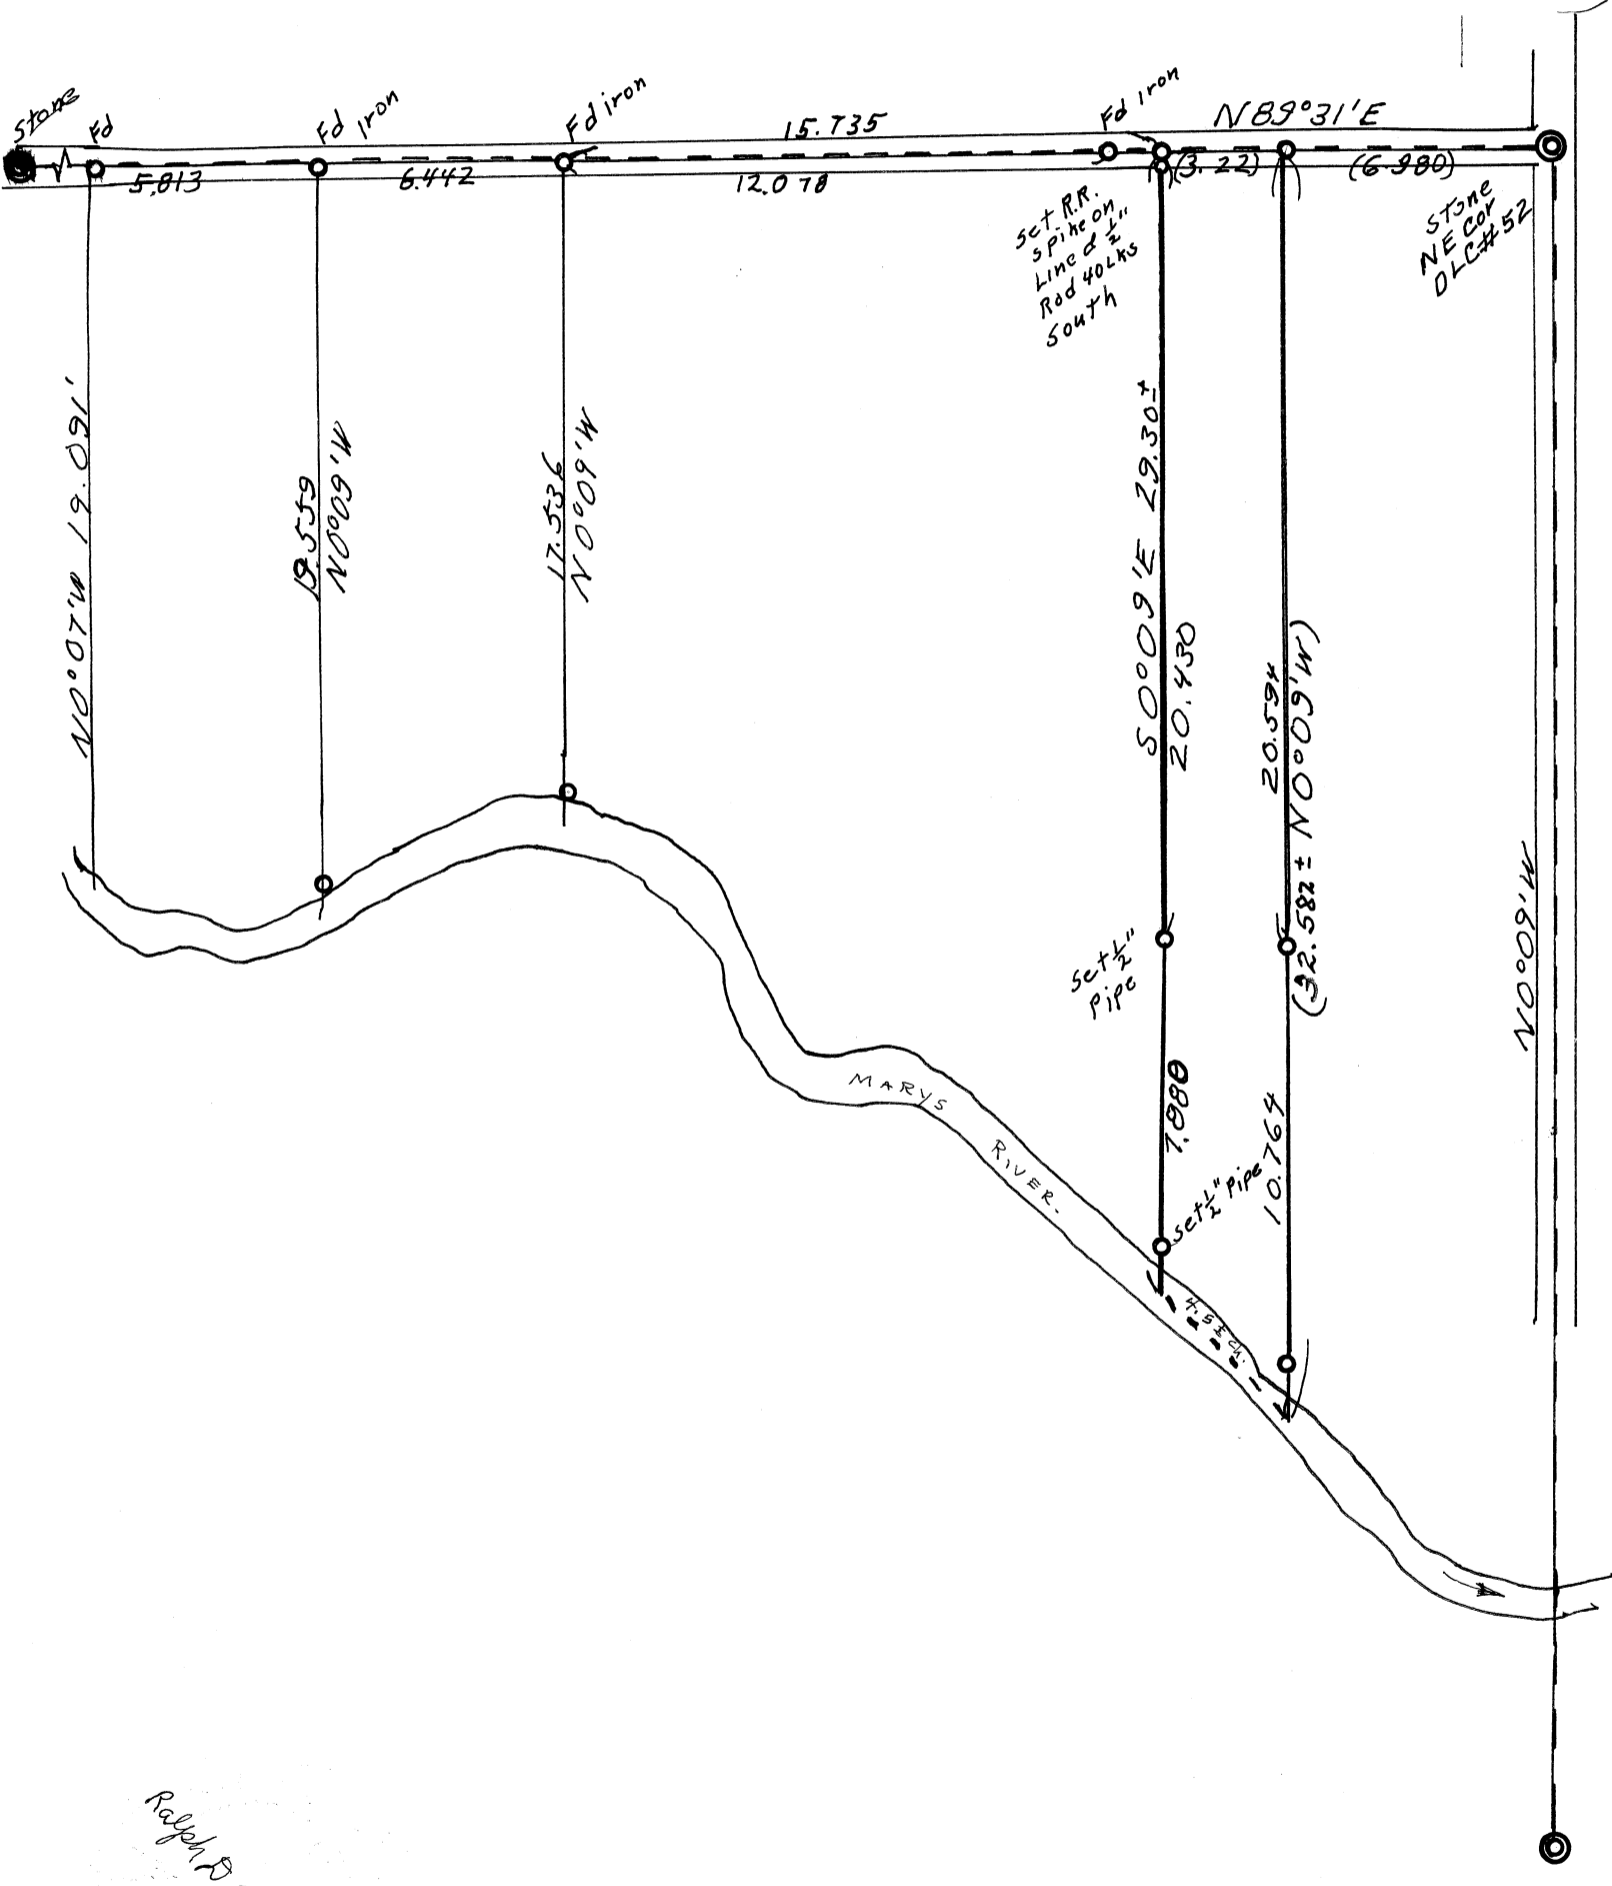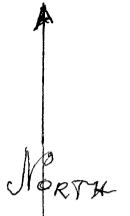

Ralph D. Wilkinson