


4412

SURVEY for Fred J. Grediagin in  
Norrice P. Newton D.L.C. No. 72, T. 12 S., R. 5 W.,  
Willamette Meridian, Benton County, Oregon

Southeast Cor.  
N.P. NEWTON  
D.L.C. No. 72

Scale: 1" = 50'

June 20, 1967

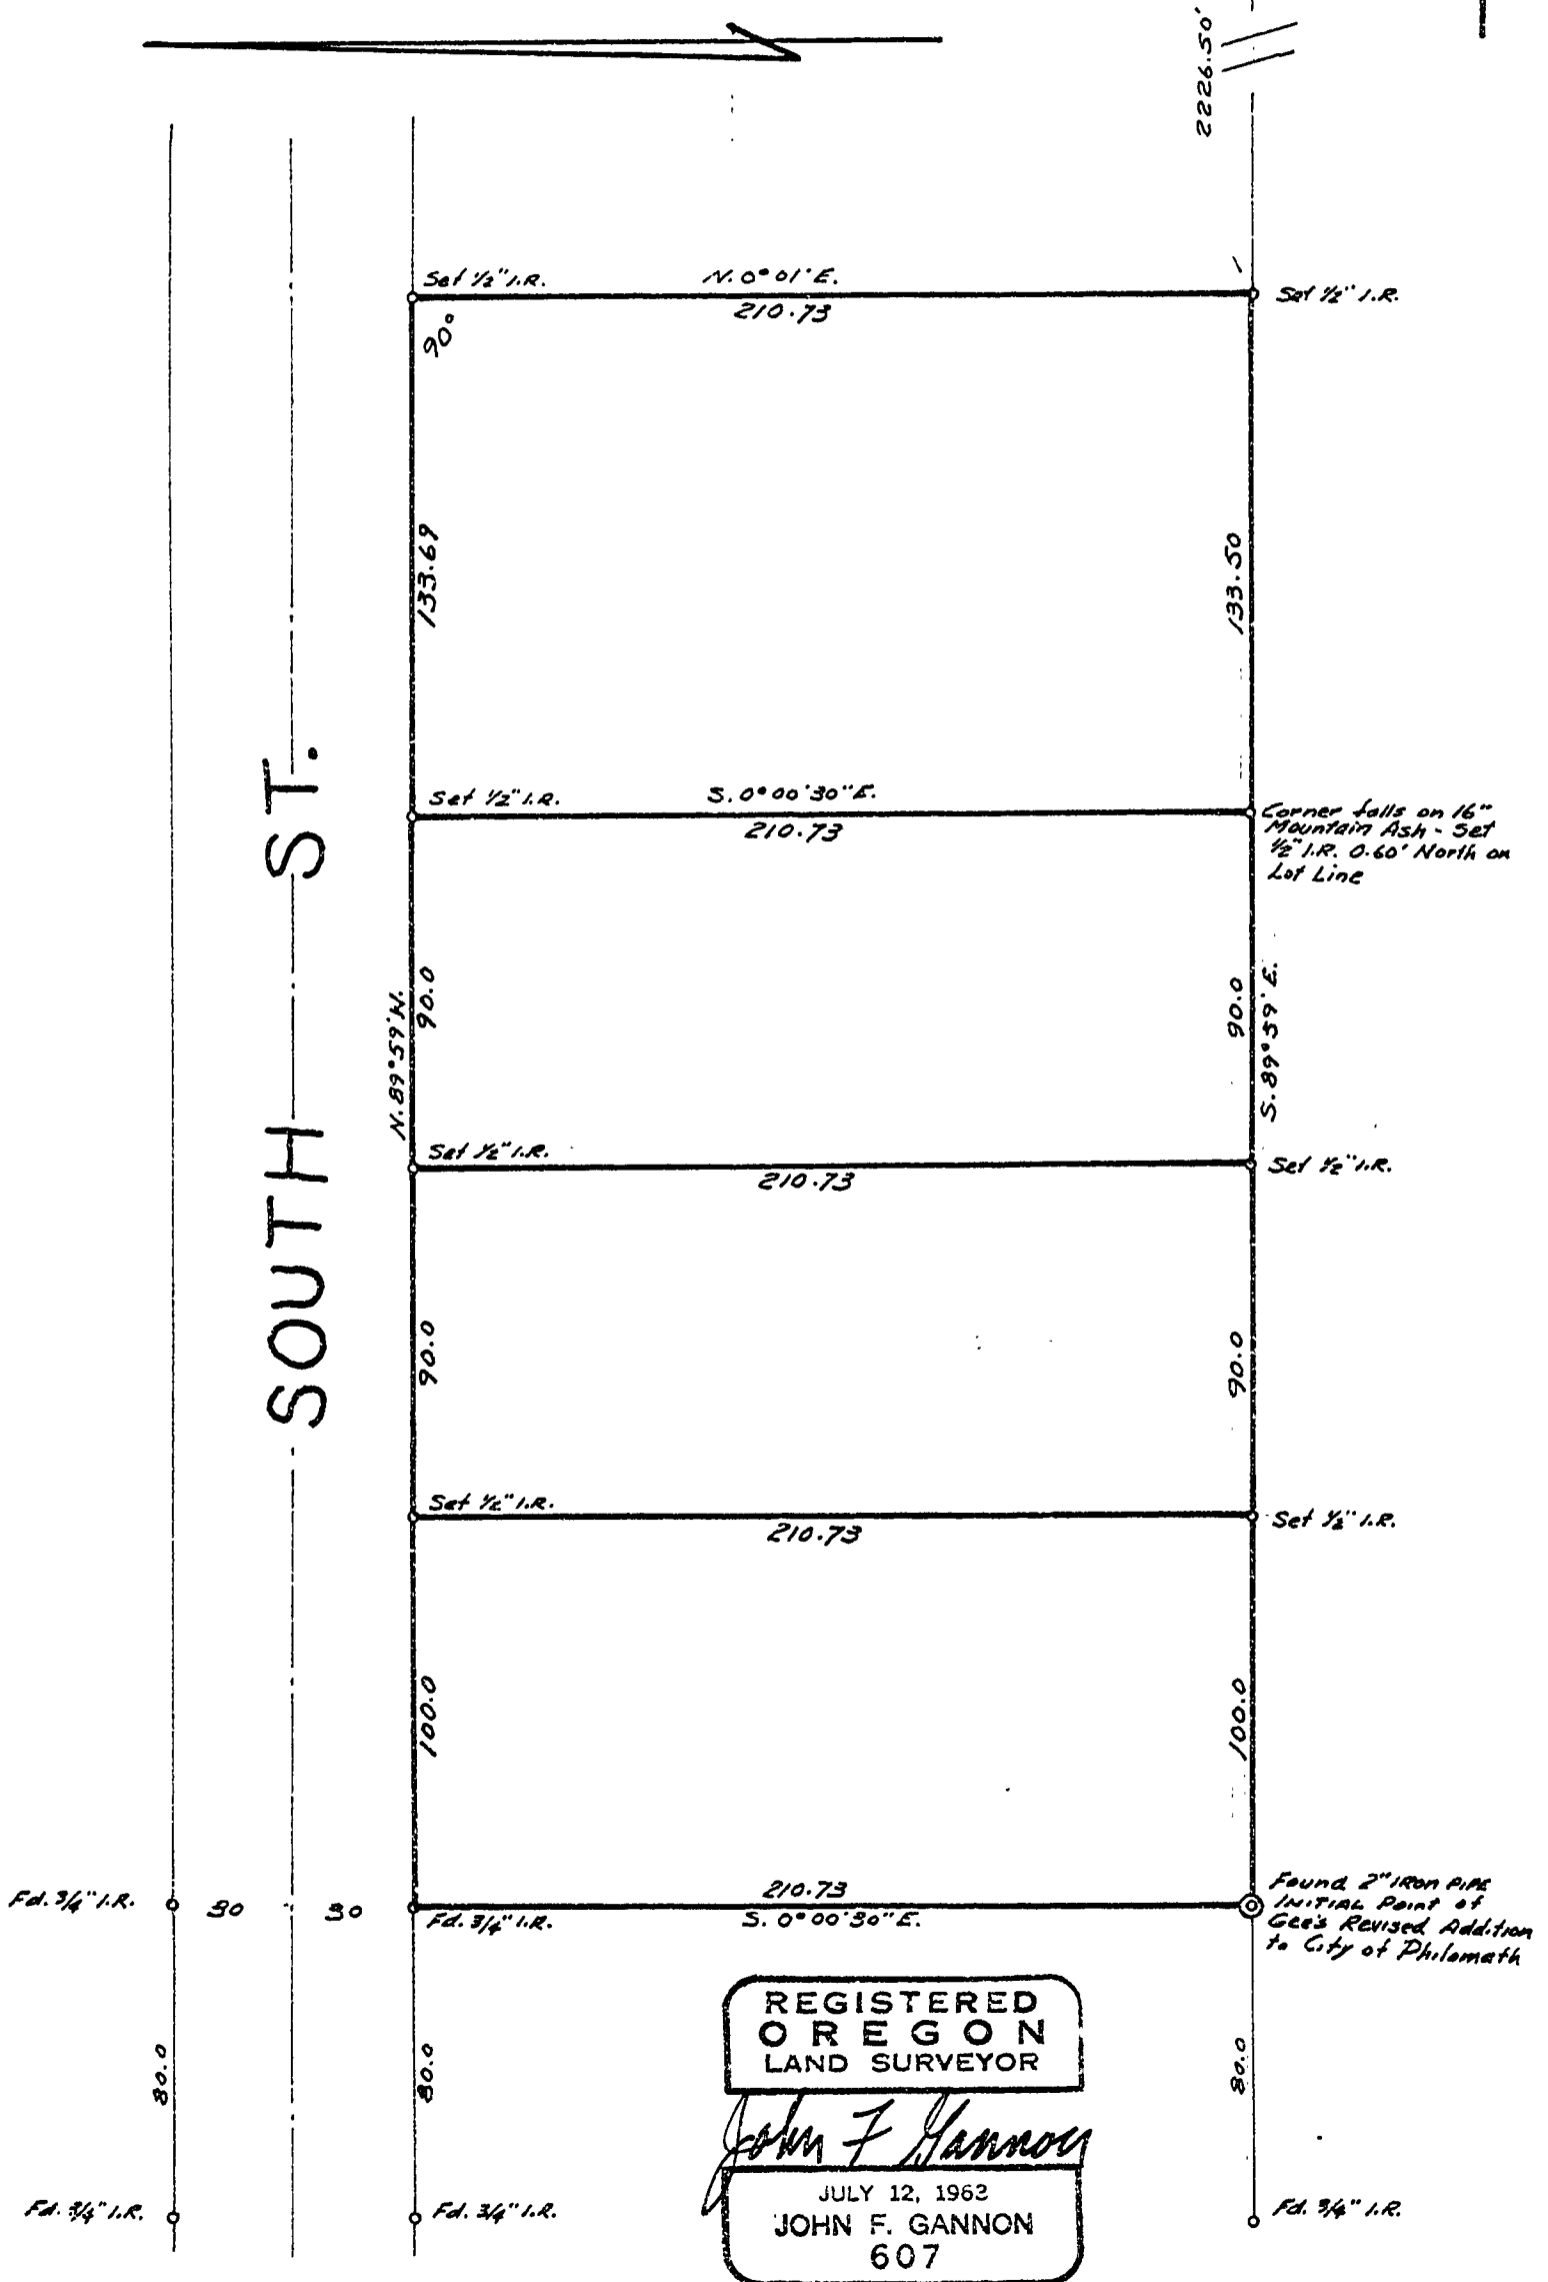

REGISTERED  
OREGON  
LAND SURVEYOR

*John F. Gannon*

JULY 12, 1962  
JOHN F. GANNON  
607