

C 5 4500

RECORD OF SURVEY
FOR
E.C. BARHAM


PART OF LOTS B9 & B10
ANDERSON COLONY ORCHARDS
BENTON COUNTY OREGON

SCALE 1" = 200'
FEBRUARY 15, 1967

Bearing based on south line of Lots B6 & B8

REGISTERED
OREGON
LAND SURVEYOR

Richard W. Fail
NOV 4 1955
RICHARD W. FAIL
357

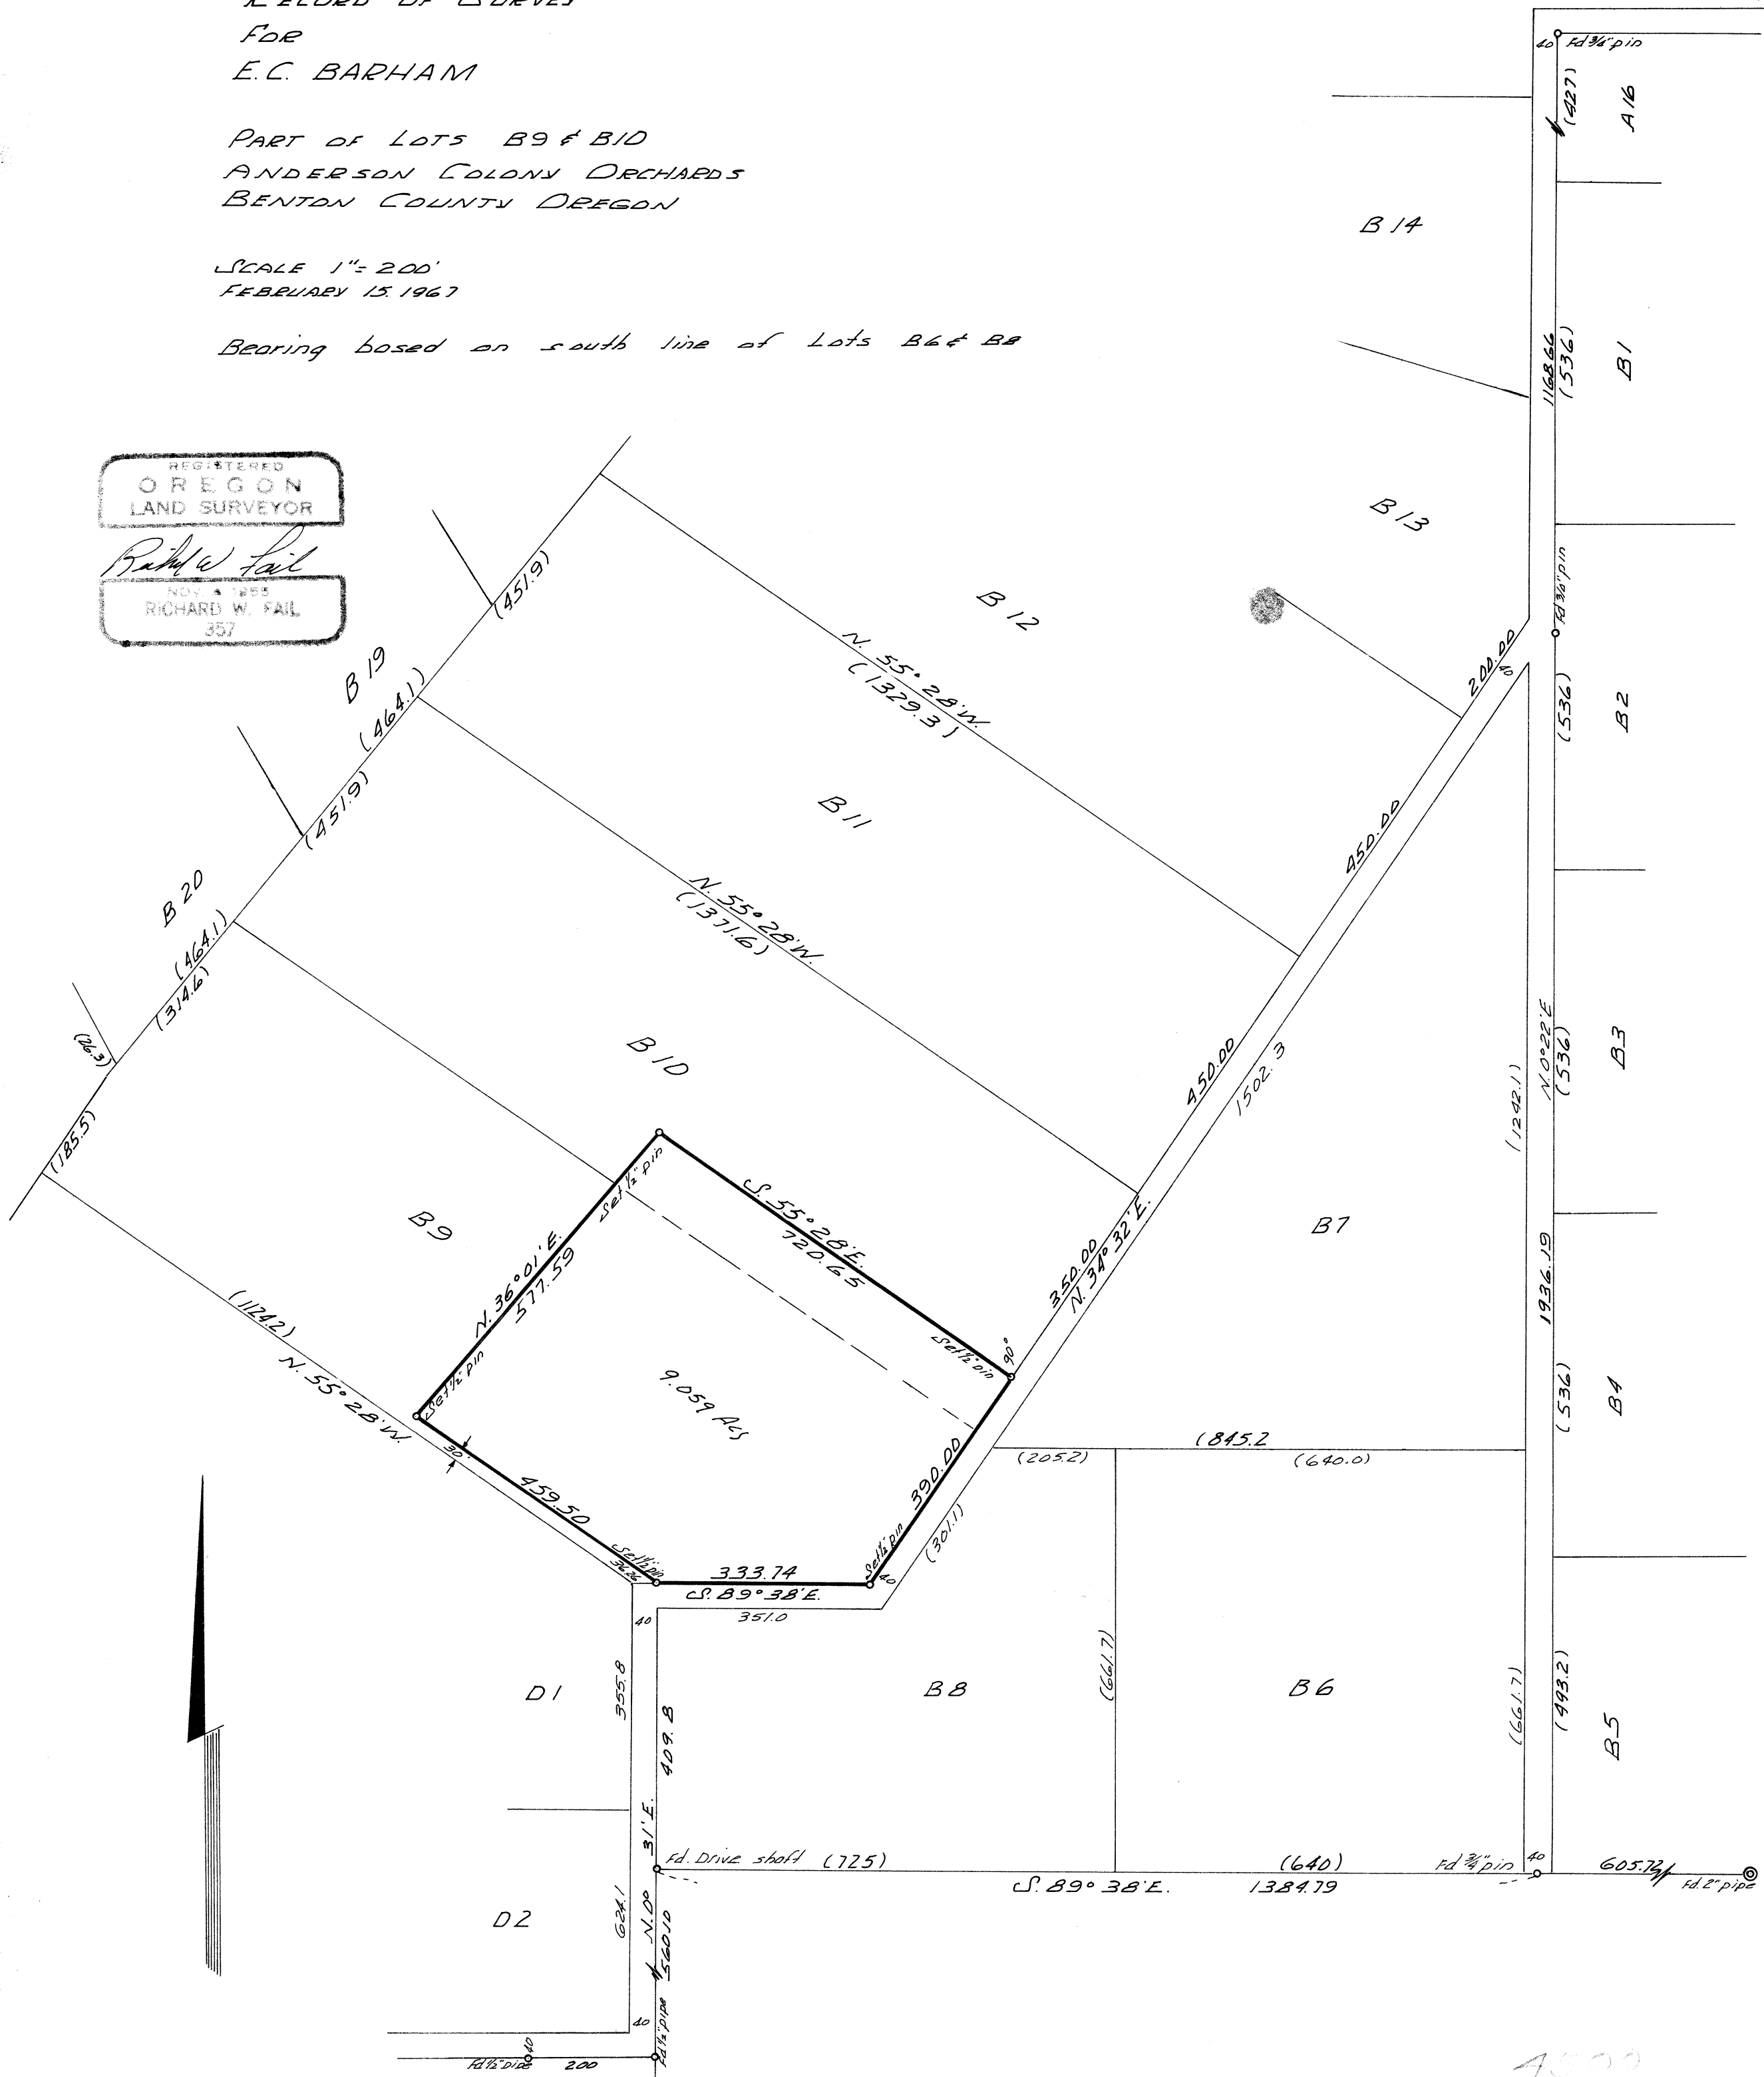

4500