

C.S. 4551
PROPERTY SURVEY


for

FRANK NORDYKE

IN THE JOHN GRIMSLEY D.L.C. No. 52
T 12 S, R 6 W, WM.

SCALE: 1" = 50' REF. CS No. 3982

○ DENOTES 5/8" STEEL ROD SET
● DENOTES 1/2" STEEL ROD FD.

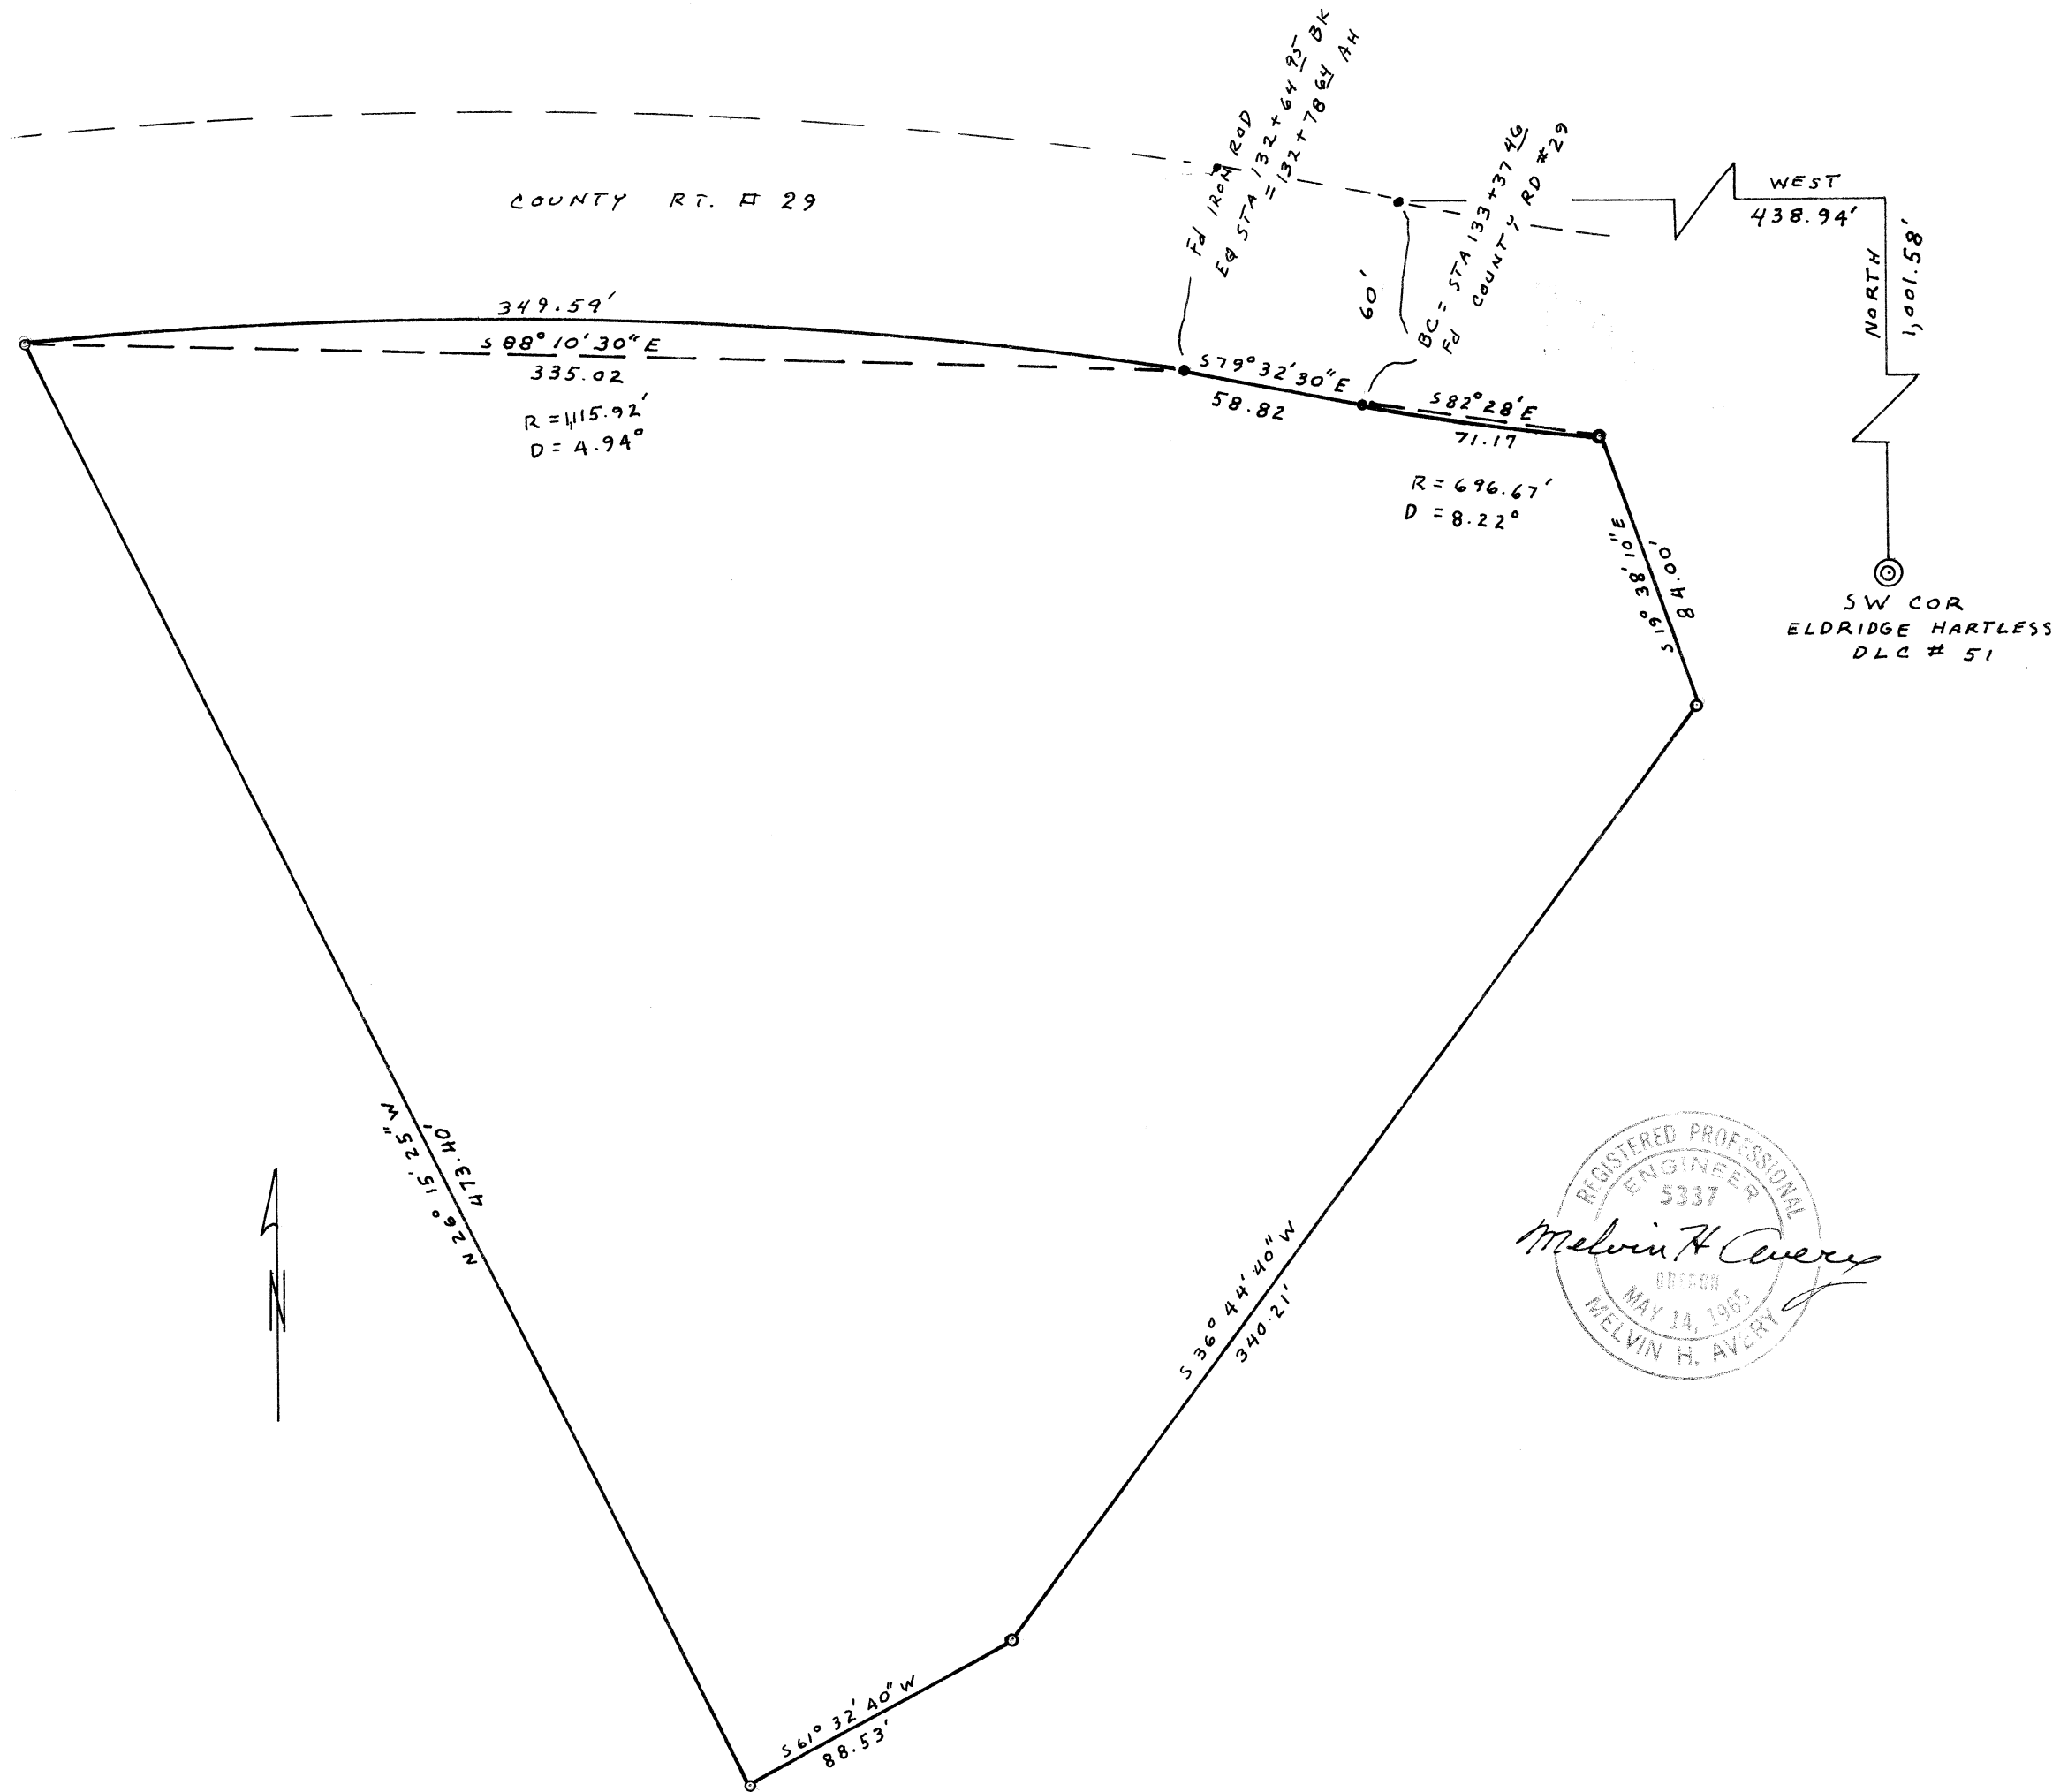

4551