


NE CORNER ARCHIMEDES STEWART DLC N^o 46 & 51
End stone

DEED REFERENCE
Vol. 112 PAGE 186
Vol. 192 PAGE 192 To State Ore.
REEL M N^o 2718 To Benton Co.

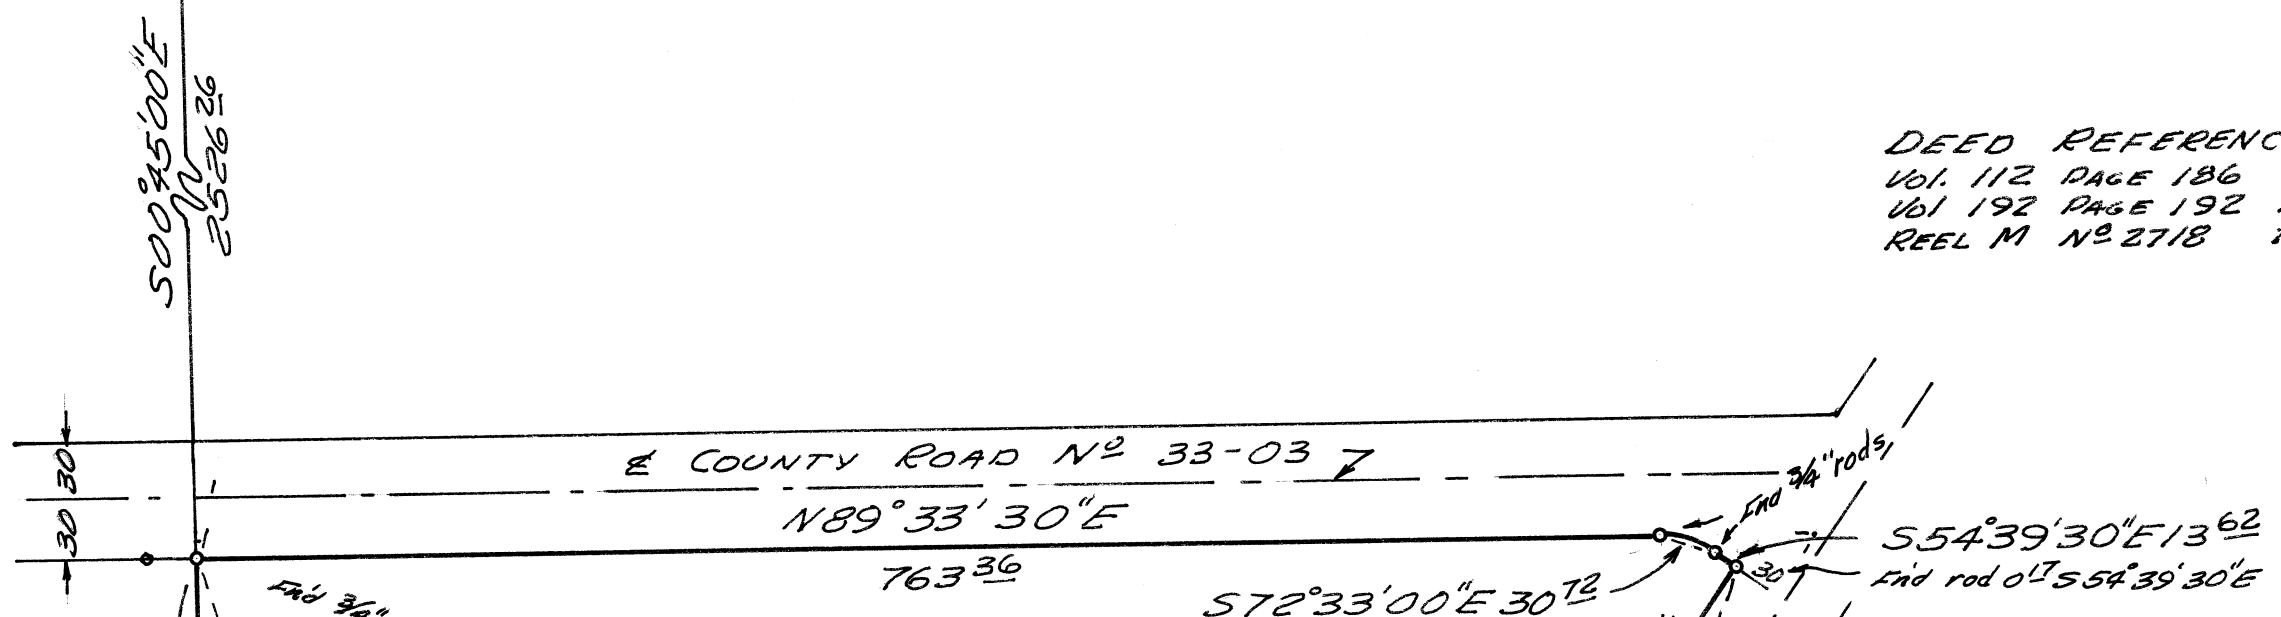


$\Delta 35^{\circ}47'$
R 50.88
L 31.23
LC 30.72

$\Delta 2^{\circ}49'34''$
R 719.22
L 354.72
LC 354.71

$\Delta 10^{\circ}47'$
D 00.48' CLT
R 716.97
ST 675.95
L 1347.9
LC 1345.93

118 \pm ACRES
FAIRPLAY PROPERTY

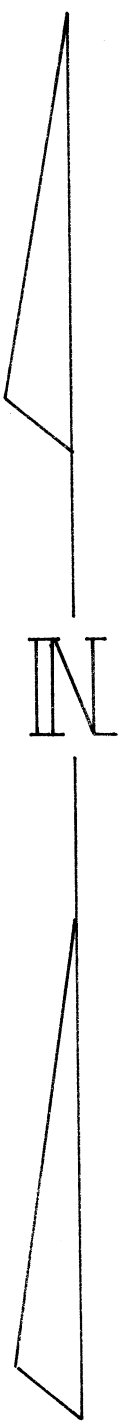

WEST LINE JAMES H STEWART DLC N^o 49
120912

138212 N 00°45'00\"/>

ALBANY-CORVALLIS STATE HIGHWAY N^o 20
S 26°05'37\"/>
S 26°31'45\"/>
504.91
548.82
179.65
172.45

C.S. 4559
SURVEY FOR OREGON AGRICULTURAL EXPERIMENT STATION
SECTION 19 T11S, R4W, W.M.

EIMSTAD & ASSOCIATES
1717 WASHINGTON ST. EUGENE
MARCH, 1968
SCALE
1 INCH = 100 FEET

REGISTERED
OREGON
LAND SURVEYOR
William A. Eimstad
MAY 4, 1950
WILLIAM A. EIMSTAD
377

4559