


c.s. 4603

Survey for C.R. and Helen McDonald in  
Lots 2, 3, 4 and 5, Block 2, Country Club Heights, 2nd Add.,  
Benton County, Oregon

Scale: 1" = 30'  
July 19, 1963

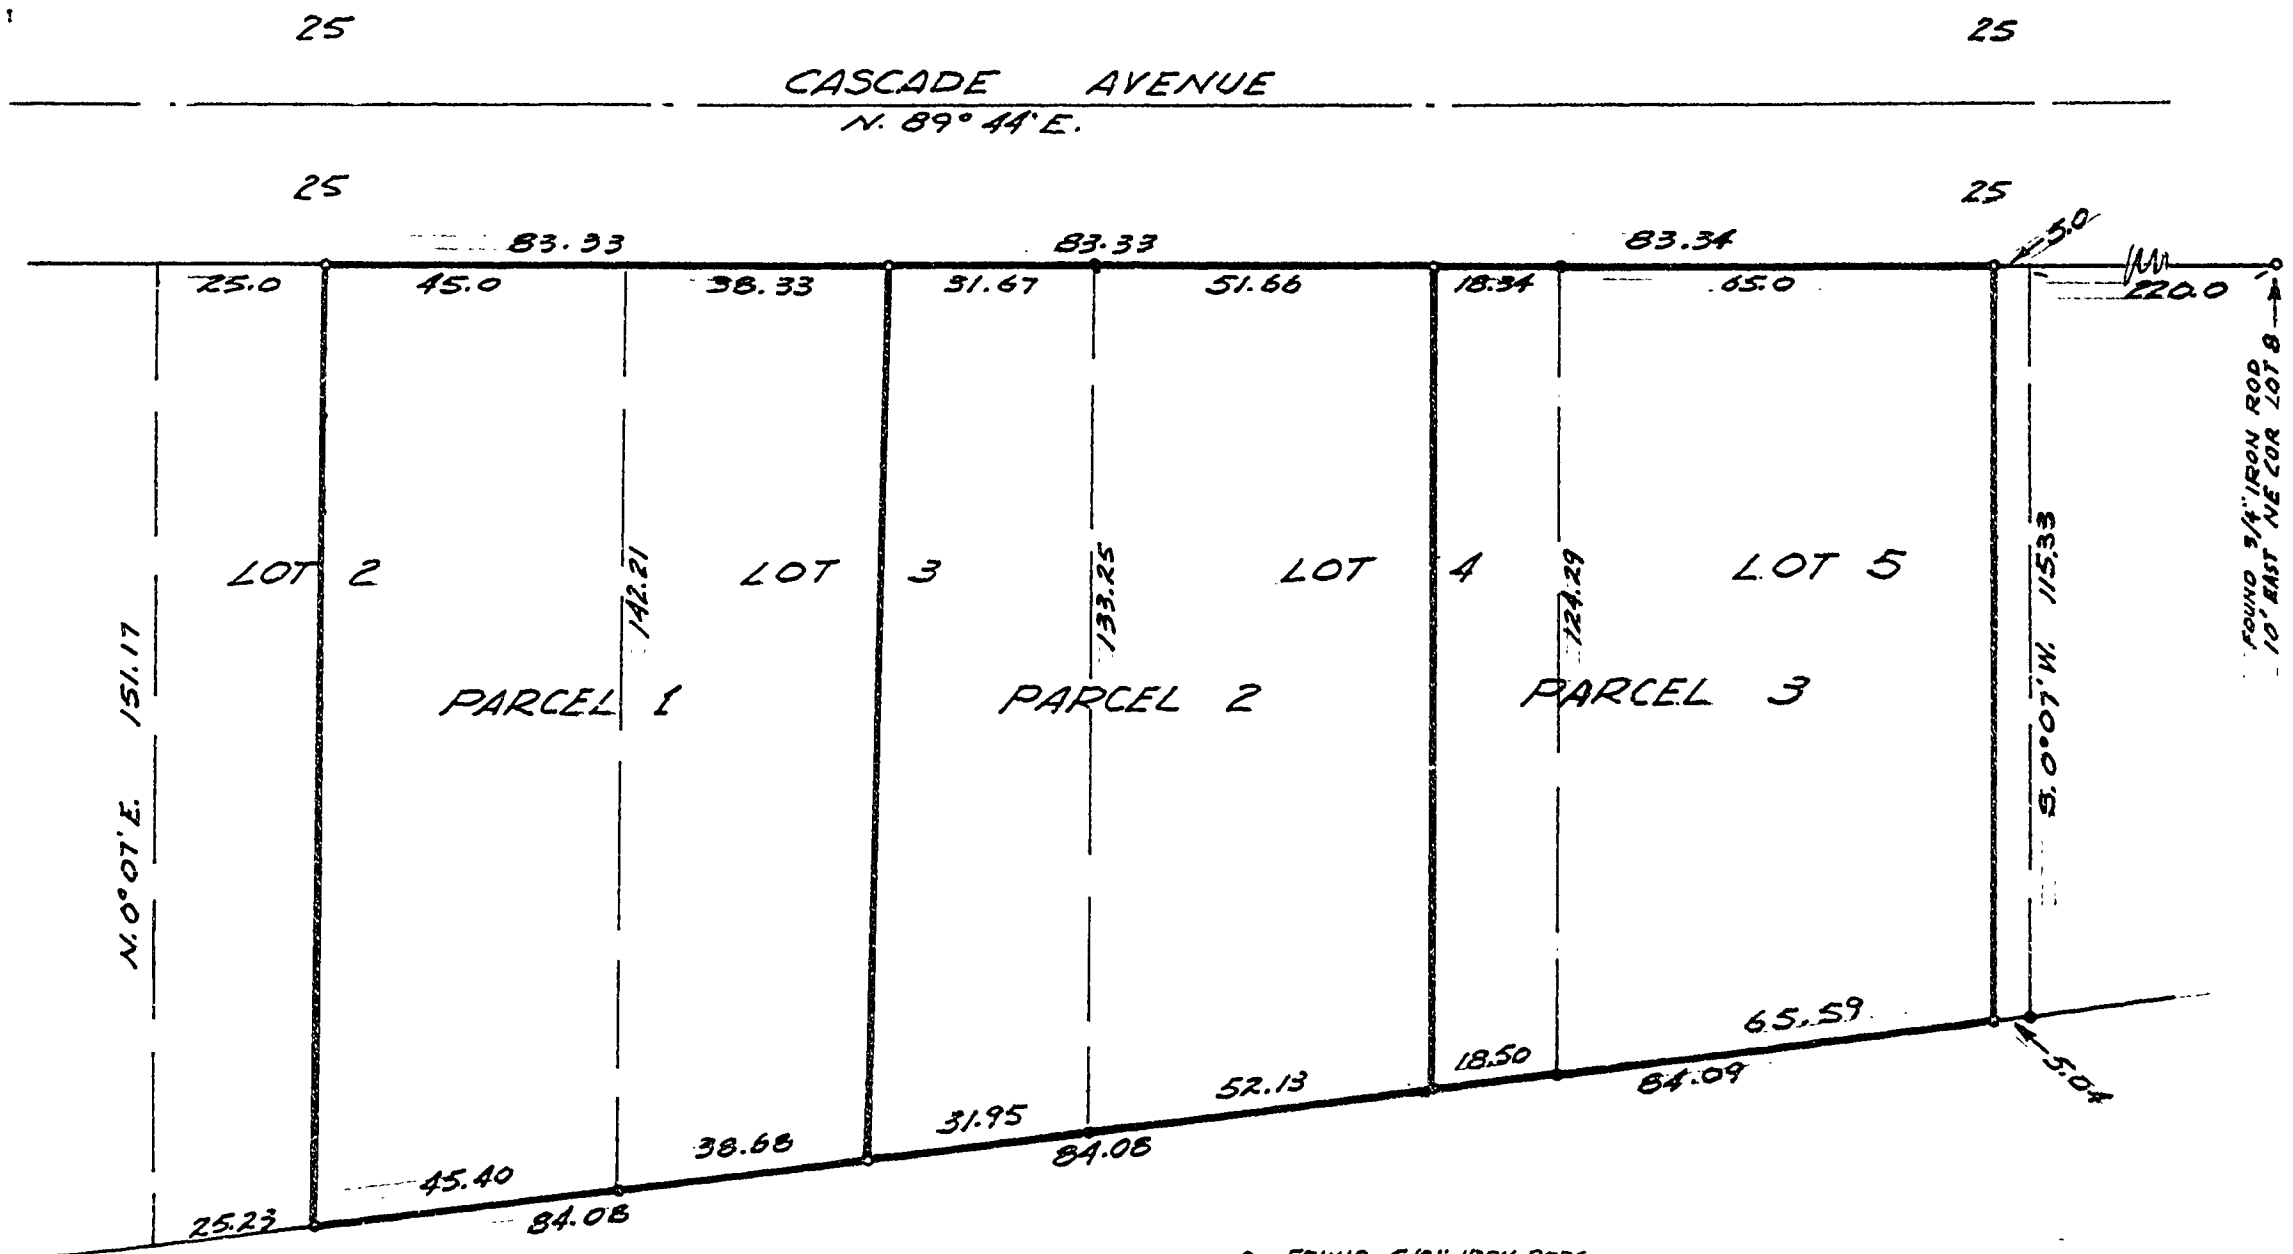

REGISTERED  
OREGON  
LAND SURVEYOR

*John F. Gannon*

JULY 12, 1963  
JOHN F. GANNON  
607

● FOUND 5/8" IRON RODS  
○ SET 5/8" IRON RODS  
BEARINGS, DISTANCES BASED ON COUNTRY CLUB HEIGHTS, 2nd Add.