


4629

SURVEY FOR
WILLAMETTE INDUSTRIES INC.

DALLAS, OREGON


in
SEC. 8, T. 15 S., R. 7 W., W. M.
BENTON COUNTY, ORE.

JULY 1968

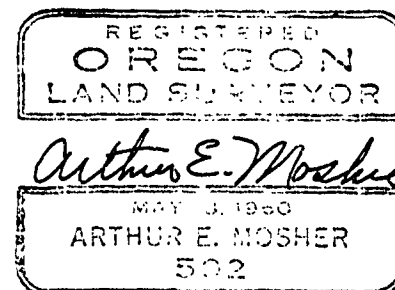

Scale: 1" = 1000'
Brgs. 1940 survey

- Cor. set
- Cor. of record 1940 G.L.O. Brass cap

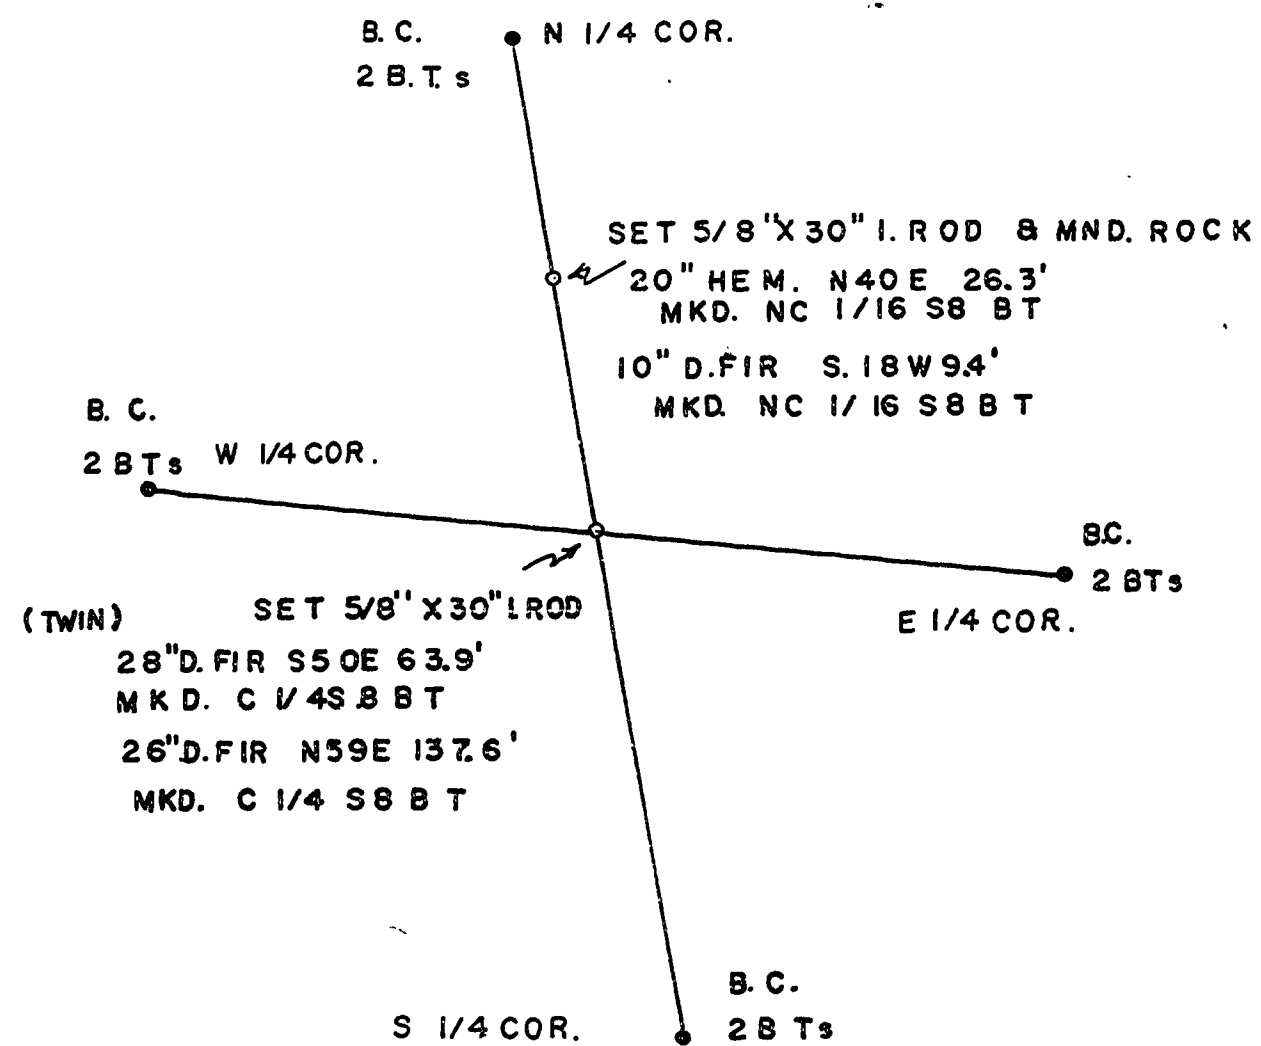

CS 4629

Willamette Industries, Inc.

Dallas Division

September 9, 1987

RECEIVED BY _____

SEP 10 1987

PUBLIC WORKS DEPT



P.O. Box 488
Dallas, Oregon 97338
503/623-2351

Benton County Surveyor
Benton County Courthouse
Corvallis, Oregon 97330

Attention: Pete McDowell

Thank you for seeking verification of bearings and distances associated with CS #4629 in Section 8, Township 15 South, Range 7 West. Our office copies of this survey (copy attached) show bearings and distances which match the office work map and calculation sheets.

If you have any questions, please call.

Gary Johnston
Logging Engineer

GJ/jd
Enclosure

CS 4629

WILLAMETTE INDUSTRIES INC.

DALLAS, OREGON

in

SEC. 8, T. 15 S., R. 7 W., W. M.

BENTON COUNTY, ORE.

JULY 1968

REGISTERED
OREGON
LAND SURVEYOR

Arthur E. Mosher

MAY 13, 1960
ARTHUR E. MOSHER
502



Scale: 1" = 1000
Brgs. 1940 survey

- o Cor. sot
- o Cor. of record 1940 G.L.O. Brass cap

