


4635

4635

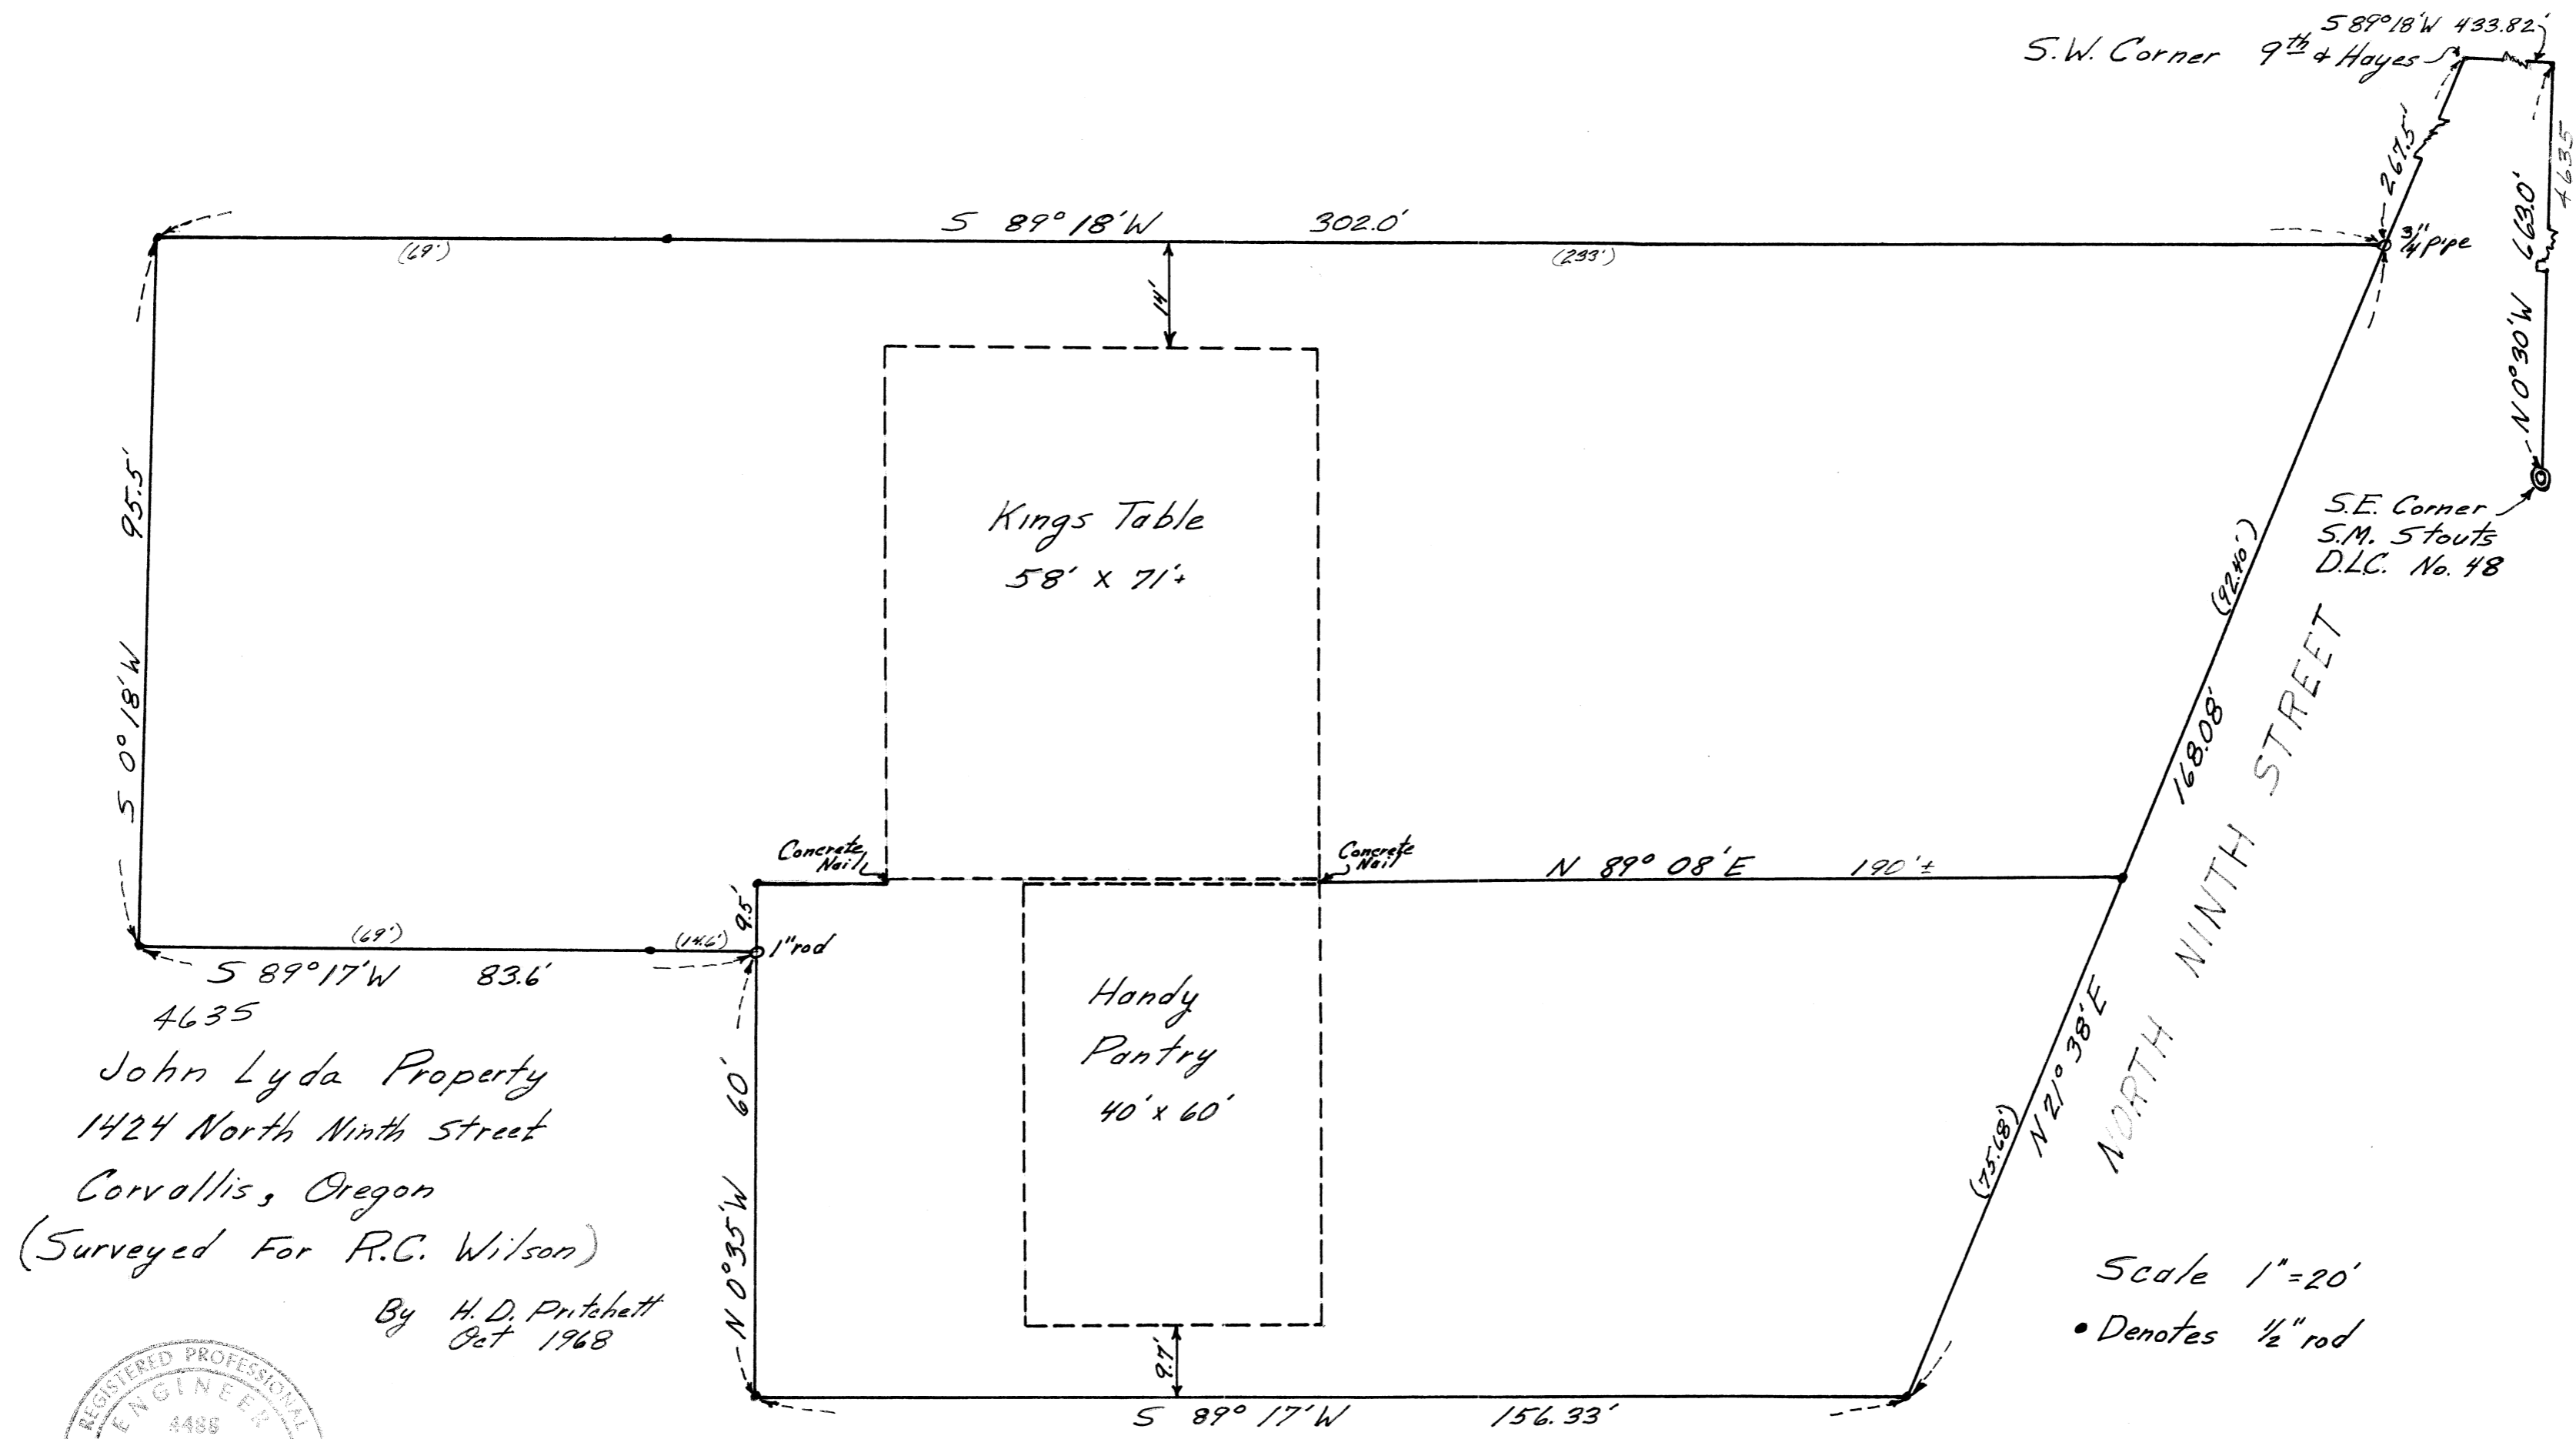

4635  
 John Lyda Property  
 1424 North Ninth Street  
 Corvallis, Oregon  
 (Surveyed For R.C. Wilson)

By H. D. Pritchett  
 Oct 1968

Scale 1" = 20'  
 • Denotes 1/2" rod

