


4647

LORETTA G. FOLTZ

WAYMAN ST. CLAIR D.L.C. No. 47
T. 12 S., R. 6 W., W.B. & M.

Scale 1" = 100'

Sept. 23, 1968

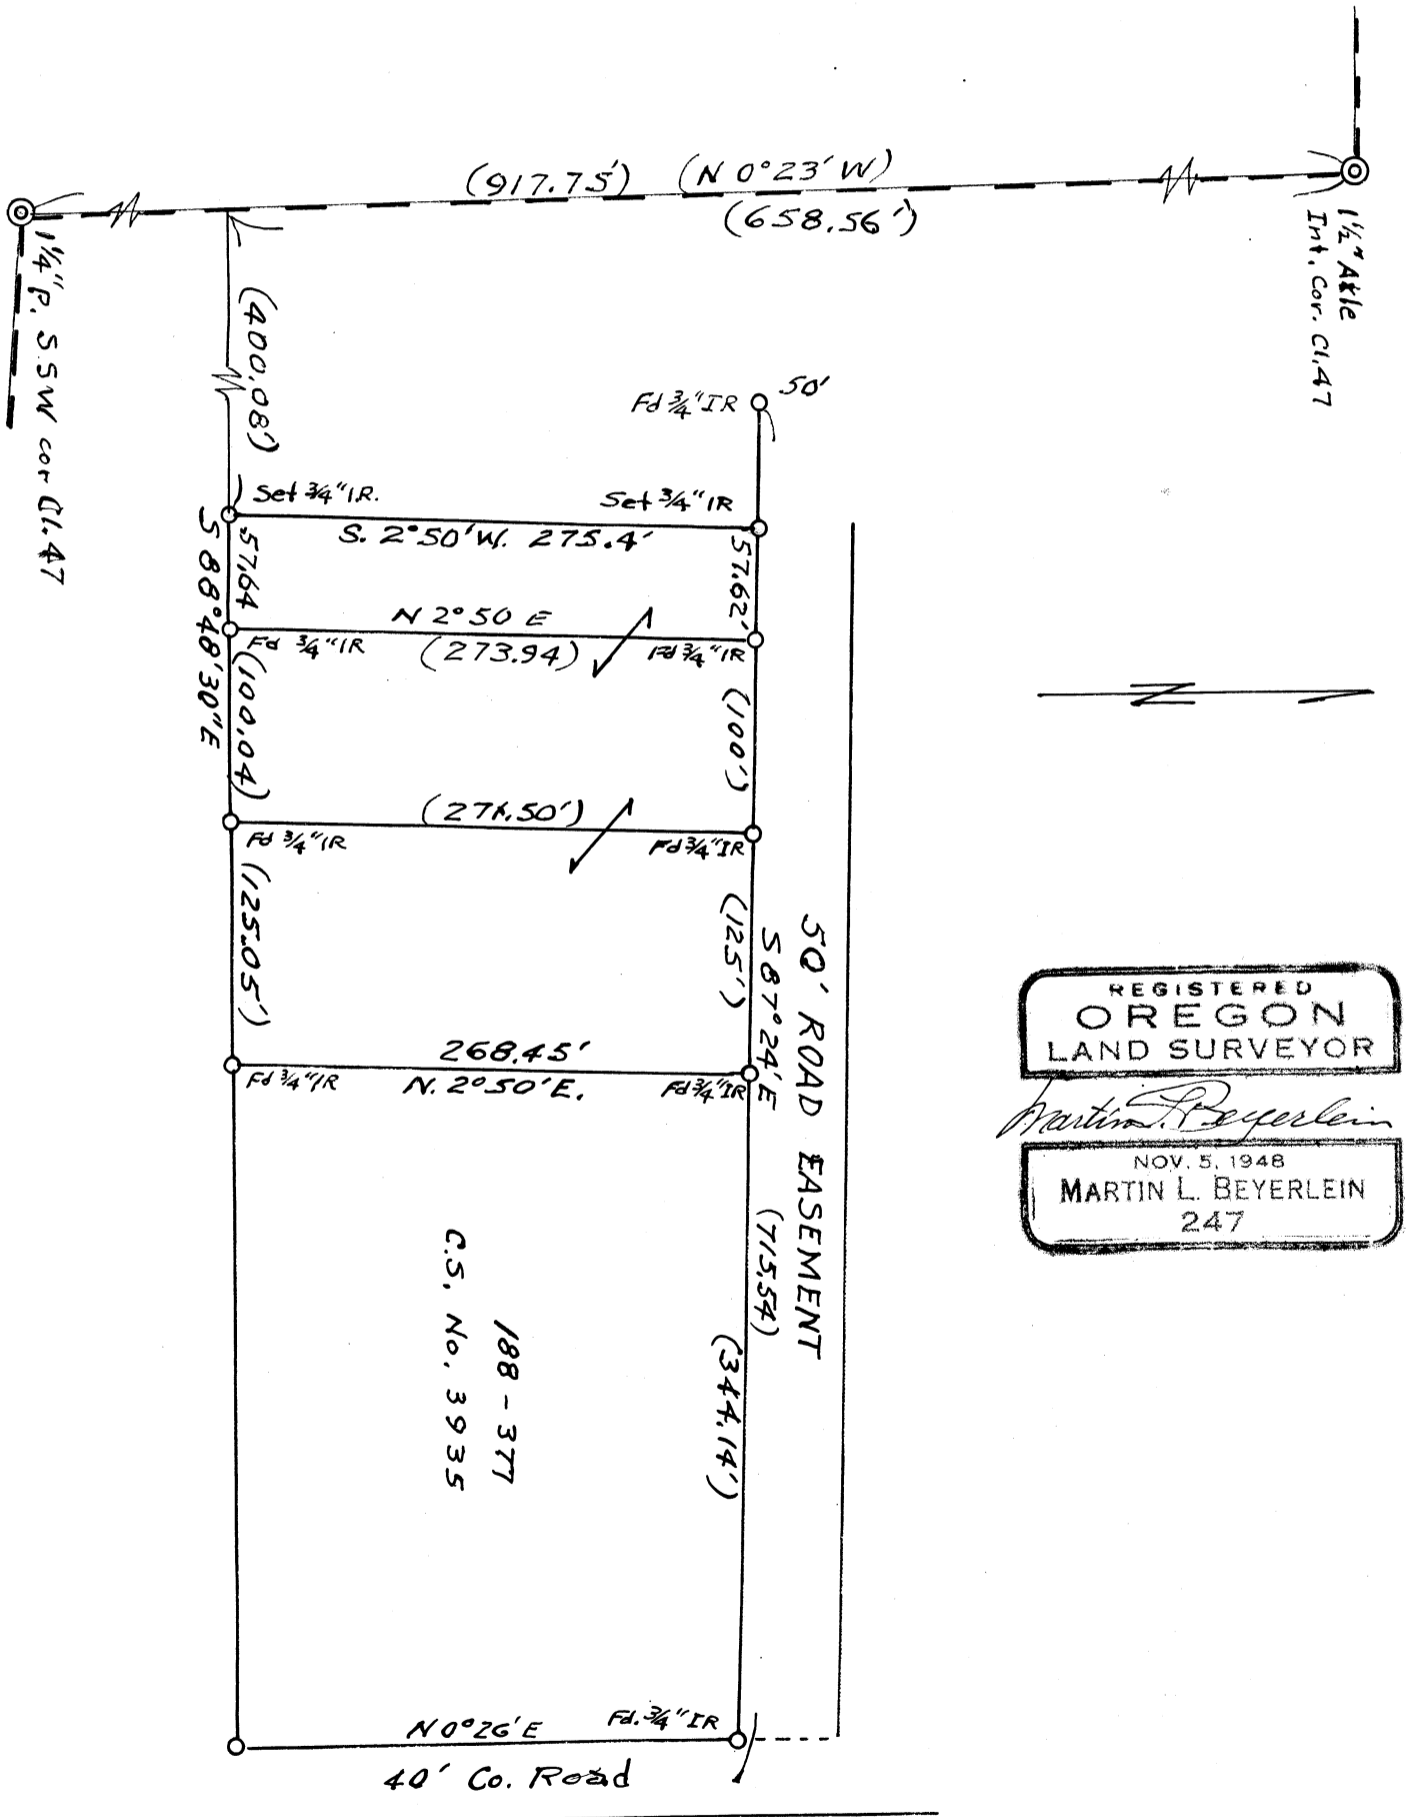

REGISTERED
OREGON
LAND SURVEYOR

Martin L. Beyerlein

NOV. 5, 1948
MARTIN L. BEYERLEIN
247