

4741

4741

4741
Record of Survey


for
E. JACKSON et ux
in
D.L.C. No. 48, T. 13S., R. 5 W., W. B. M.
Benton County, Oregon

Scale: 1" = 100' April 21, 1969

○ Denotes 5/8" rod set

REGISTERED
OREGON
LAND SURVEYOR
Nickolas A. Yinger
JULY 14, 1958
NICKOLAS A. YINGER
876

SE Corner
I. W. Winkle
D.L.C. No. 47
Fd. Stone

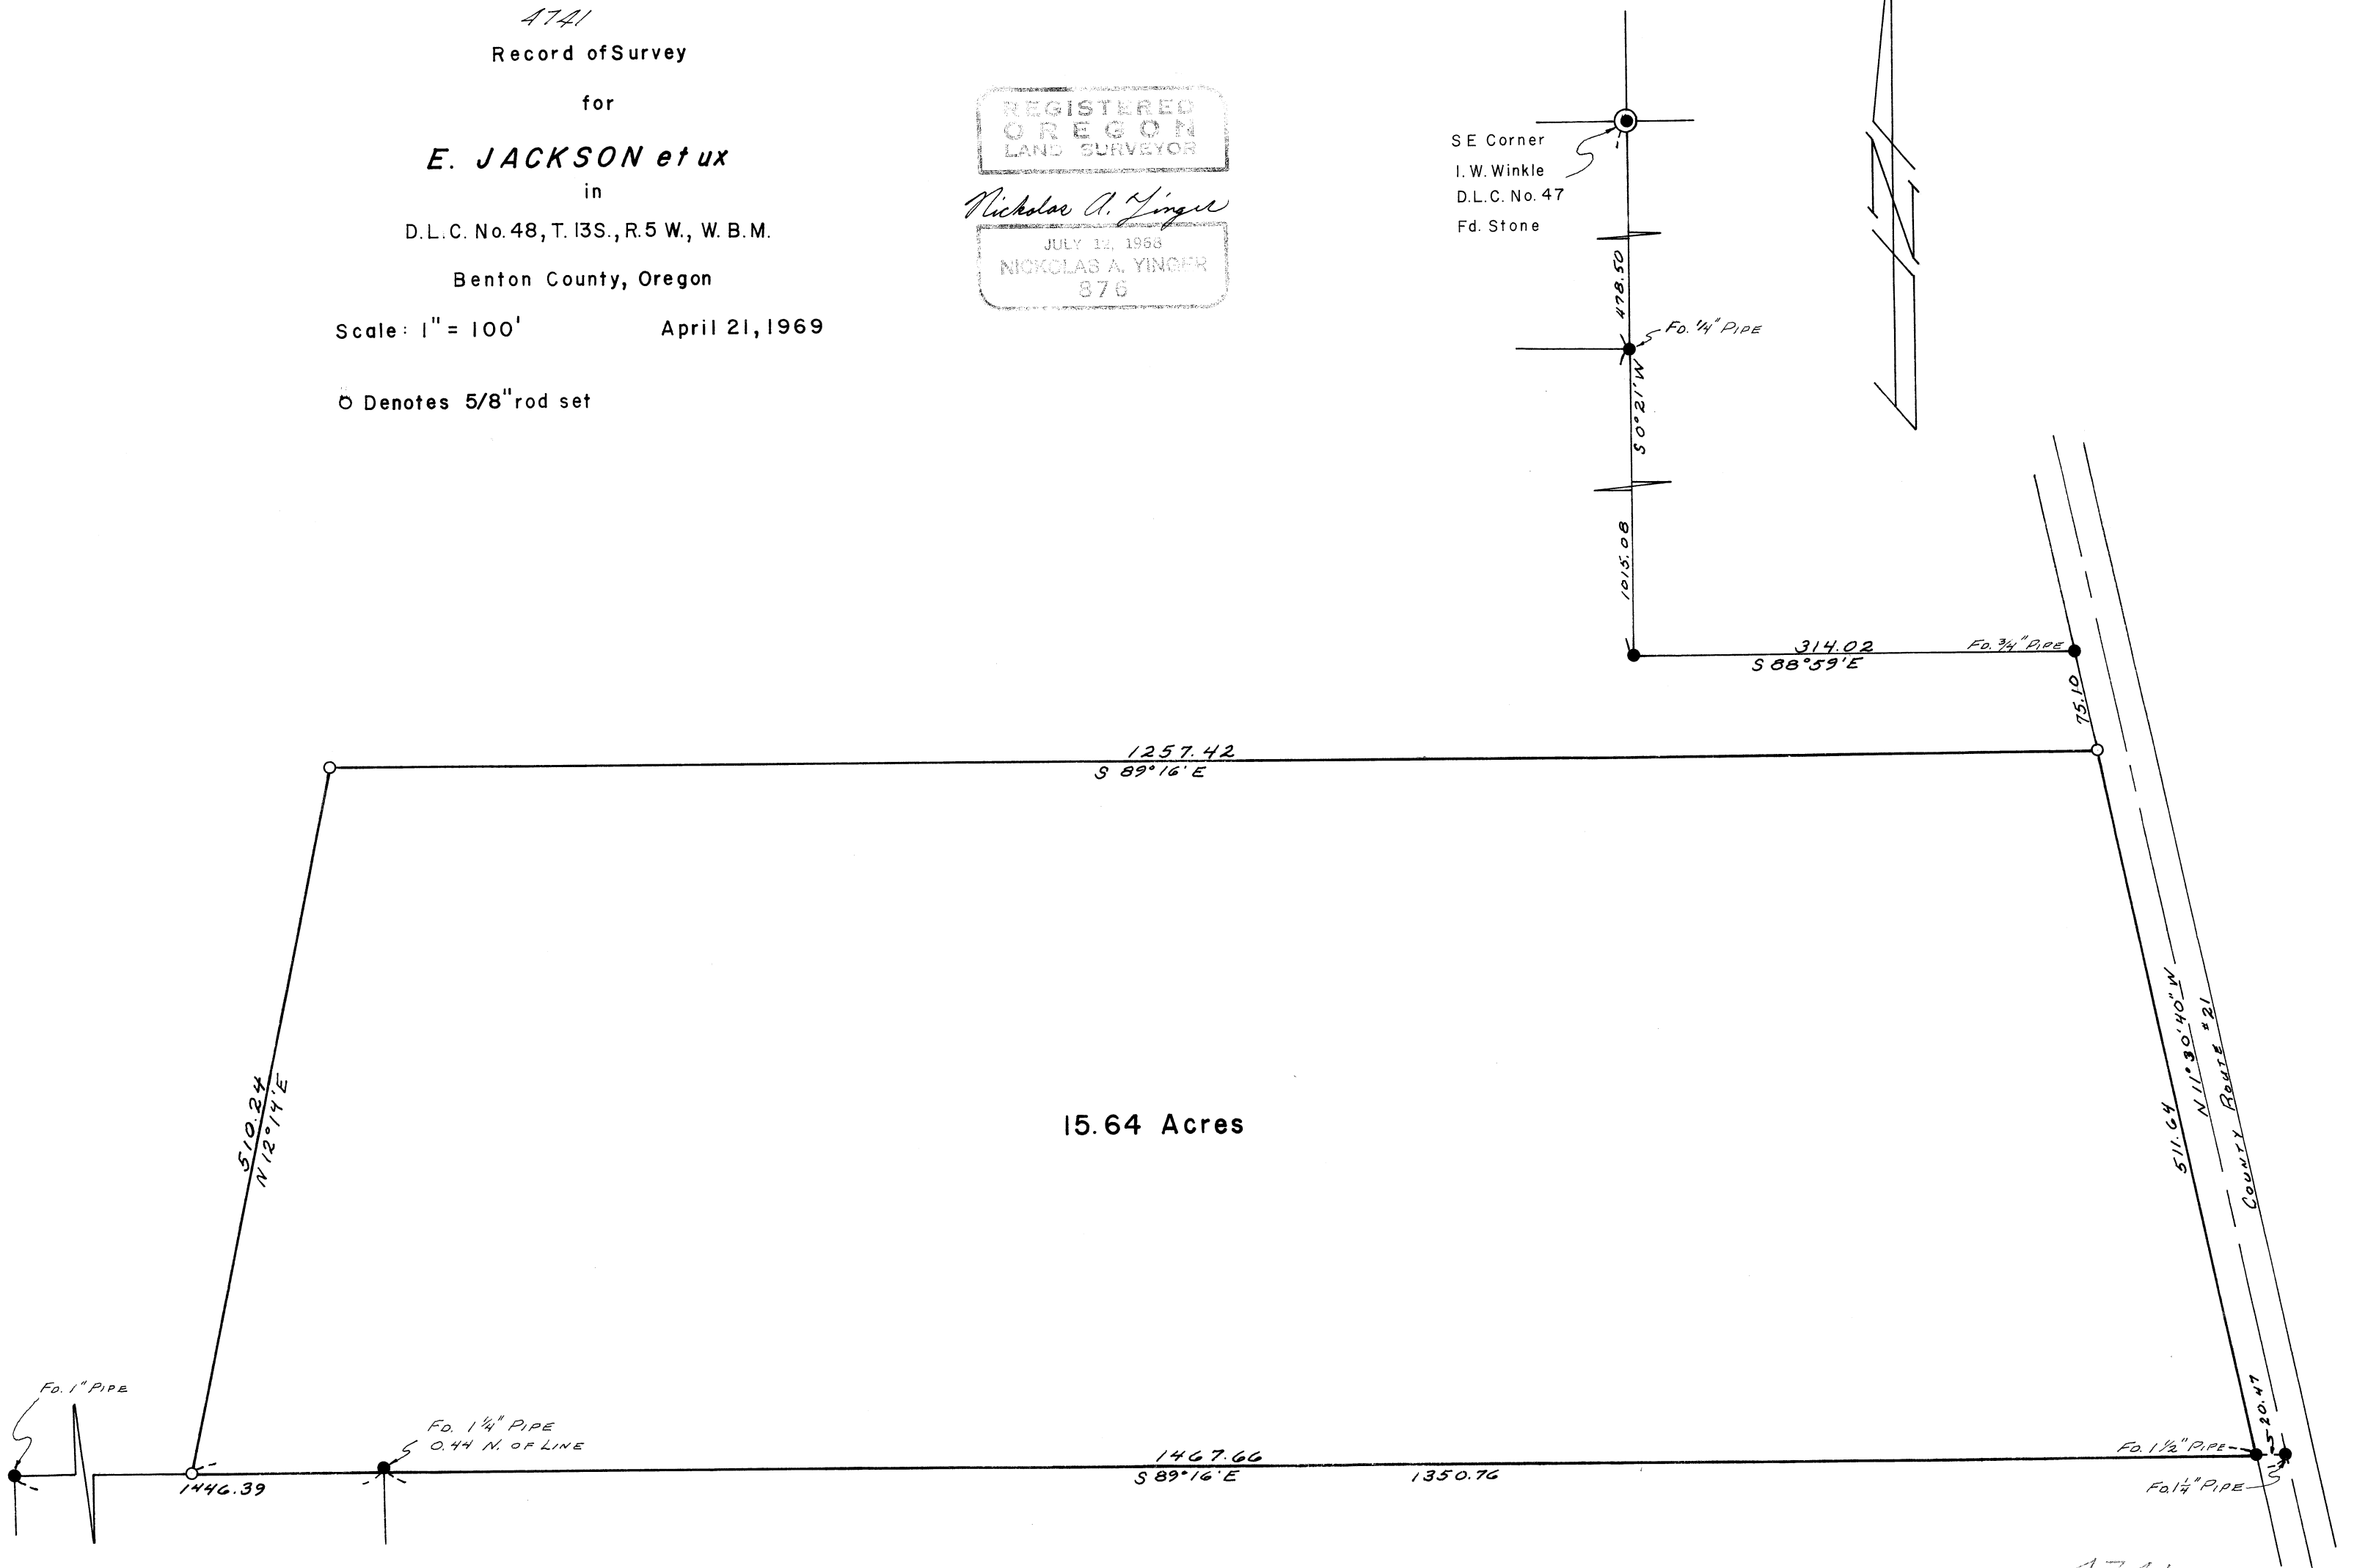

15.64 Acres

4741