


4753

4753

4753
 SURVEY FOR
 ARCHDIOCESE OF PORTLAND
 A SOUTHERLY PORTION OF BLOCK 17
 COLLEGE HILL ADDITION TO
 CORVALLIS, BENTON COUNTY, OREGON
 SCALE: 1"=30' MAY 4, 1969

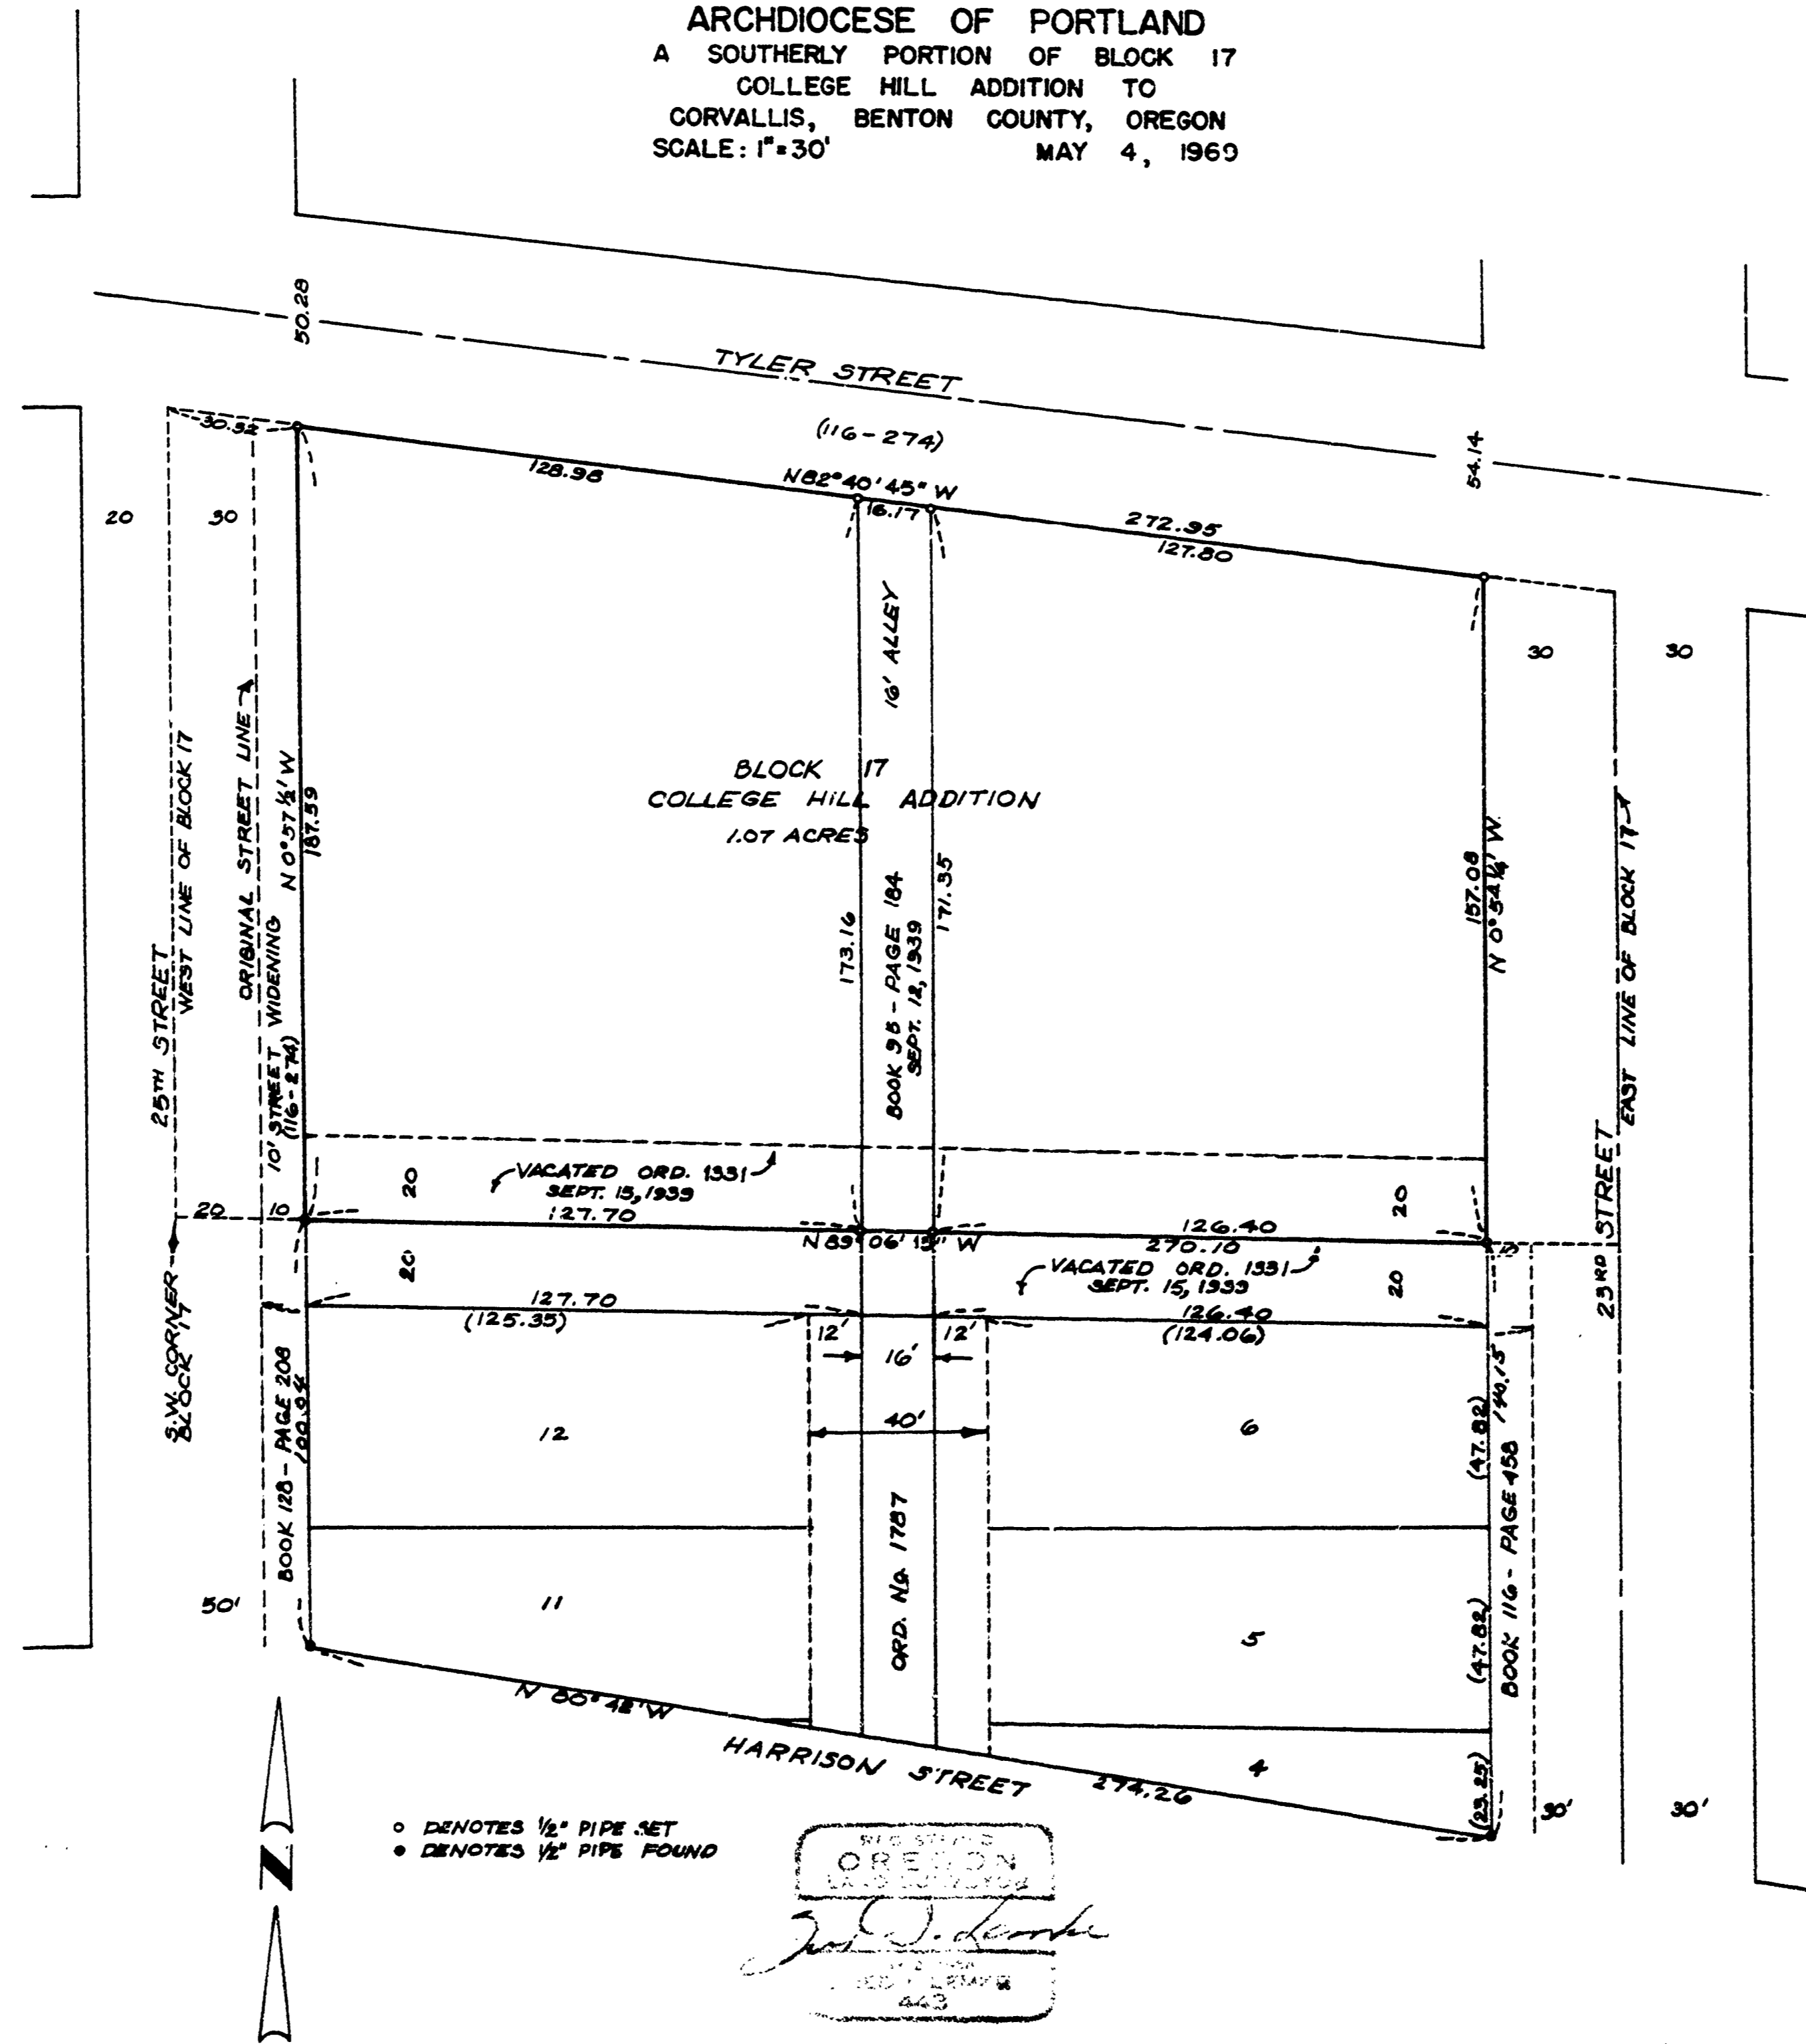

4753