


4765

SURVEY for JACK BRANDIS, Jr.
in Section 19, Township 11 South, Range 5 West,
Willamette Meridian, Benton County, Oregon

May 15, 1969

Scale: 1" = 50'

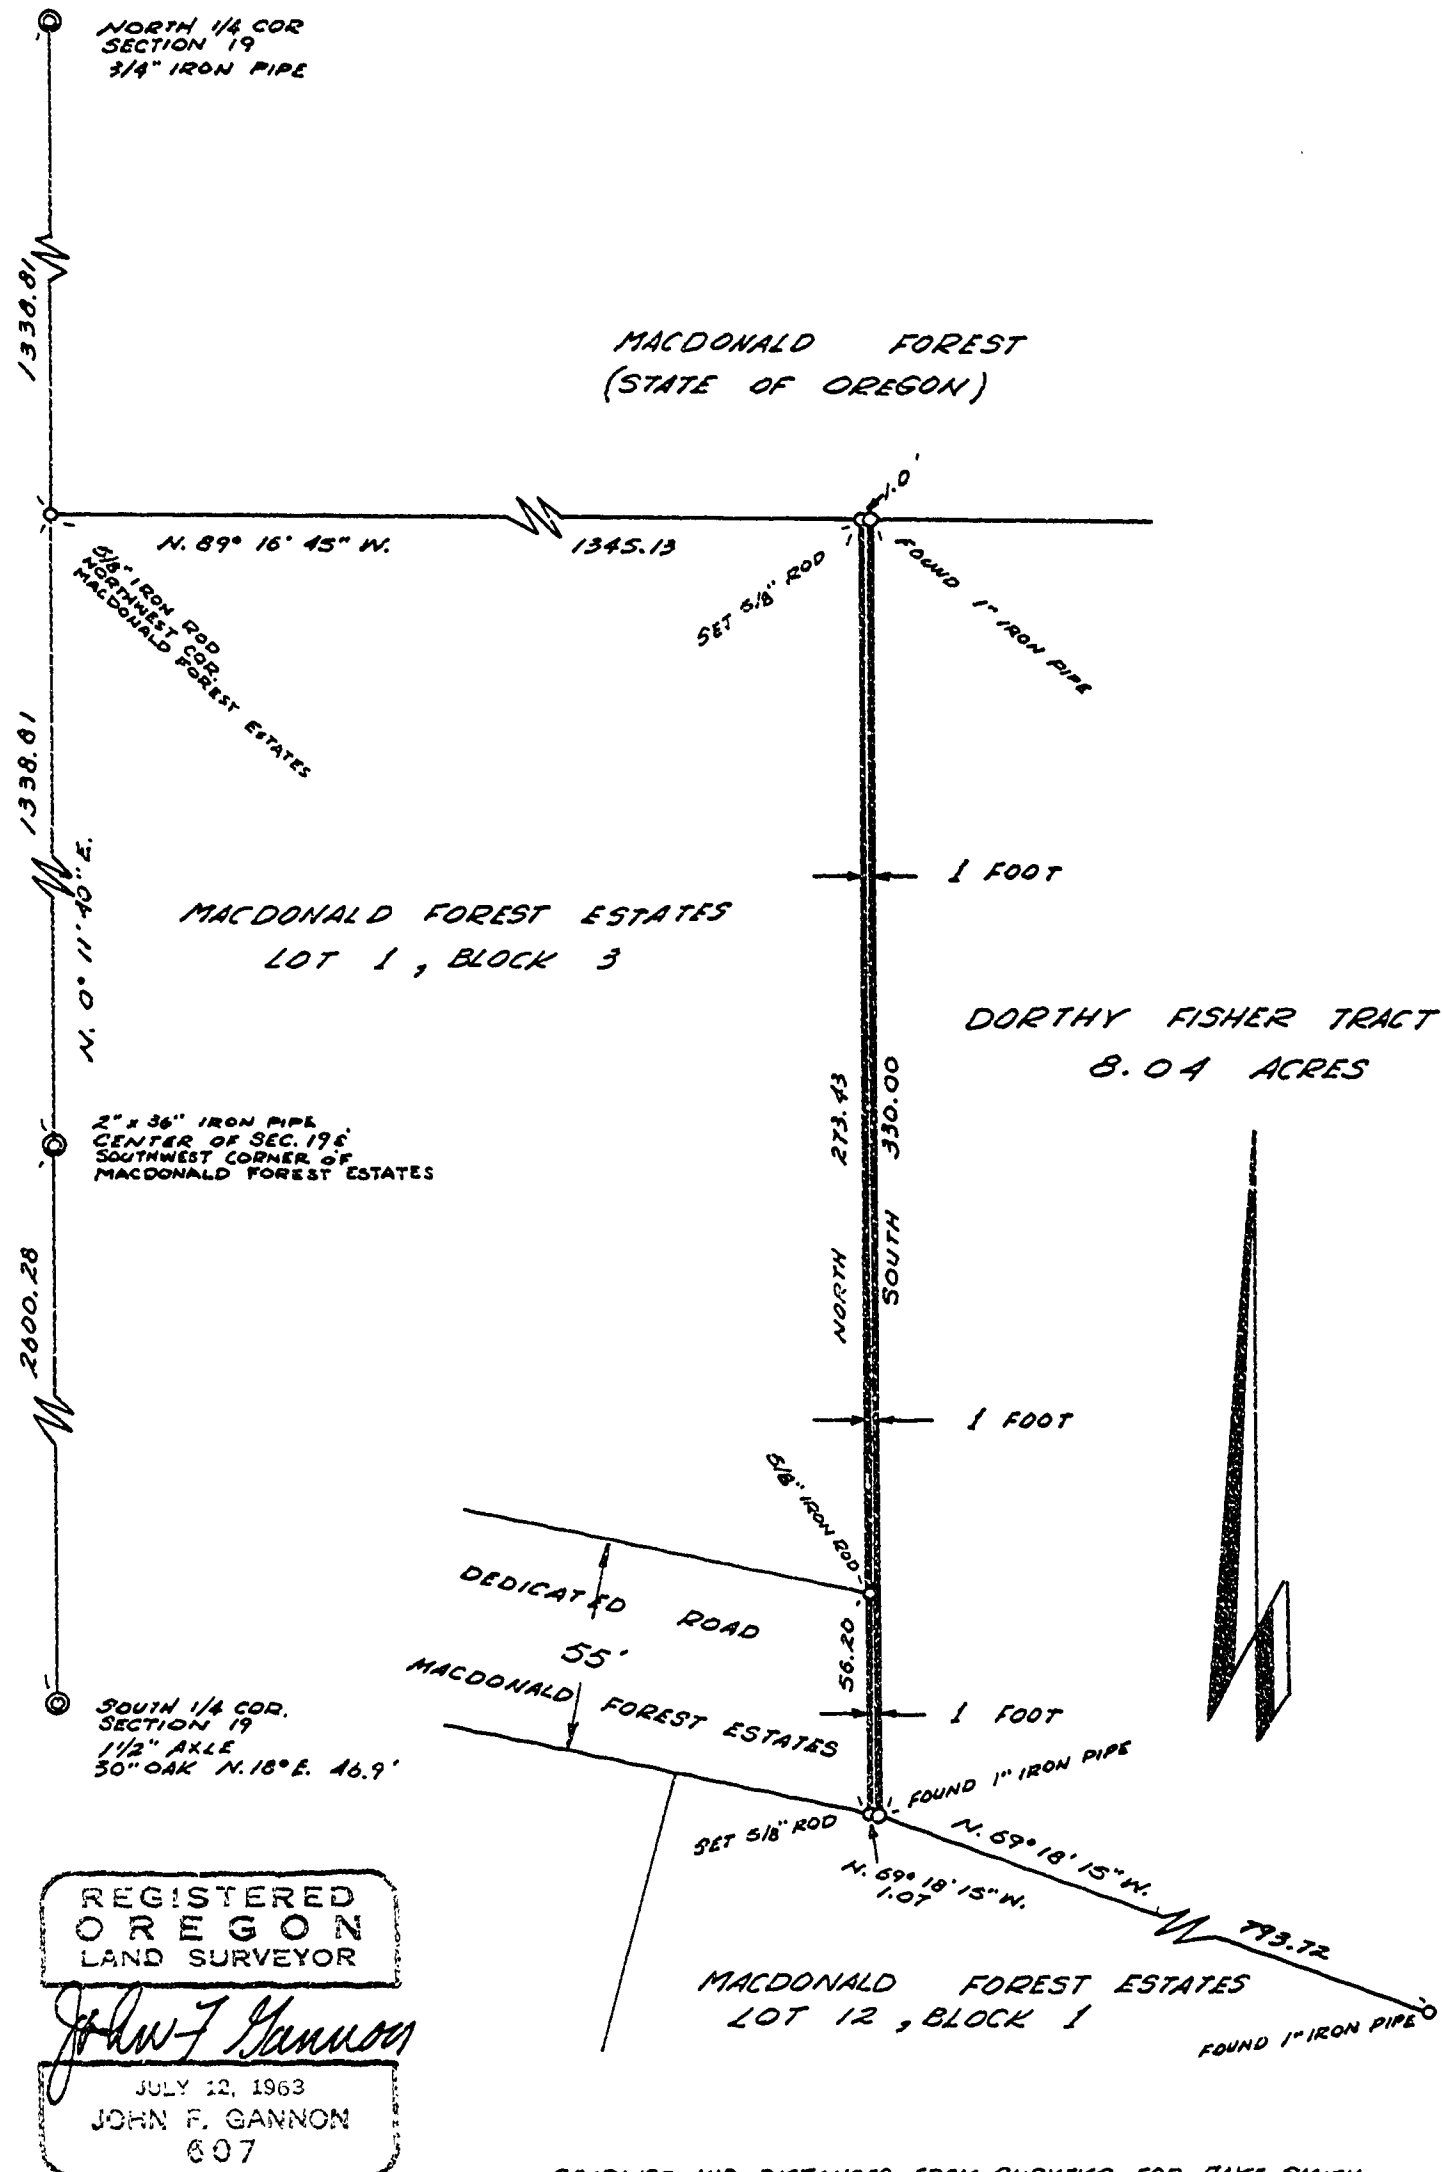

BEARINGS AND DISTANCES FROM SURVEYS FOR FAYE SMITH
BY FRED LEMKE AND SURVEY OF MACDONALD FOREST
ESTATES.