


REV. J.C.R. SCHMIDT

JAMES W. VANDERPOOL D.L.C. No. 45 - 11-7 W.M.

SCALE: 1" = 2 ch.

JUNE 15, 1969

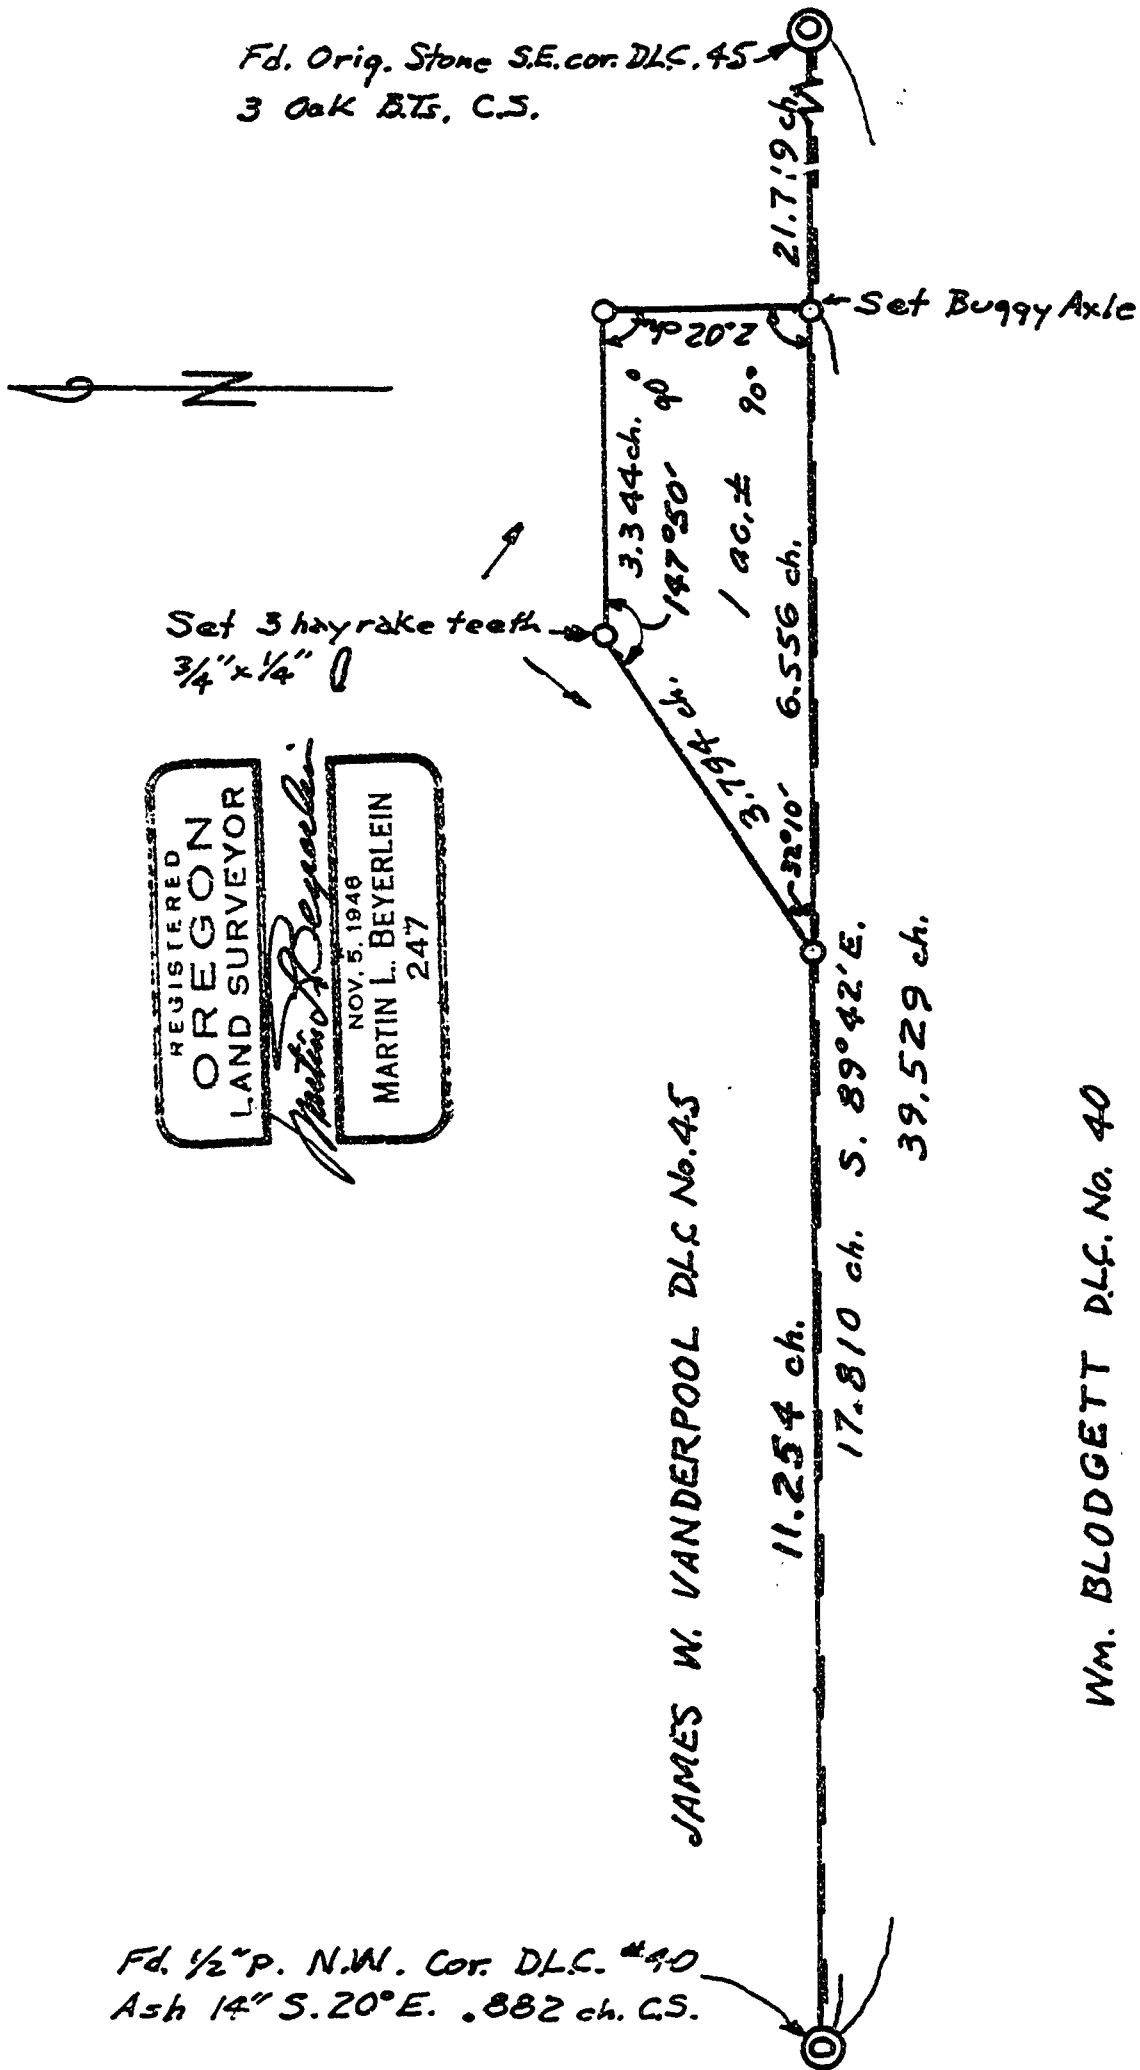

Wm. BLODGETT D.L.C. No. 40