

4811

Robert Christensen


I. H. Newton D.L.C. No. 70

Sec. 6, T12S, R5W, W.M.

BENTON COUNTY, OREGON

August 1969

1" = 400'

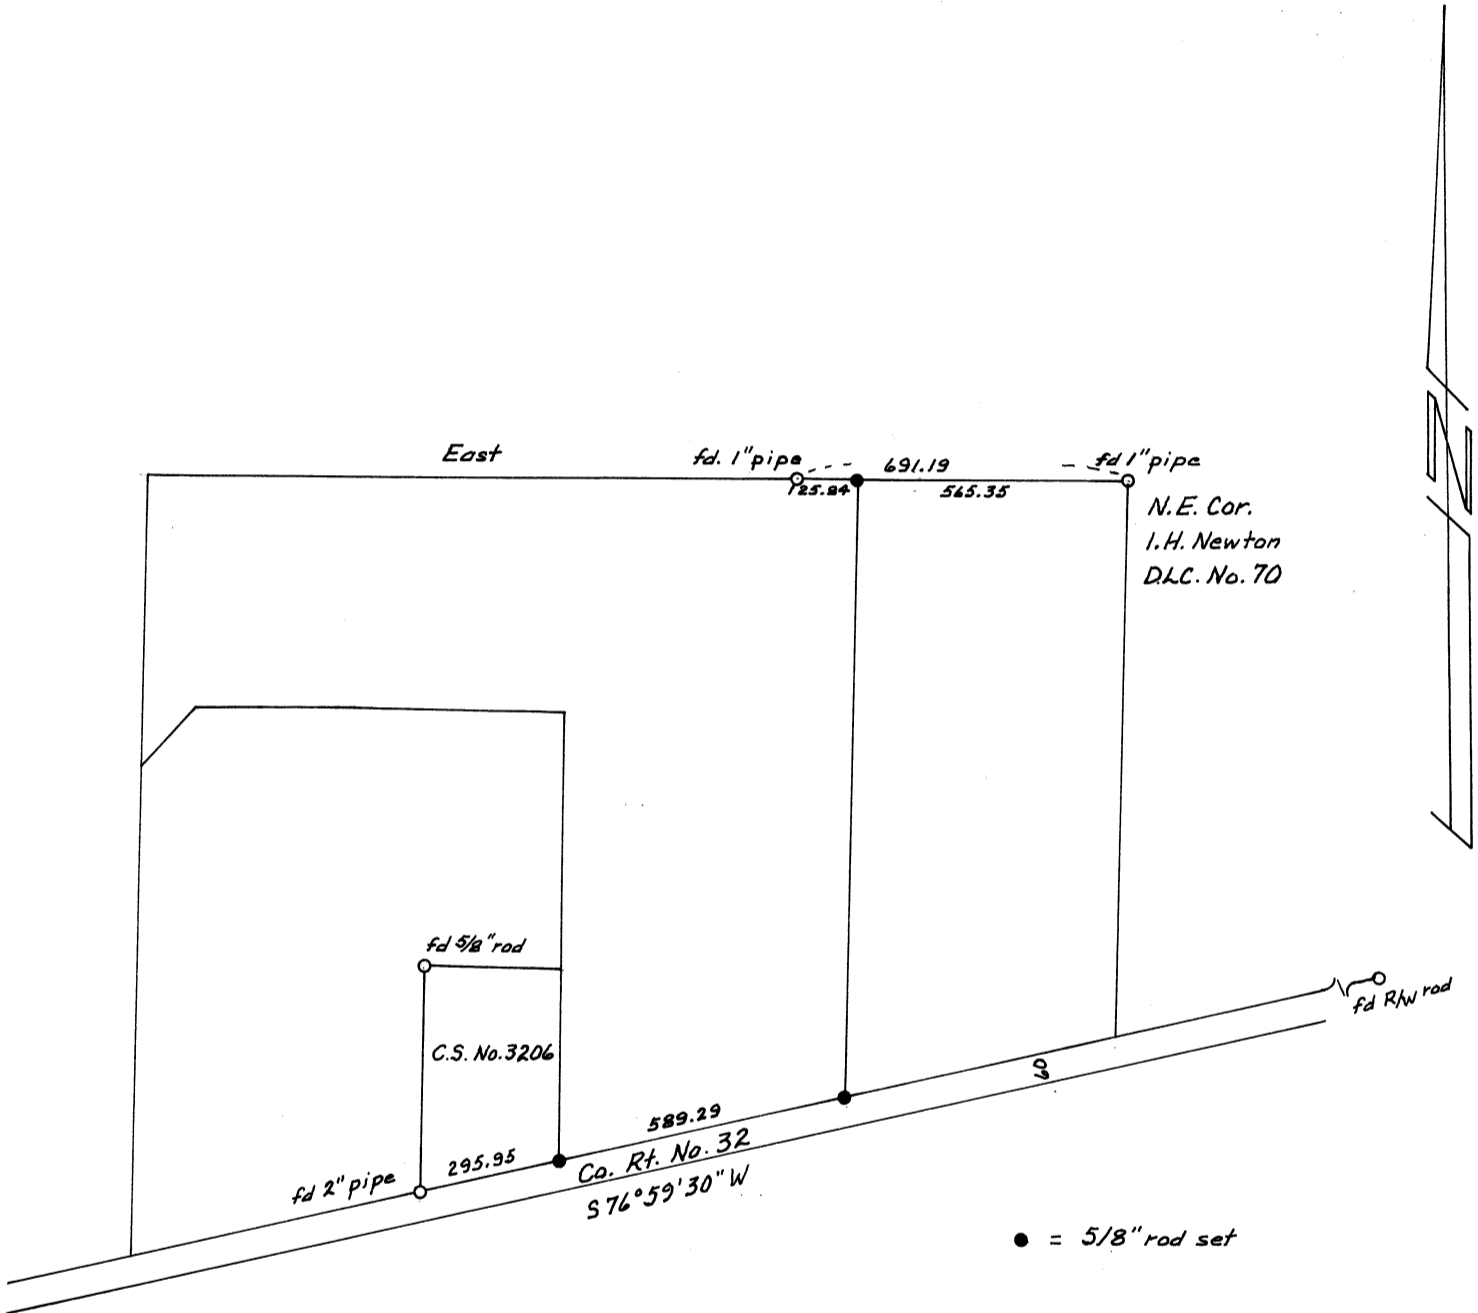

REGISTERED  
OREGON  
LAND SURVEYOR

*Nicholas A. Yinger*

JULY 12, 1968  
NICKOLAS A. YINGER  
876