

4894


4894

BEARINGS FROM C.S. RECORDS

4894  
 Record of Survey  
 for  
**EUGENE W. FREESE**  
 and  
**ROY ASHLING**  
 in the  
 Lewis Morris D.L.C. 70  
 Section 28, T.10S., R.4W. W.B.&M.  
 Benton County, Oregon  
 Scale: 1" = 200' April 22, 1970

Parentheses indicate information from C.S. Records.

REGISTERED  
**OREGON**  
 LAND SURVEYOR  
*Verle C. Moore*  
 MAY 19, 1960  
**VERLE C. MOORE**  
 501

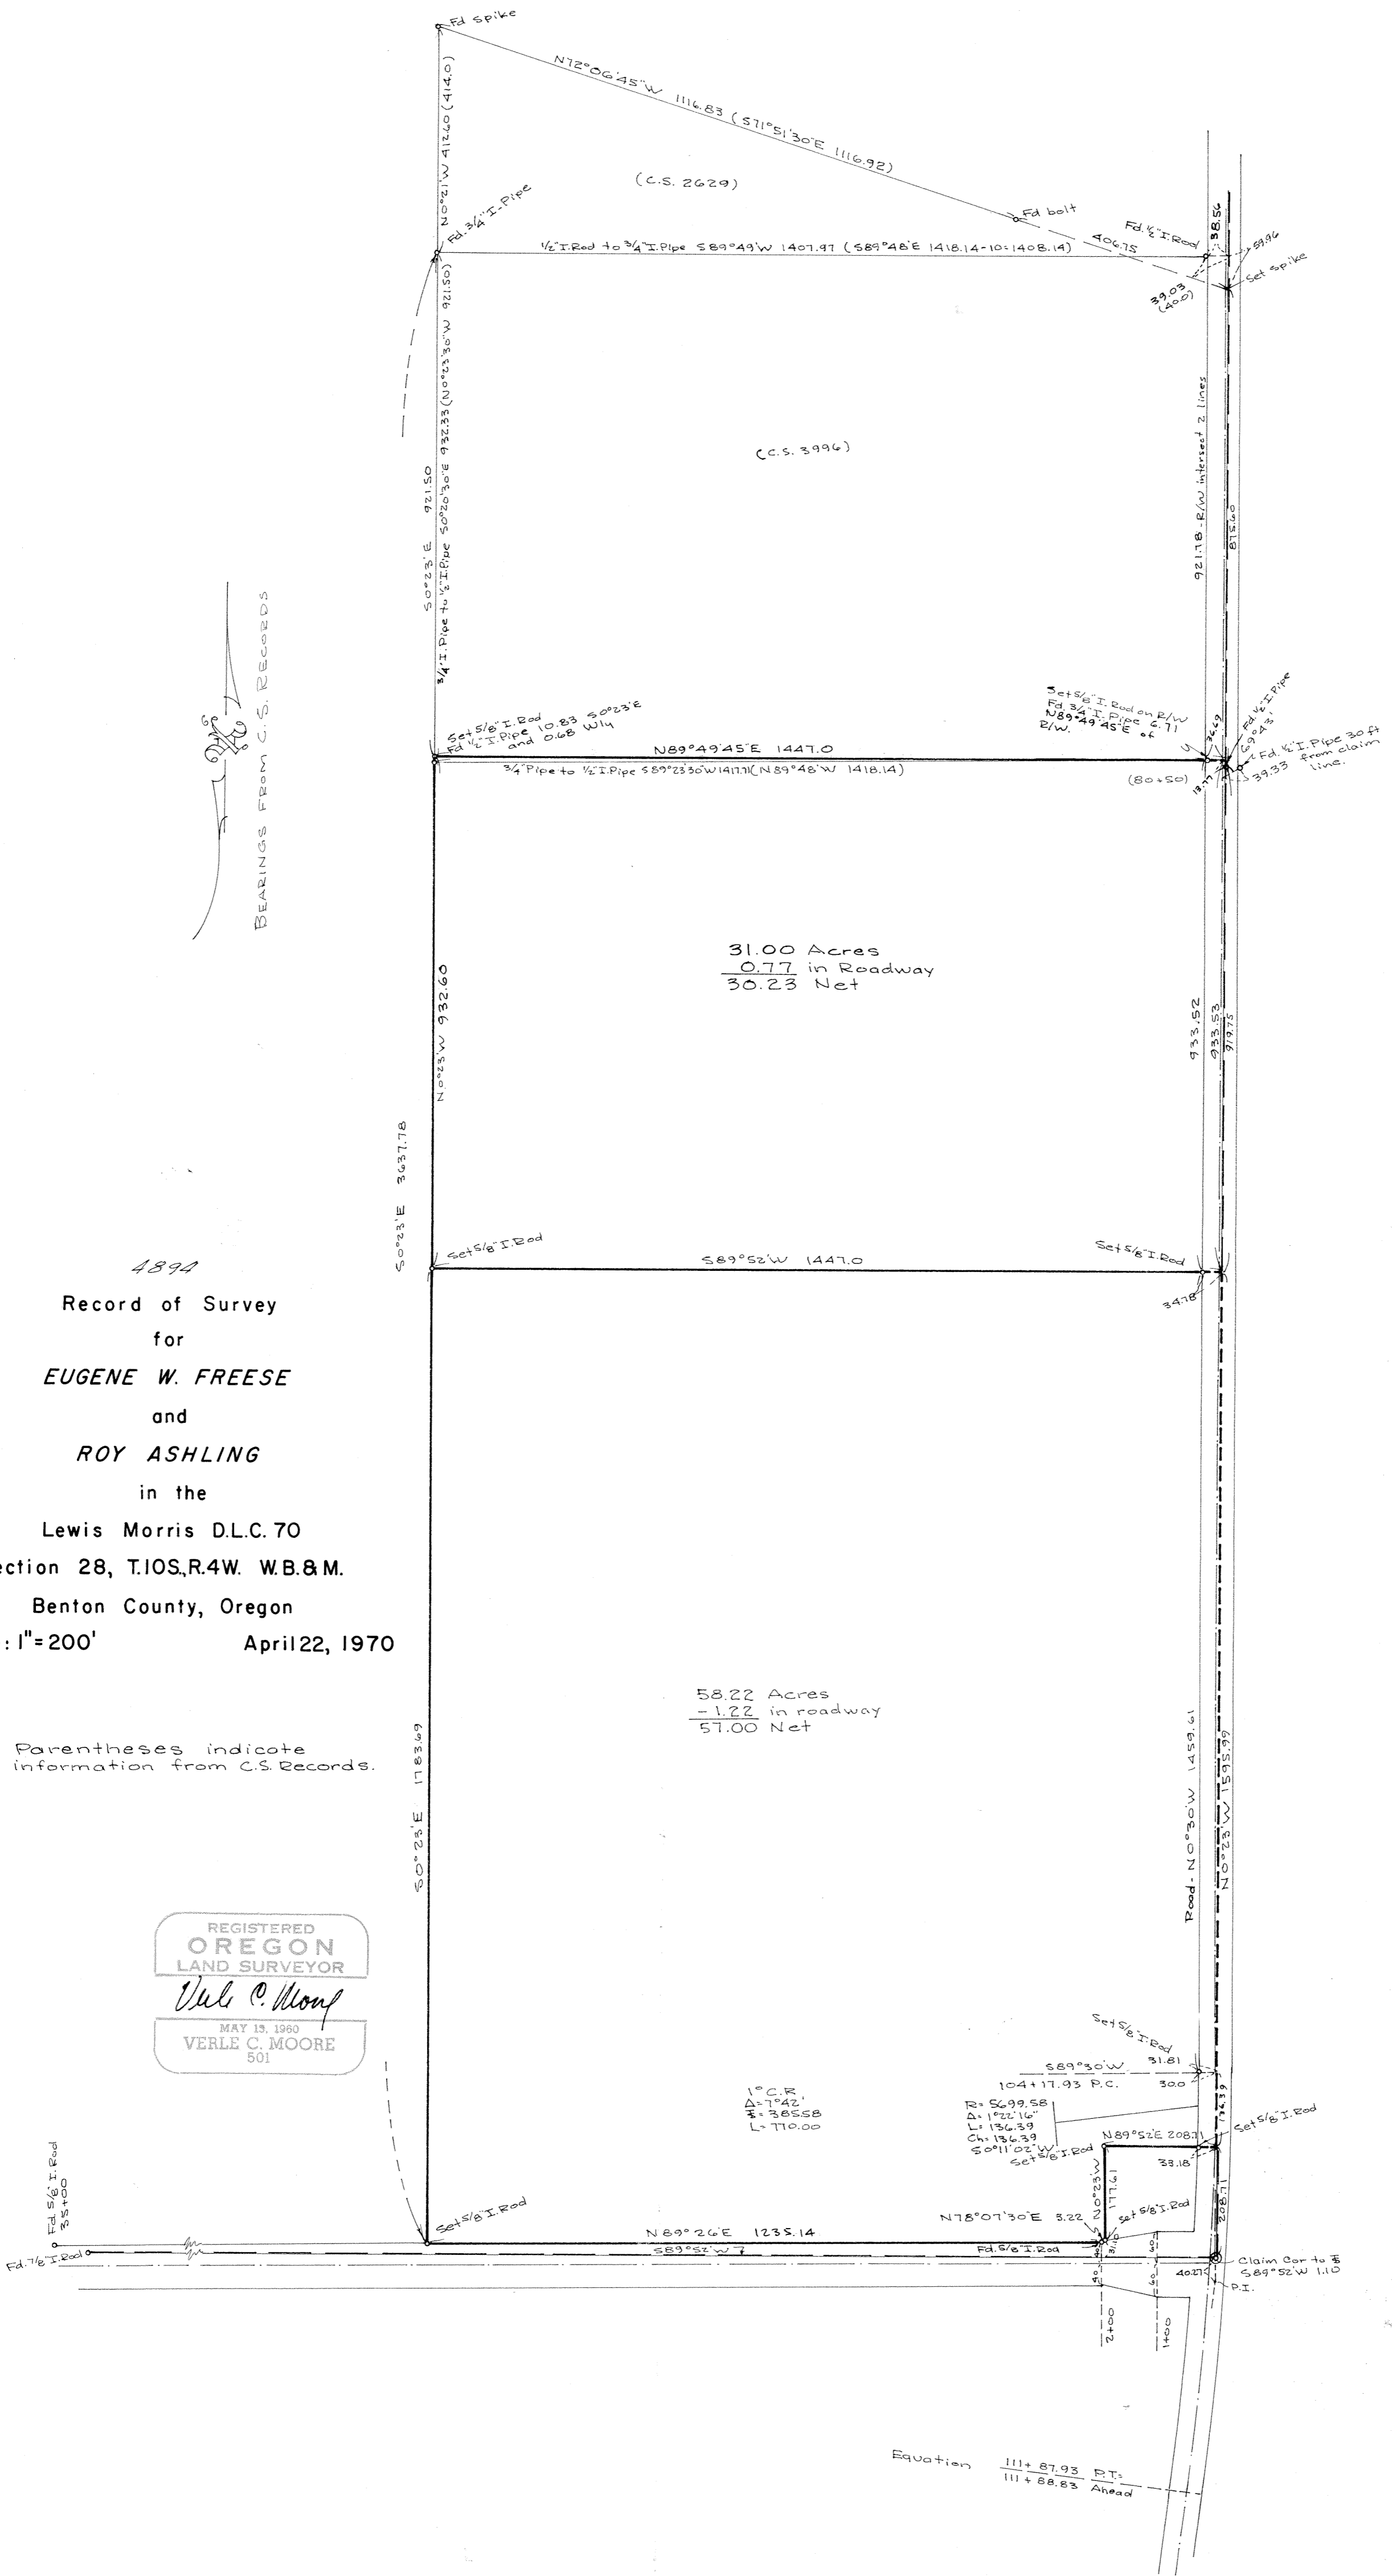

4894