


4919

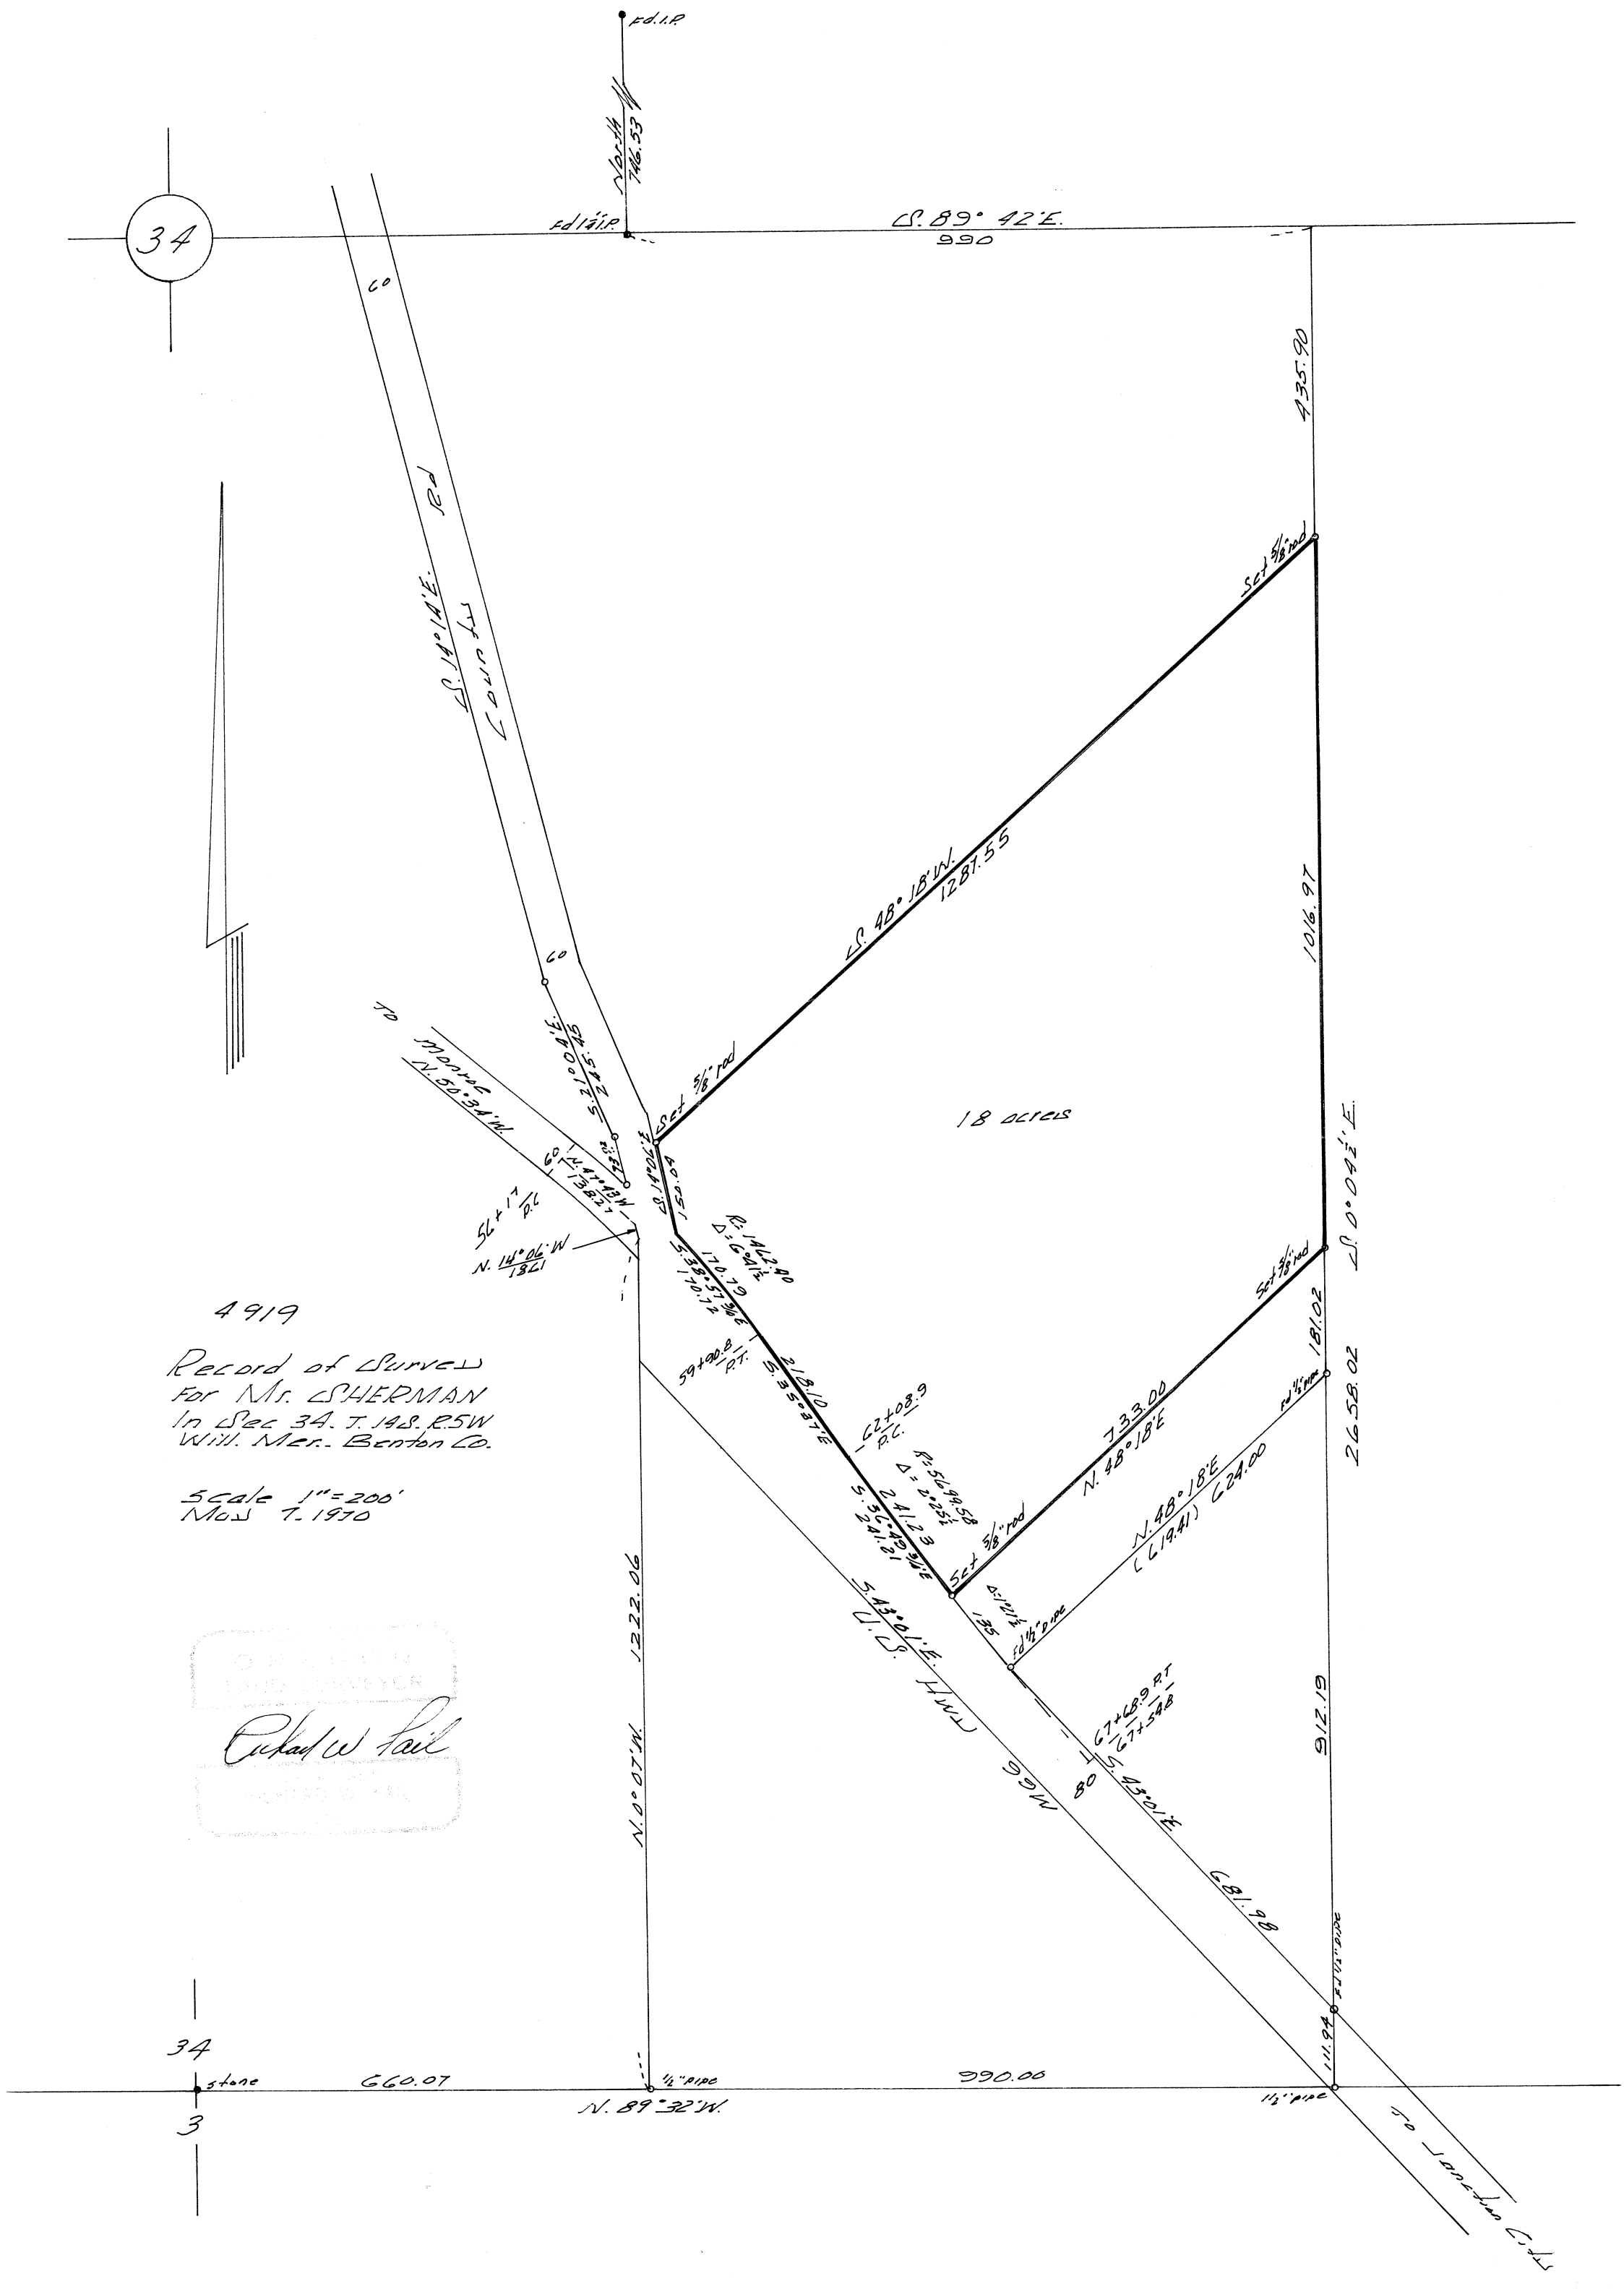

34

4919
 Record of Survey
 for Mr. SHERMAN
 in Sec 34, T. 48, R. 5W
 Will. Mer. Benton Co.
 Scale 1" = 200'
 Mod 7. 1970

OF AND BY
 LAND SURVEYOR
Richard W. Hill
 LAND SURVEYOR

34
3

stone

660.07

N. 89° 32' W.

990.00

1 1/2" pipe

912.19

To Jackson Co. IL