


4978
 Record of Survey
 for
 ROBERT BUNN
 IN THE
 HEMAN C. LEWIS DLC No 47
 T.11S., R.5W., of the Will. Mer.
 Benton County, Ore.

Scale 1" = 50'
 FEB. 19. 1970

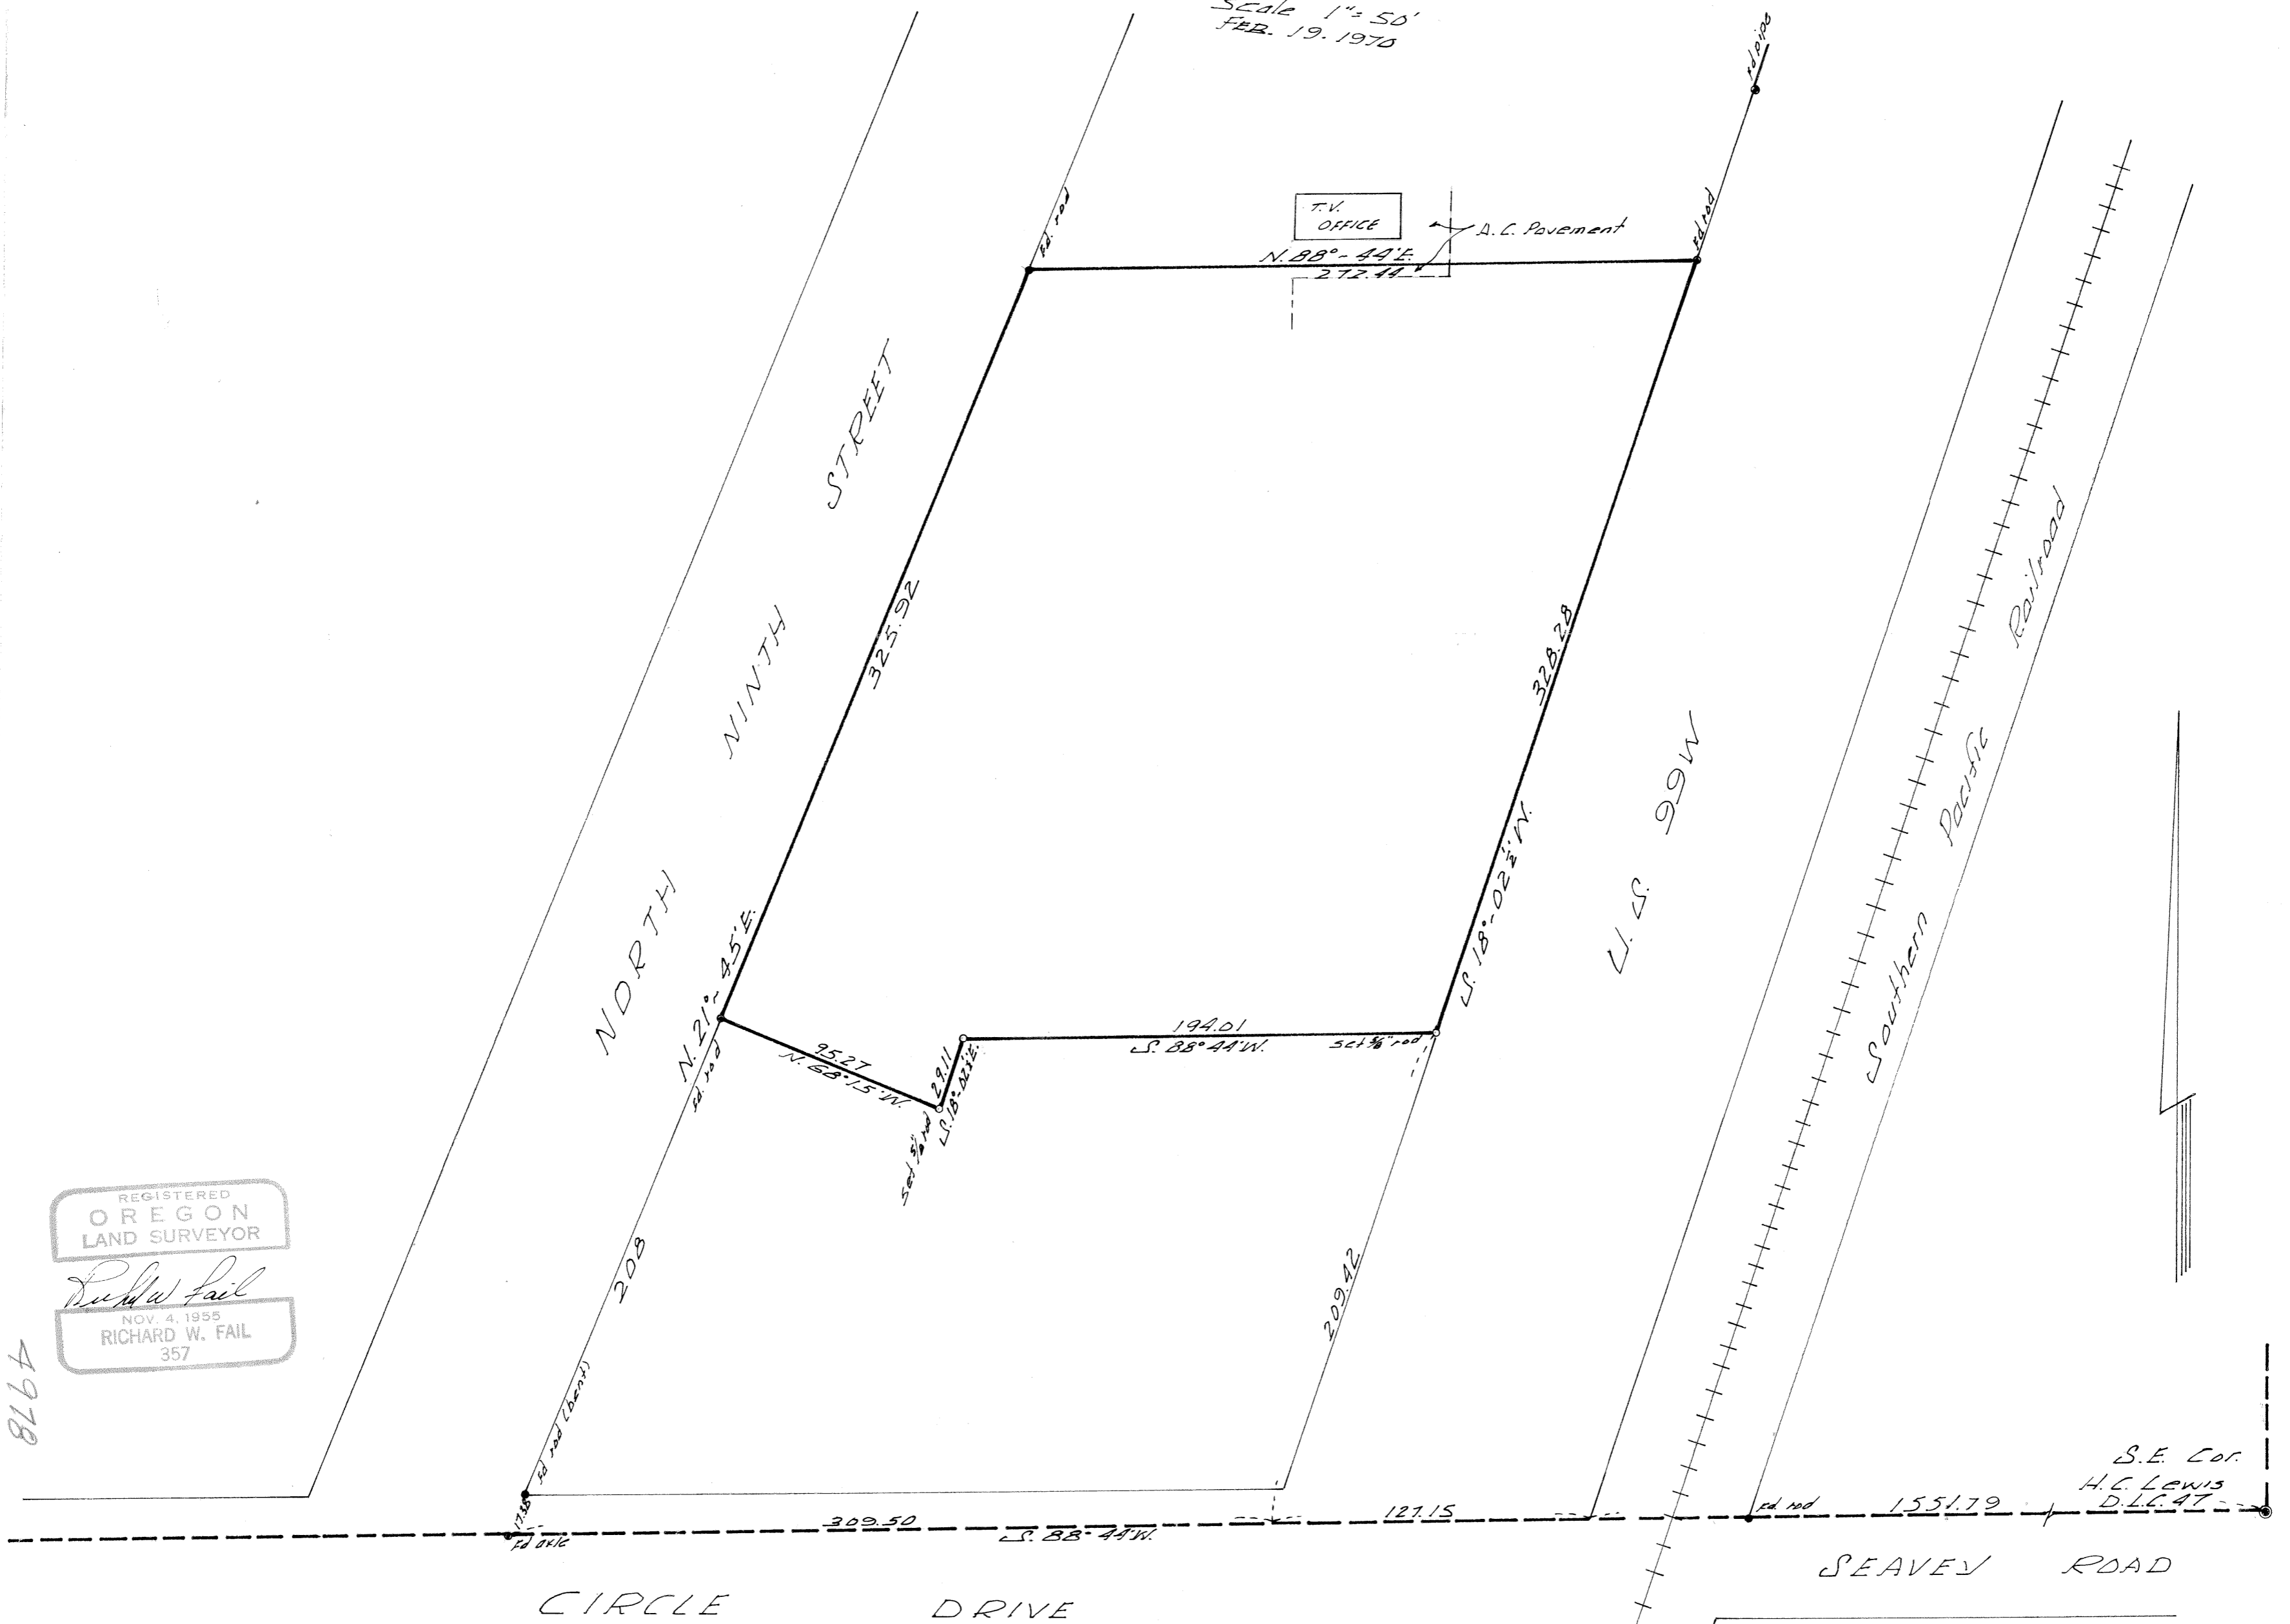

REGISTERED
 OREGON
 LAND SURVEYOR
Richard W. Fail
 NOV. 4, 1955
 RICHARD W. FAIL
 357

4978

S.E. Cor.
 H.C. Lewis
 D.L.C. 47