


C.S. 5010

E. M. MARRS
 AND
 McGARRY'S CONST.
 S.W. 1/4 SEC. 21 T. 12. S. R. 6W. W.M.
 Scale 1" = 200' 12/21/70
 Bert W. Udell
 R.P.E. 2301

Replaces
 C.S.

Bert W. Udell

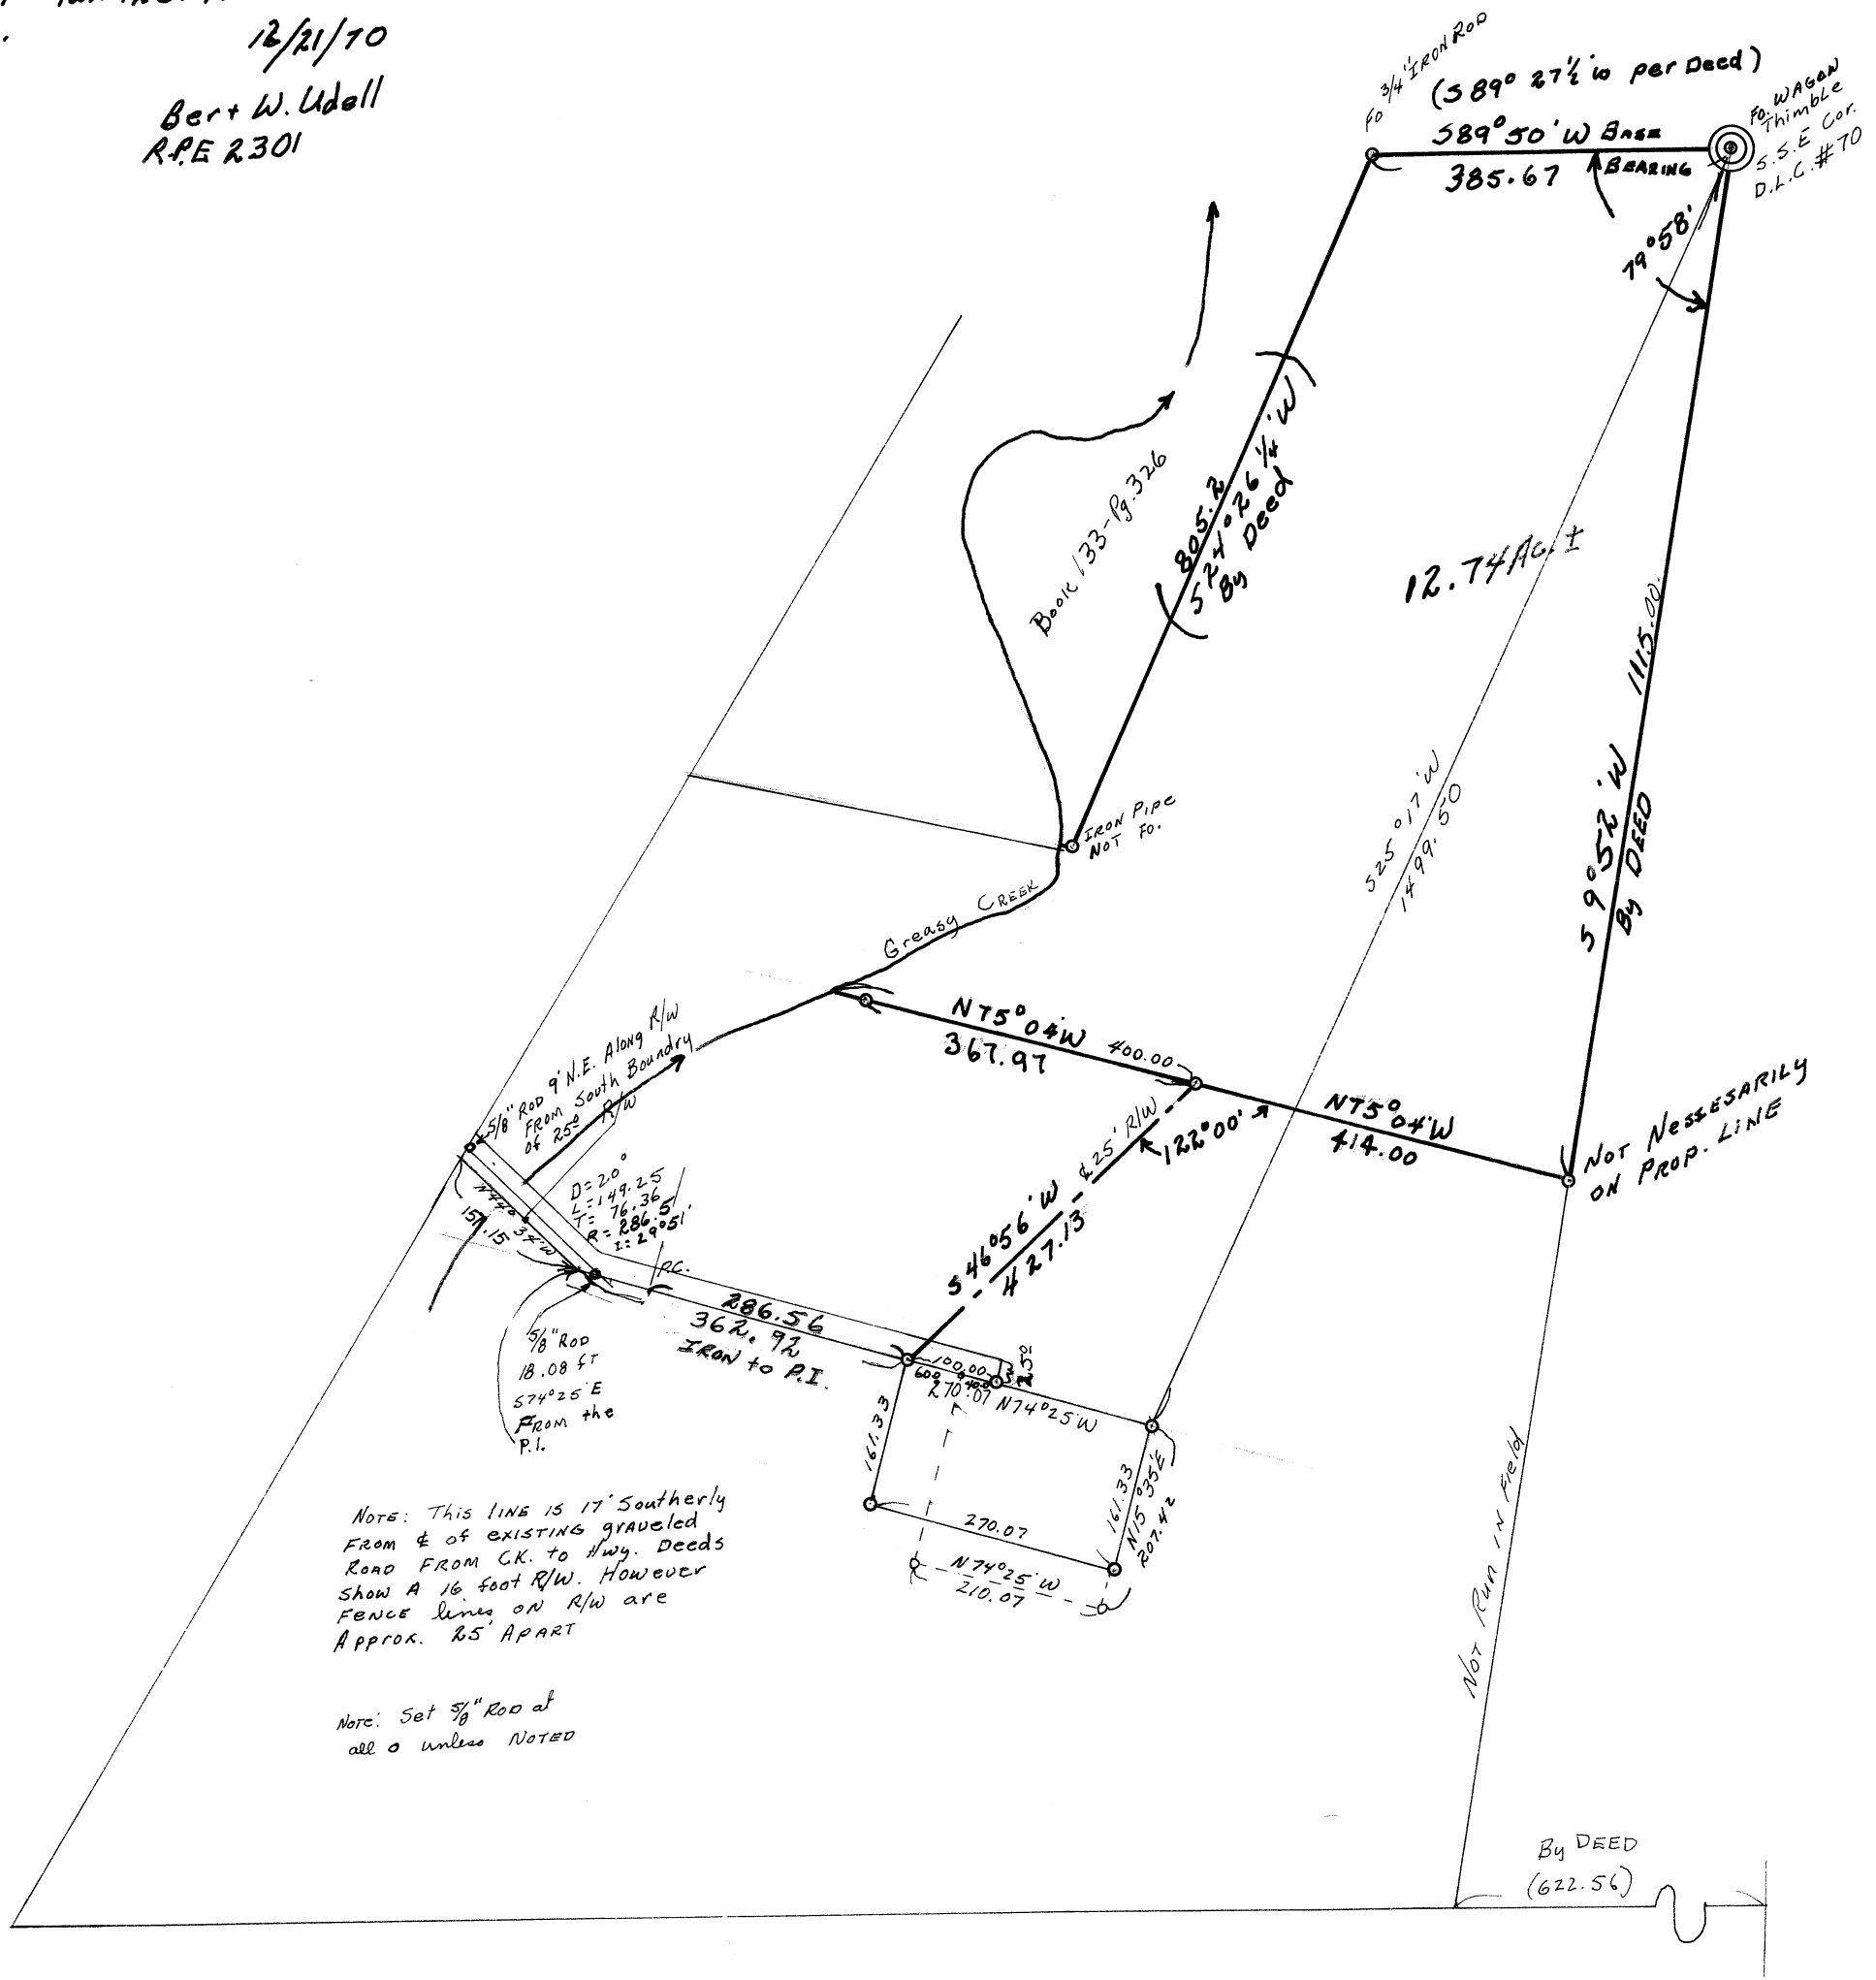

Note: This line is 17' Southerly from E of existing graveled Road from Ck. to Hwy. Deeds show a 16 foot R/W. However fence lines on R/W are approx. 65' apart

Note: Set 3/8" Rod at all o unless NOTED