


C.S. 5040

RECORD OF SURVEY  
FOR

MAREE & MAYBELL SIMONSON

IN THE BUSHROD WILSON D.L.C. No 64  
T. 12 S. R. 5 W. OF THE WILL. MER. BENTON CO. ORE.

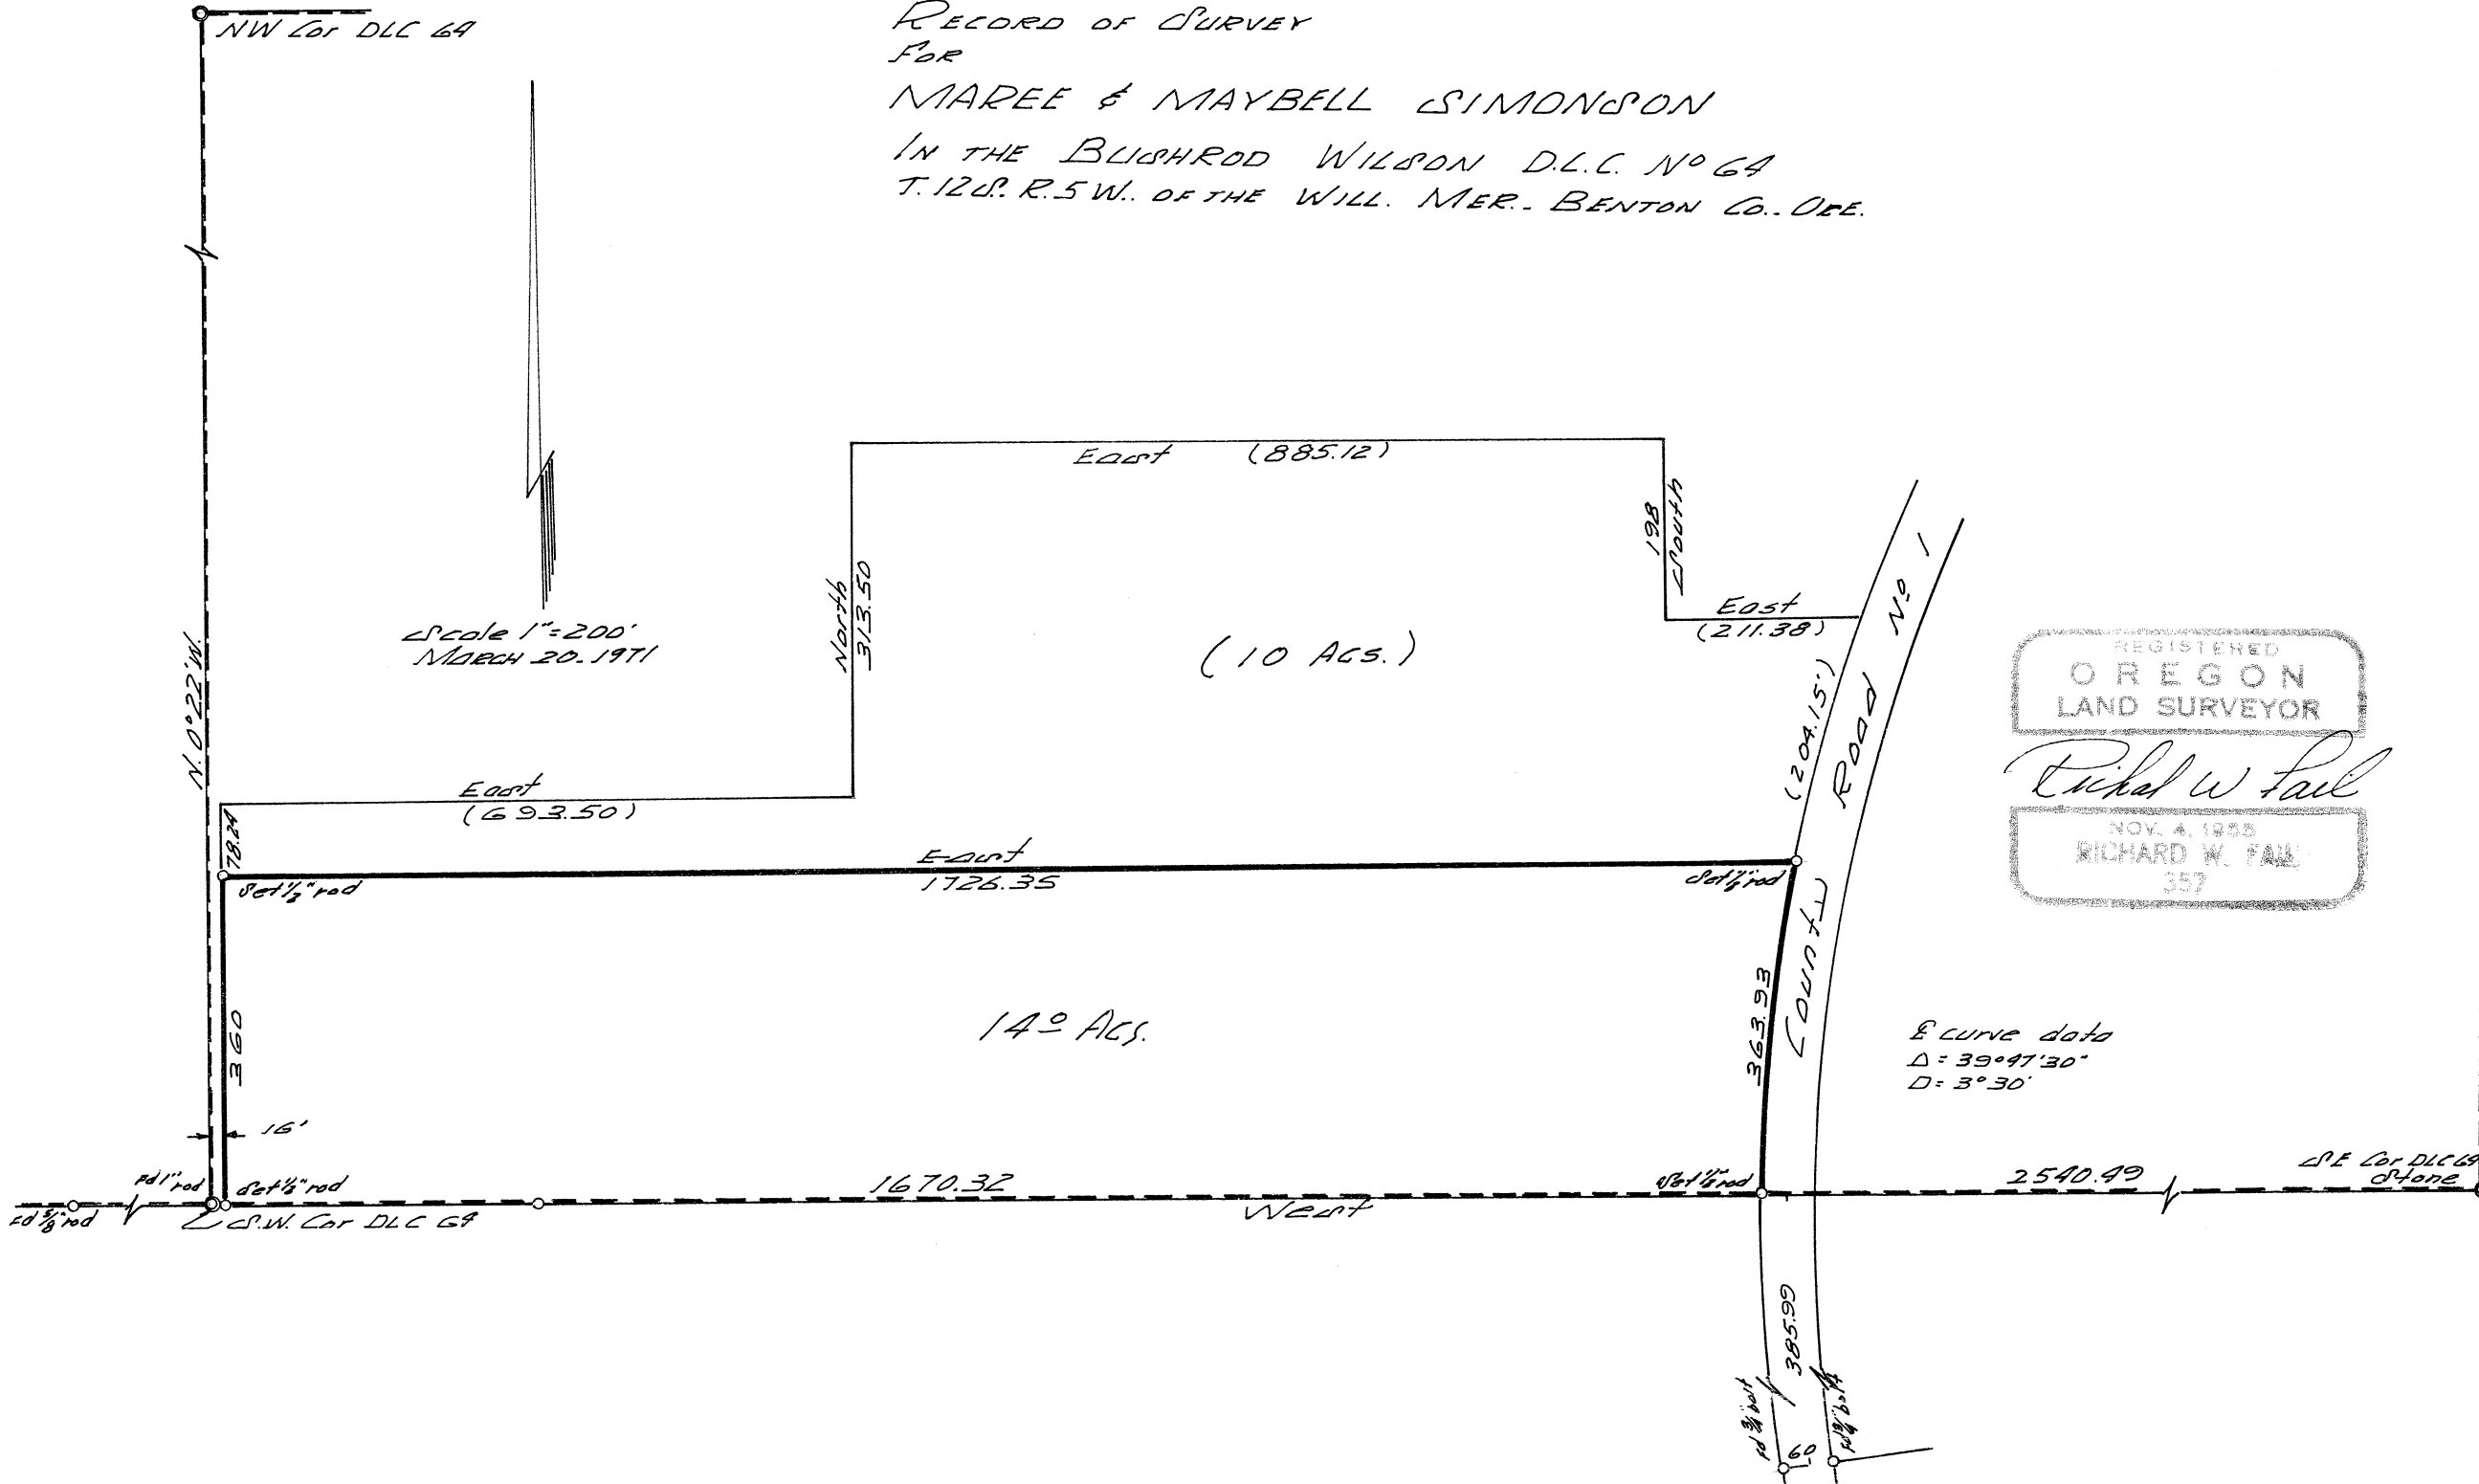

REGISTERED  
OREGON  
LAND SURVEYOR

*Richard W. Fall*

NOV. 4, 1955  
RICHARD W. FALL  
357

Curve data  
 $\Delta = 39^{\circ}47'30''$   
 $D = 3^{\circ}30'$