


C.S. 5075

Corner Search & Remonumentation  
 Devco Engineering  
 Portions of Blocks 4, 5 and 6  
 Riverview Heights  
 Benton County, Oregon  
 May 10, 1971  
 Scale: 1 inch = 100 feet

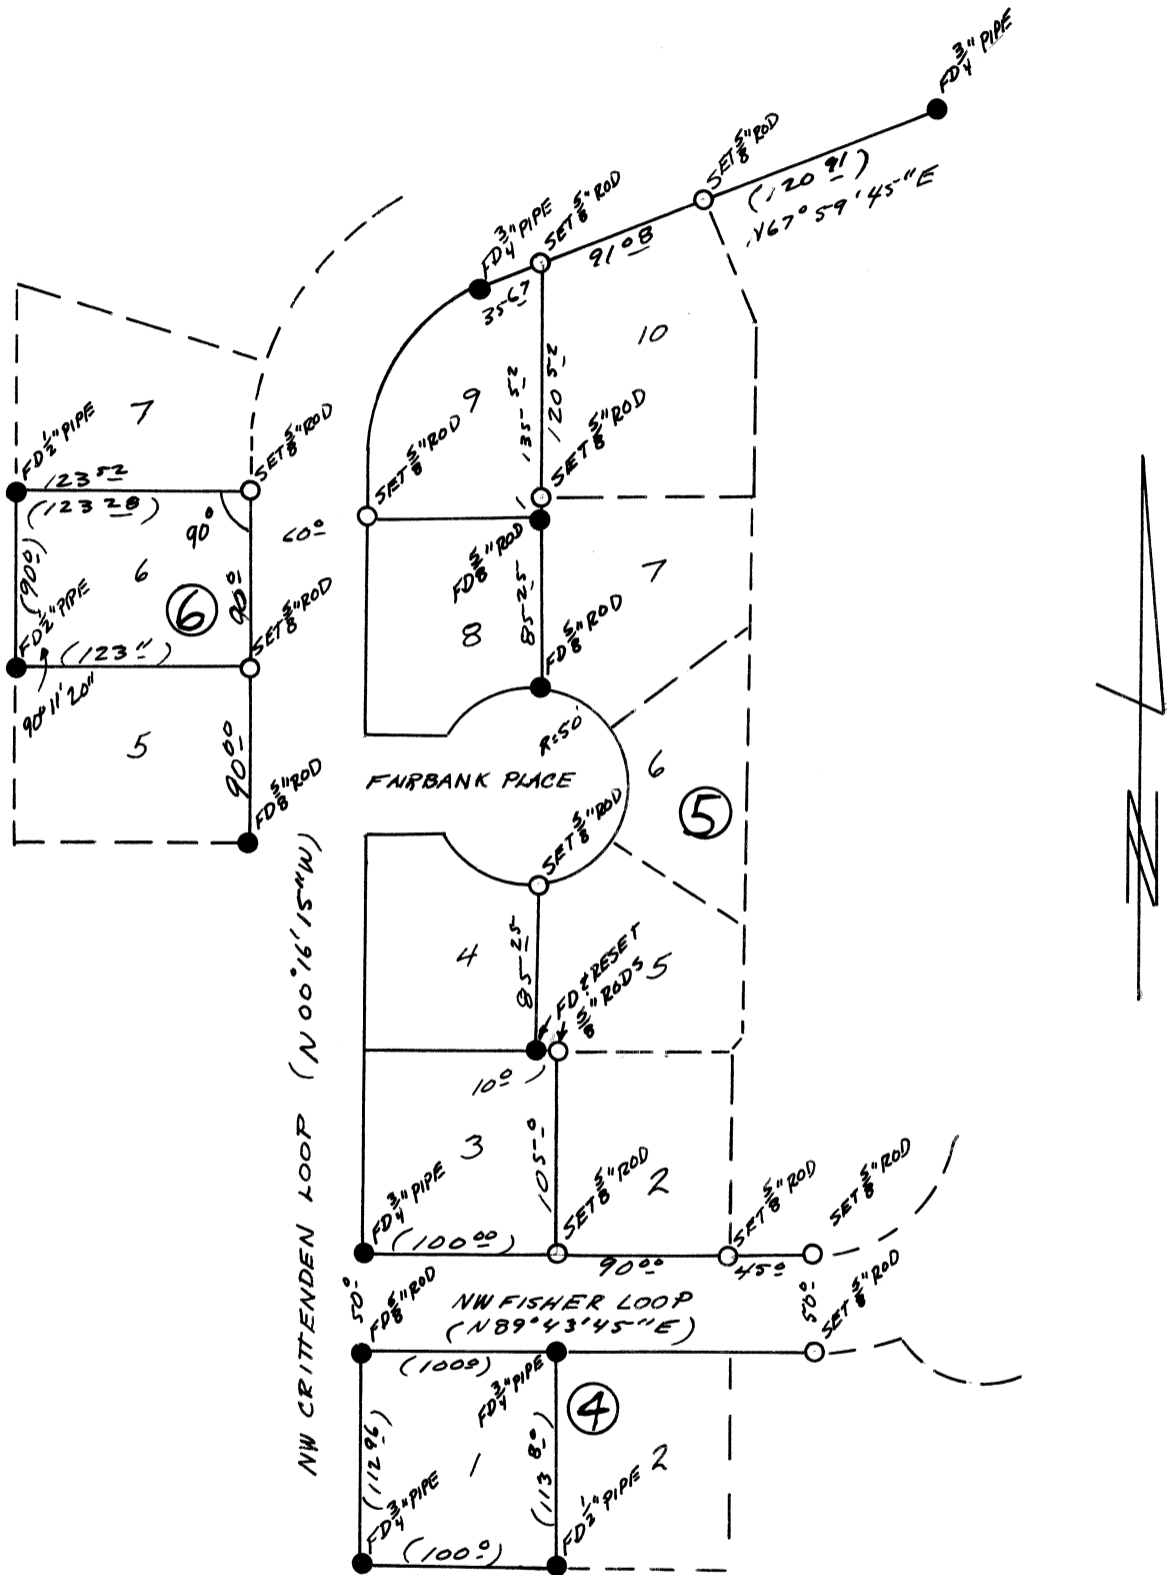

LEGEND

- Corners Found
- Corners Reset
- ( ) Record Distances & Bearings

REGISTERED  
 OREGON  
 LAND SURVEYOR

*Richard L. Bryant*

JULY 17, 1970  
 RICHARD L. BRYANT  
 920