


- FOUND CORNERS
- CORNERS SET

5140

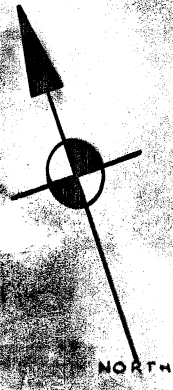

SURVEY FOR KOHNEN & LARSON LOTS 1,2,3,4 BLOCK 15, COUNTY ADD. NESH# SEC. 35 T. 115, R. 5W, W.M.					<i>Tome McCall</i>
McCULLOUGH, BRYANT & ASSOCIATES - CORVALLIS					
DRAWN BY TOM	DATE 10-11-11	SCALE 1" = 50'	SHEET # 114	DENOMINATION 	

**MICROFILM
COPY OF
ORIGINAL**