
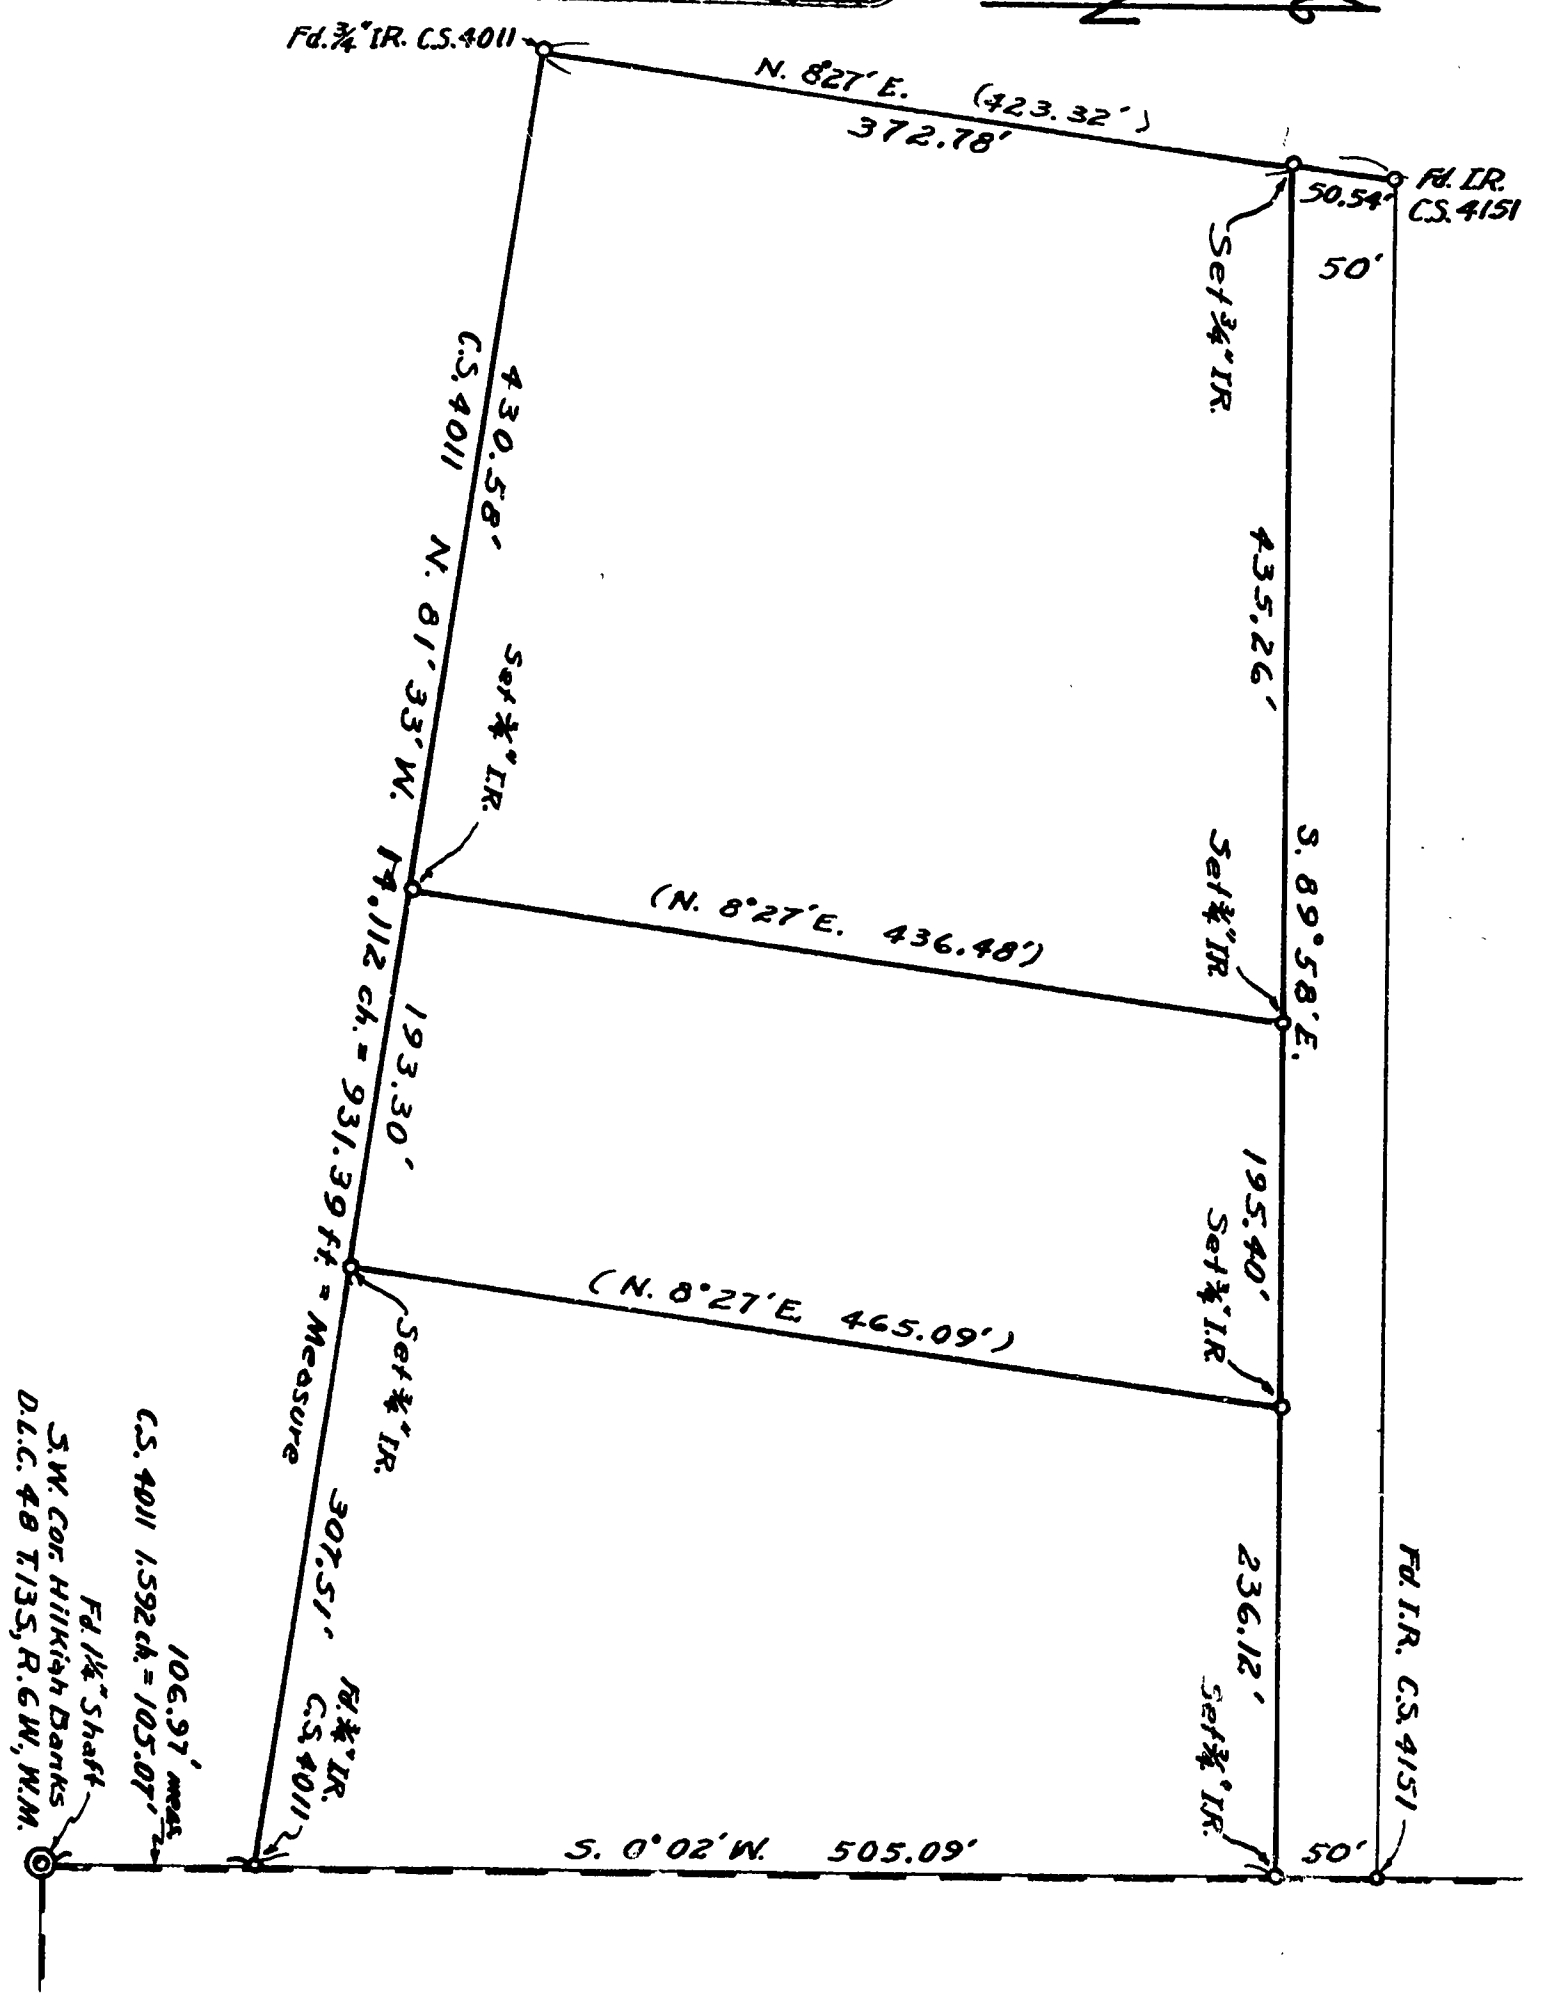


5145


GROVER CLARK  
 N.E. 1/4 SEC. 4, T. 13S., R. 6W., W.M.  
 Scale: 1" = 100'      October 5, 1971

REGISTERED  
 OREGON  
 LAND SURVEYOR  
*Martin L. Beyerlein*  
 NOV. 5, 1948  
 MARTIN L. BEYERLEIN  
 247

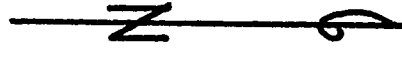

106.97' meas.  
 C.S. 4011 1.592 ch. = 105.07'  
 Fd. 1/8" Shaft  
 S.W. Cor. Hillish Danks  
 D.L.C. 48 T. 13S., R. 6W., W.M.


REEL 6      ↑      FRAME 11

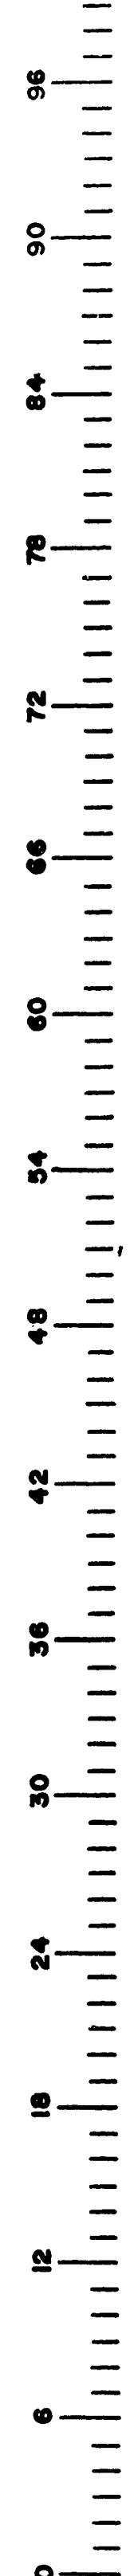

5145

GROVER CLARK  
 N.E. 1/4 SEC. 4, T. 13S., R. 6W., W. M.  
 Scale: 1" = 100'      October 5, 1971

REGISTERED  
 OREGON  
 LAND SURVEYOR  
 NOV. 5, 1948  
 MARTIN L. BEYERLEIN  
 247

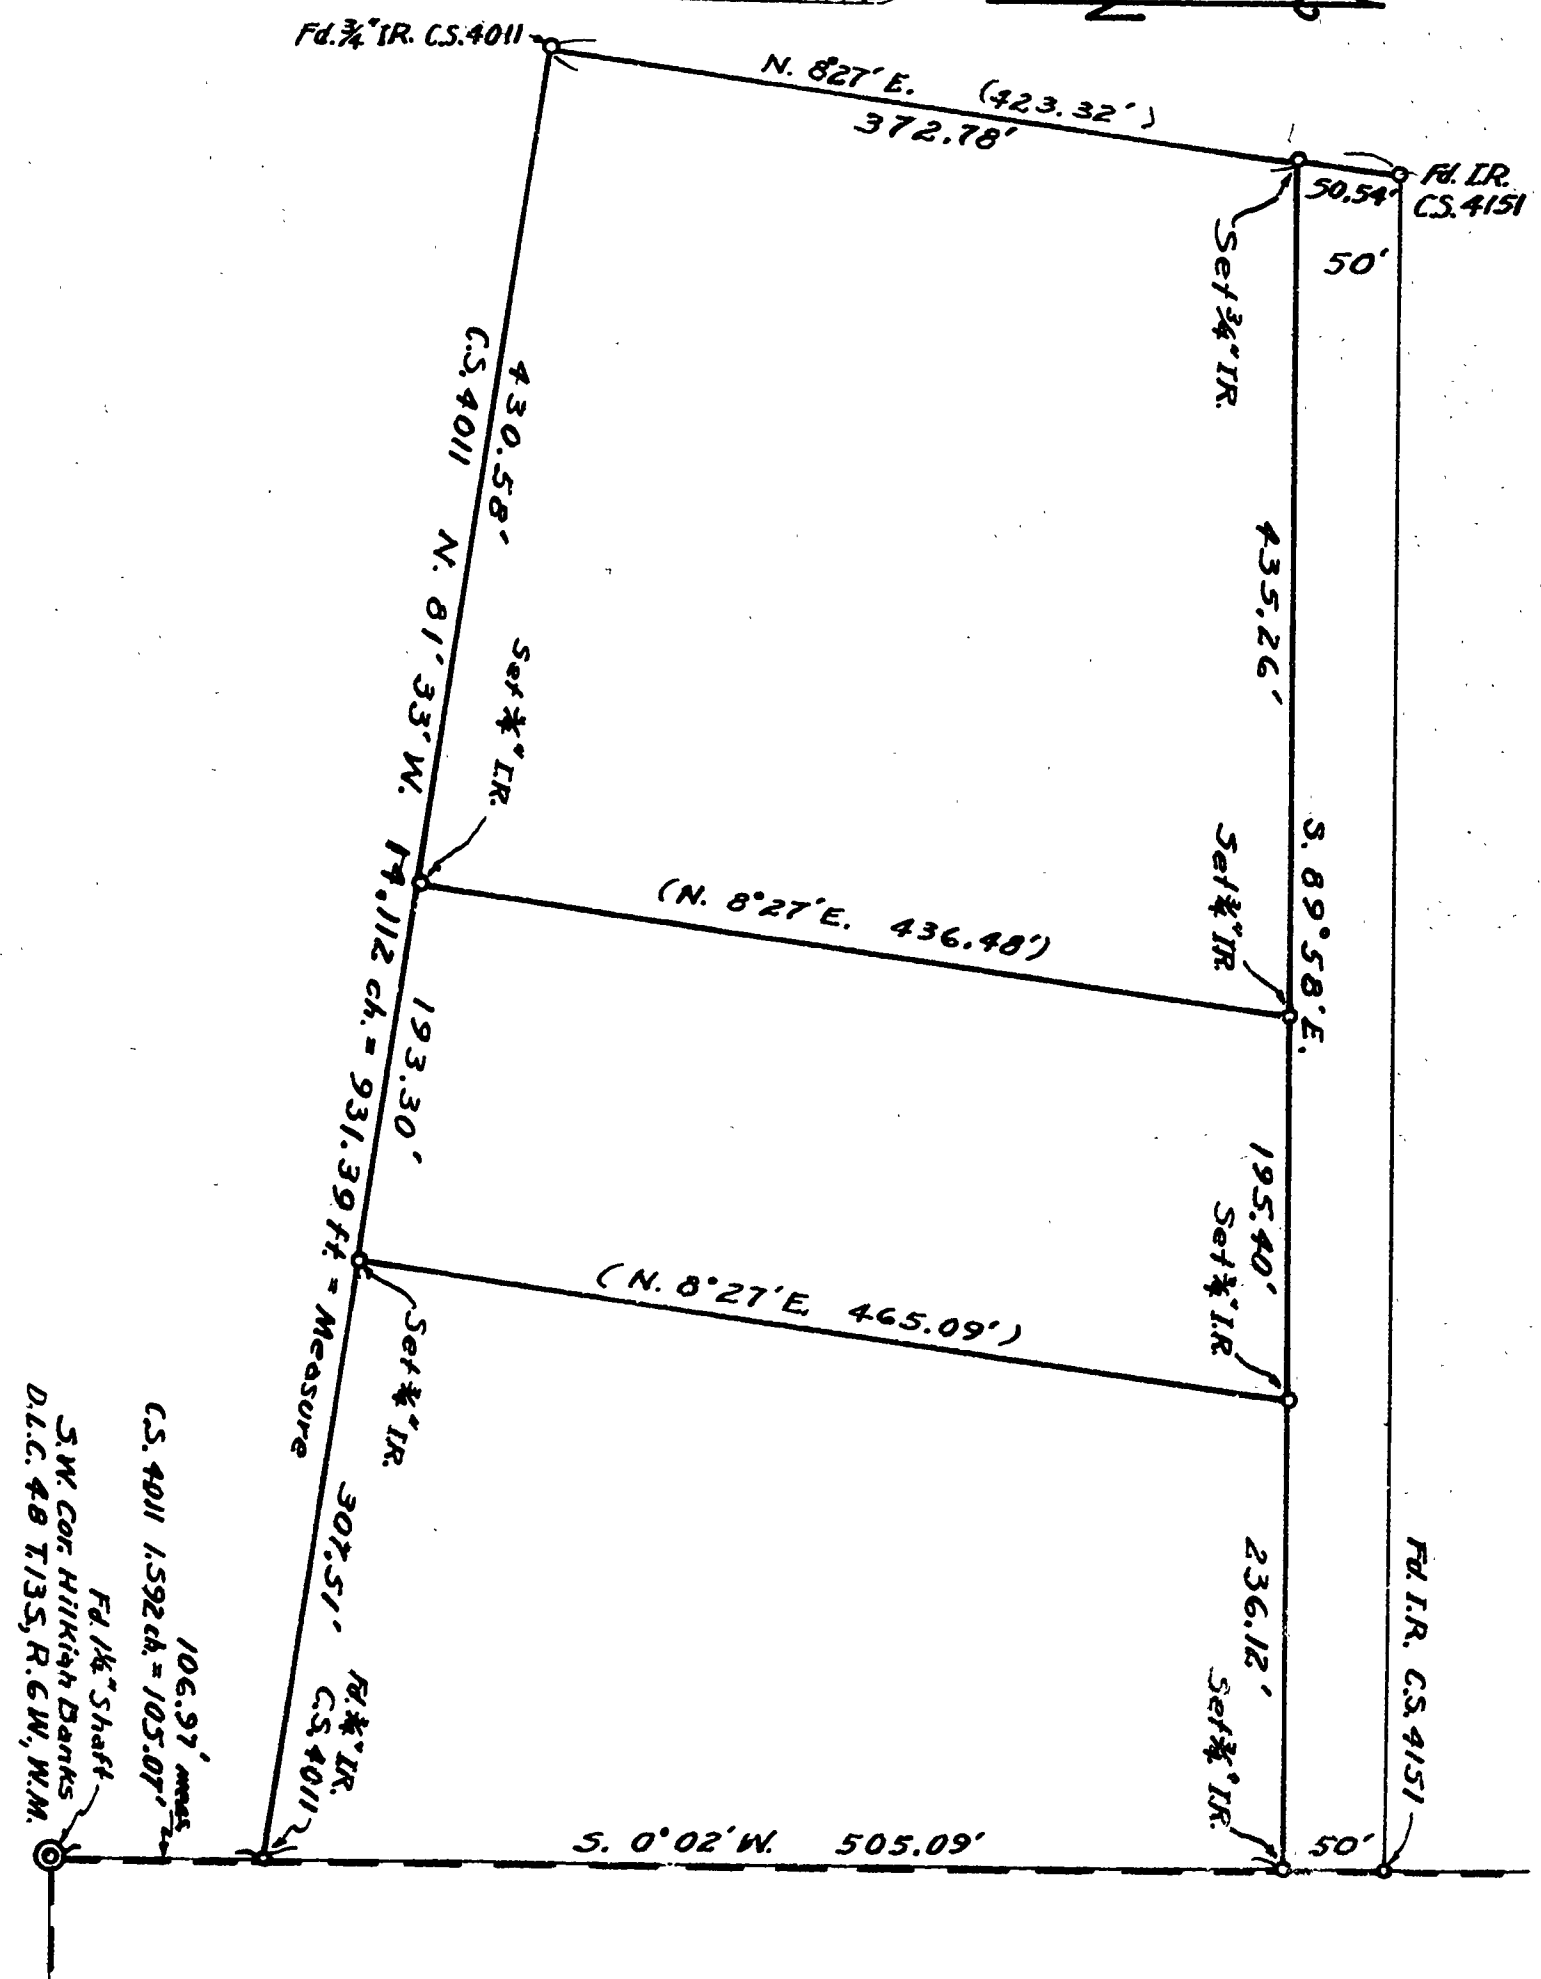

↑  
**REEL 6 FRAME 11**