


5175

Van Buren St.

Record of Curves  
For ALMA G. BARBER

Description: Lot 3 & the South 19  
feet of even width of Lot 4  
Block 13. County Add.,  
Benton County, Ore.

--- Indicates occupancy line on north  
--- Indicates occupancy line on south

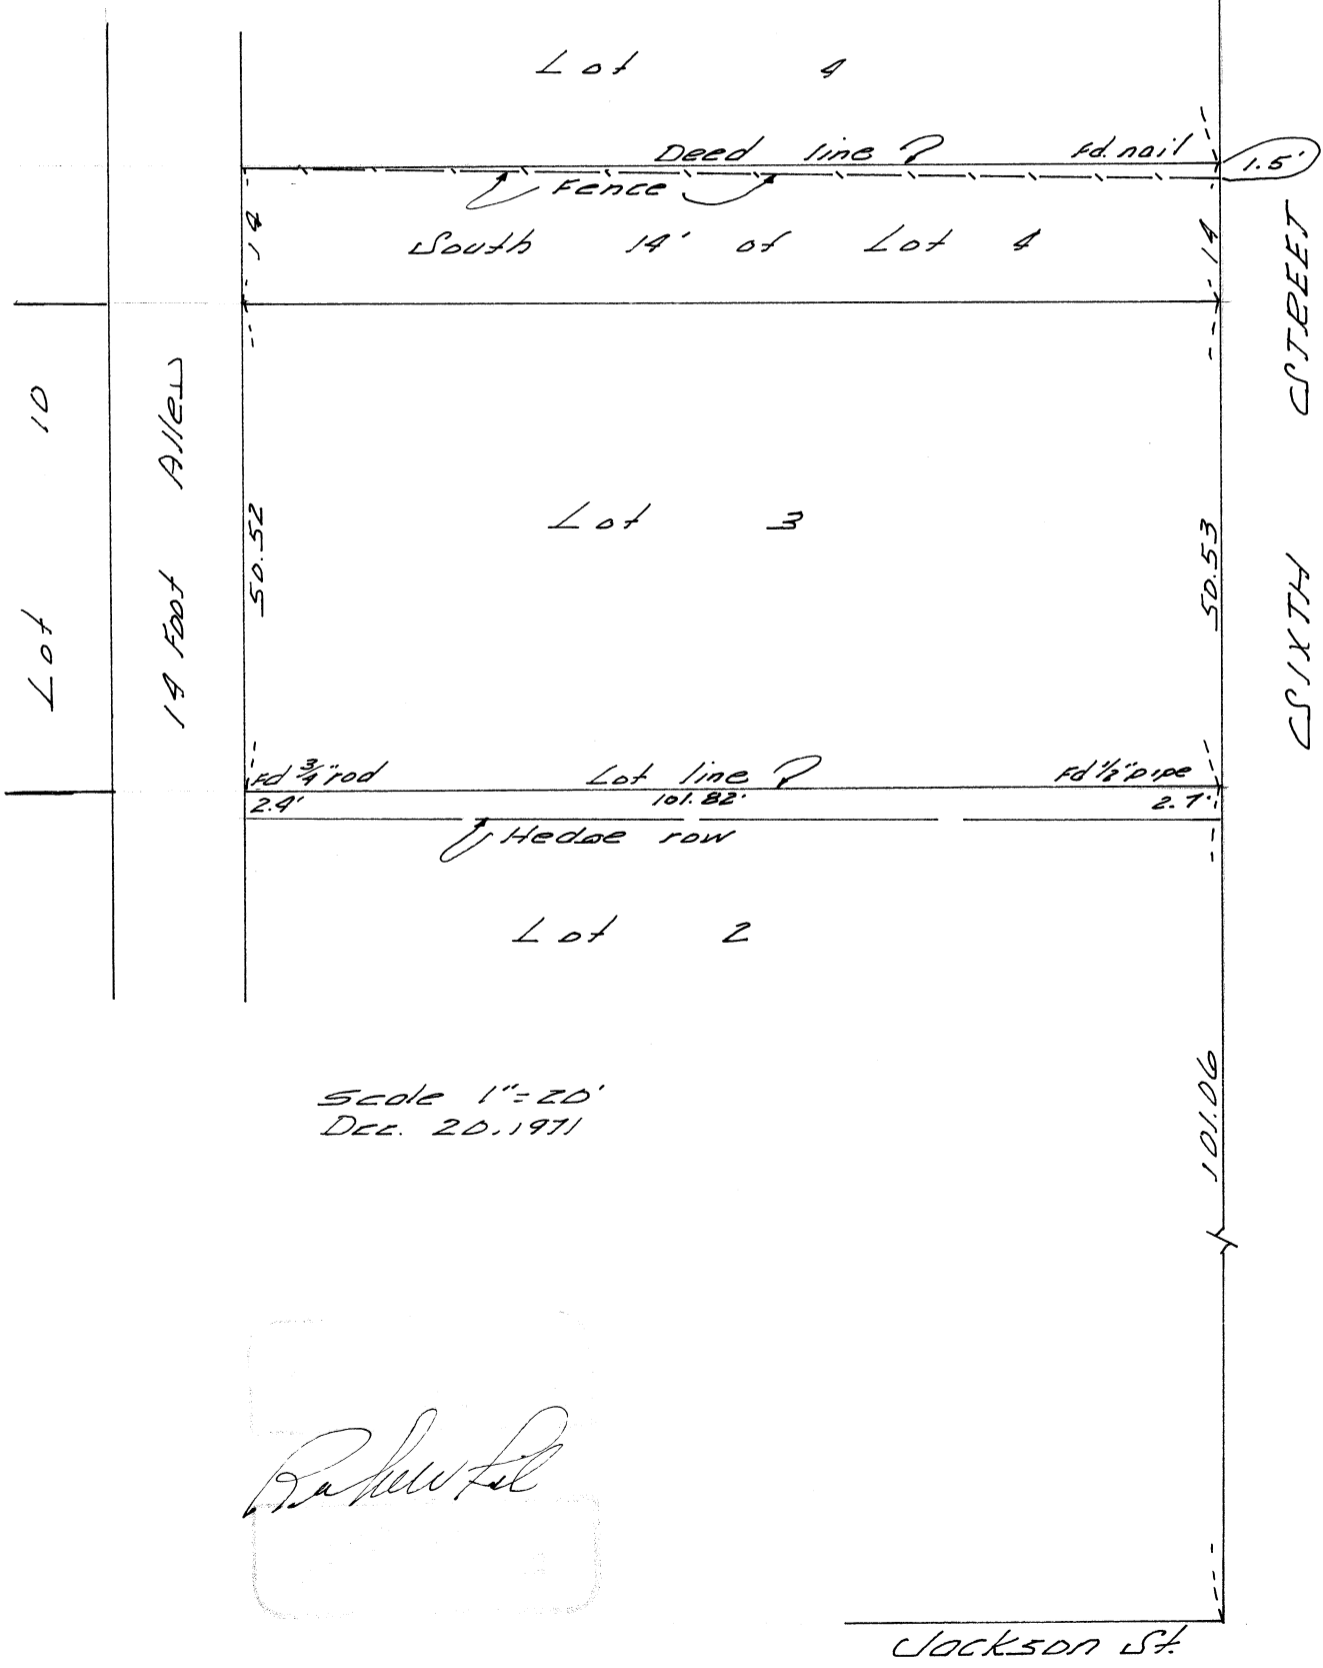

Scale 1" = 20'  
Dec. 20, 1971

*Barber*