


5187

Record of Survey  
For  
KEN BRAATEN  
Section 11, T. 12 S. R. 5 W.  
W.M. Benton Co. Ore

Scale 1" = 50'  
Jan. 13, 1972

Bearings based on  
south line of Gordon  
Thompson Addition

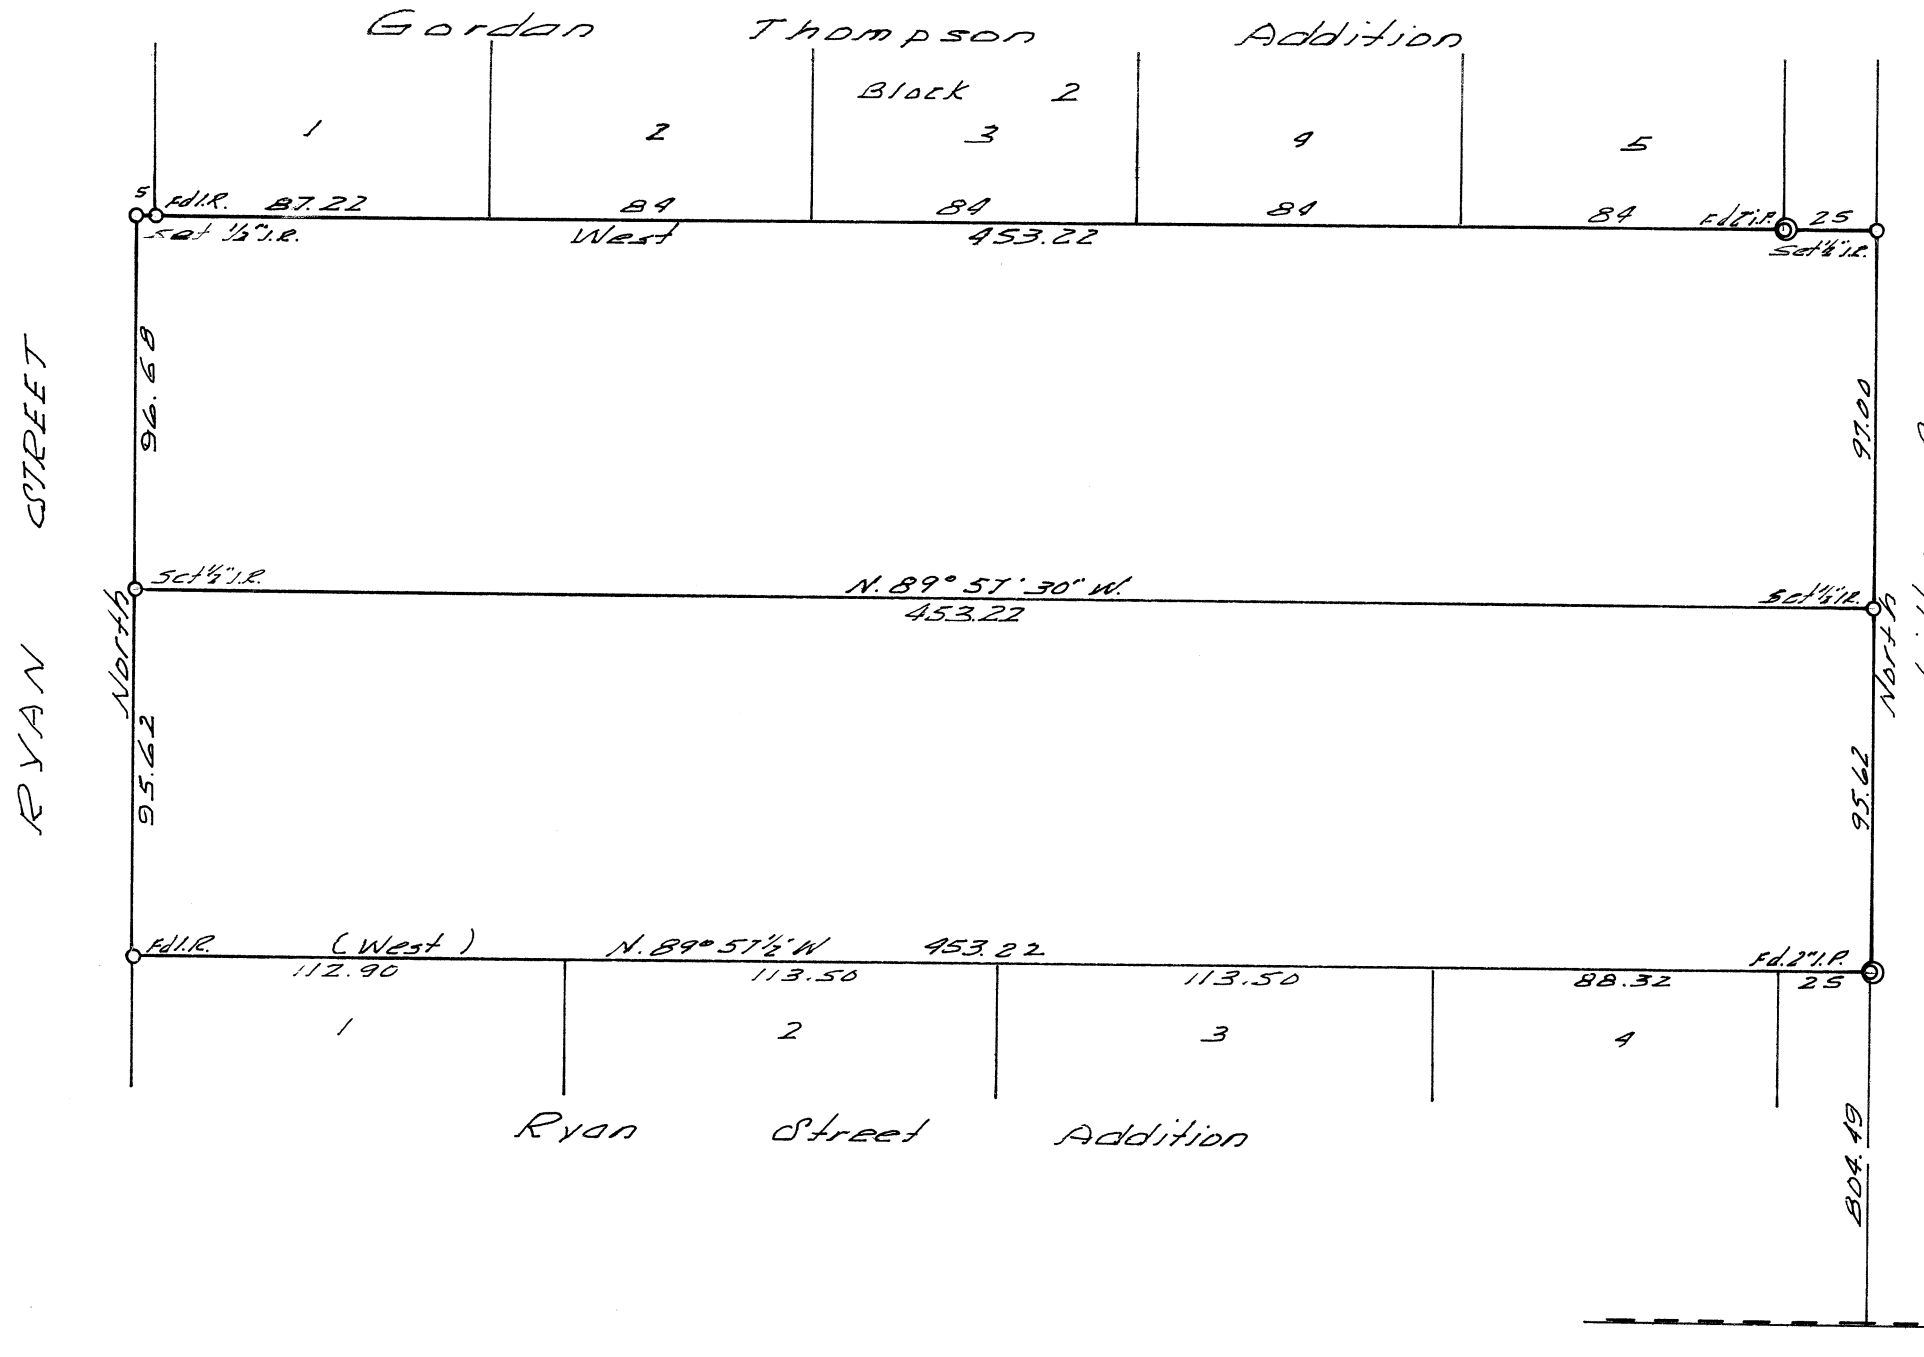

REGISTERED  
PROFESSIONAL  
LAND SURVEYOR

*Richard W. Fail*

OREGON  
NOVEMBER 4, 1955  
RICHARD W. FAIL  
357

S.E. COR.  
J.L. Alexander  
D.L.C. N° 46  
 $S. 89^{\circ} 02' W.$