


5201

JERRY WALL, et al
SEC. 32 T. 14 S., R. 5 W. W. M.
SEC. 5 T. 15 S., R. 5 W. W. M.
BENTON CO., OREGON

NOV. 10, 1971

SCALE 1" = 200'

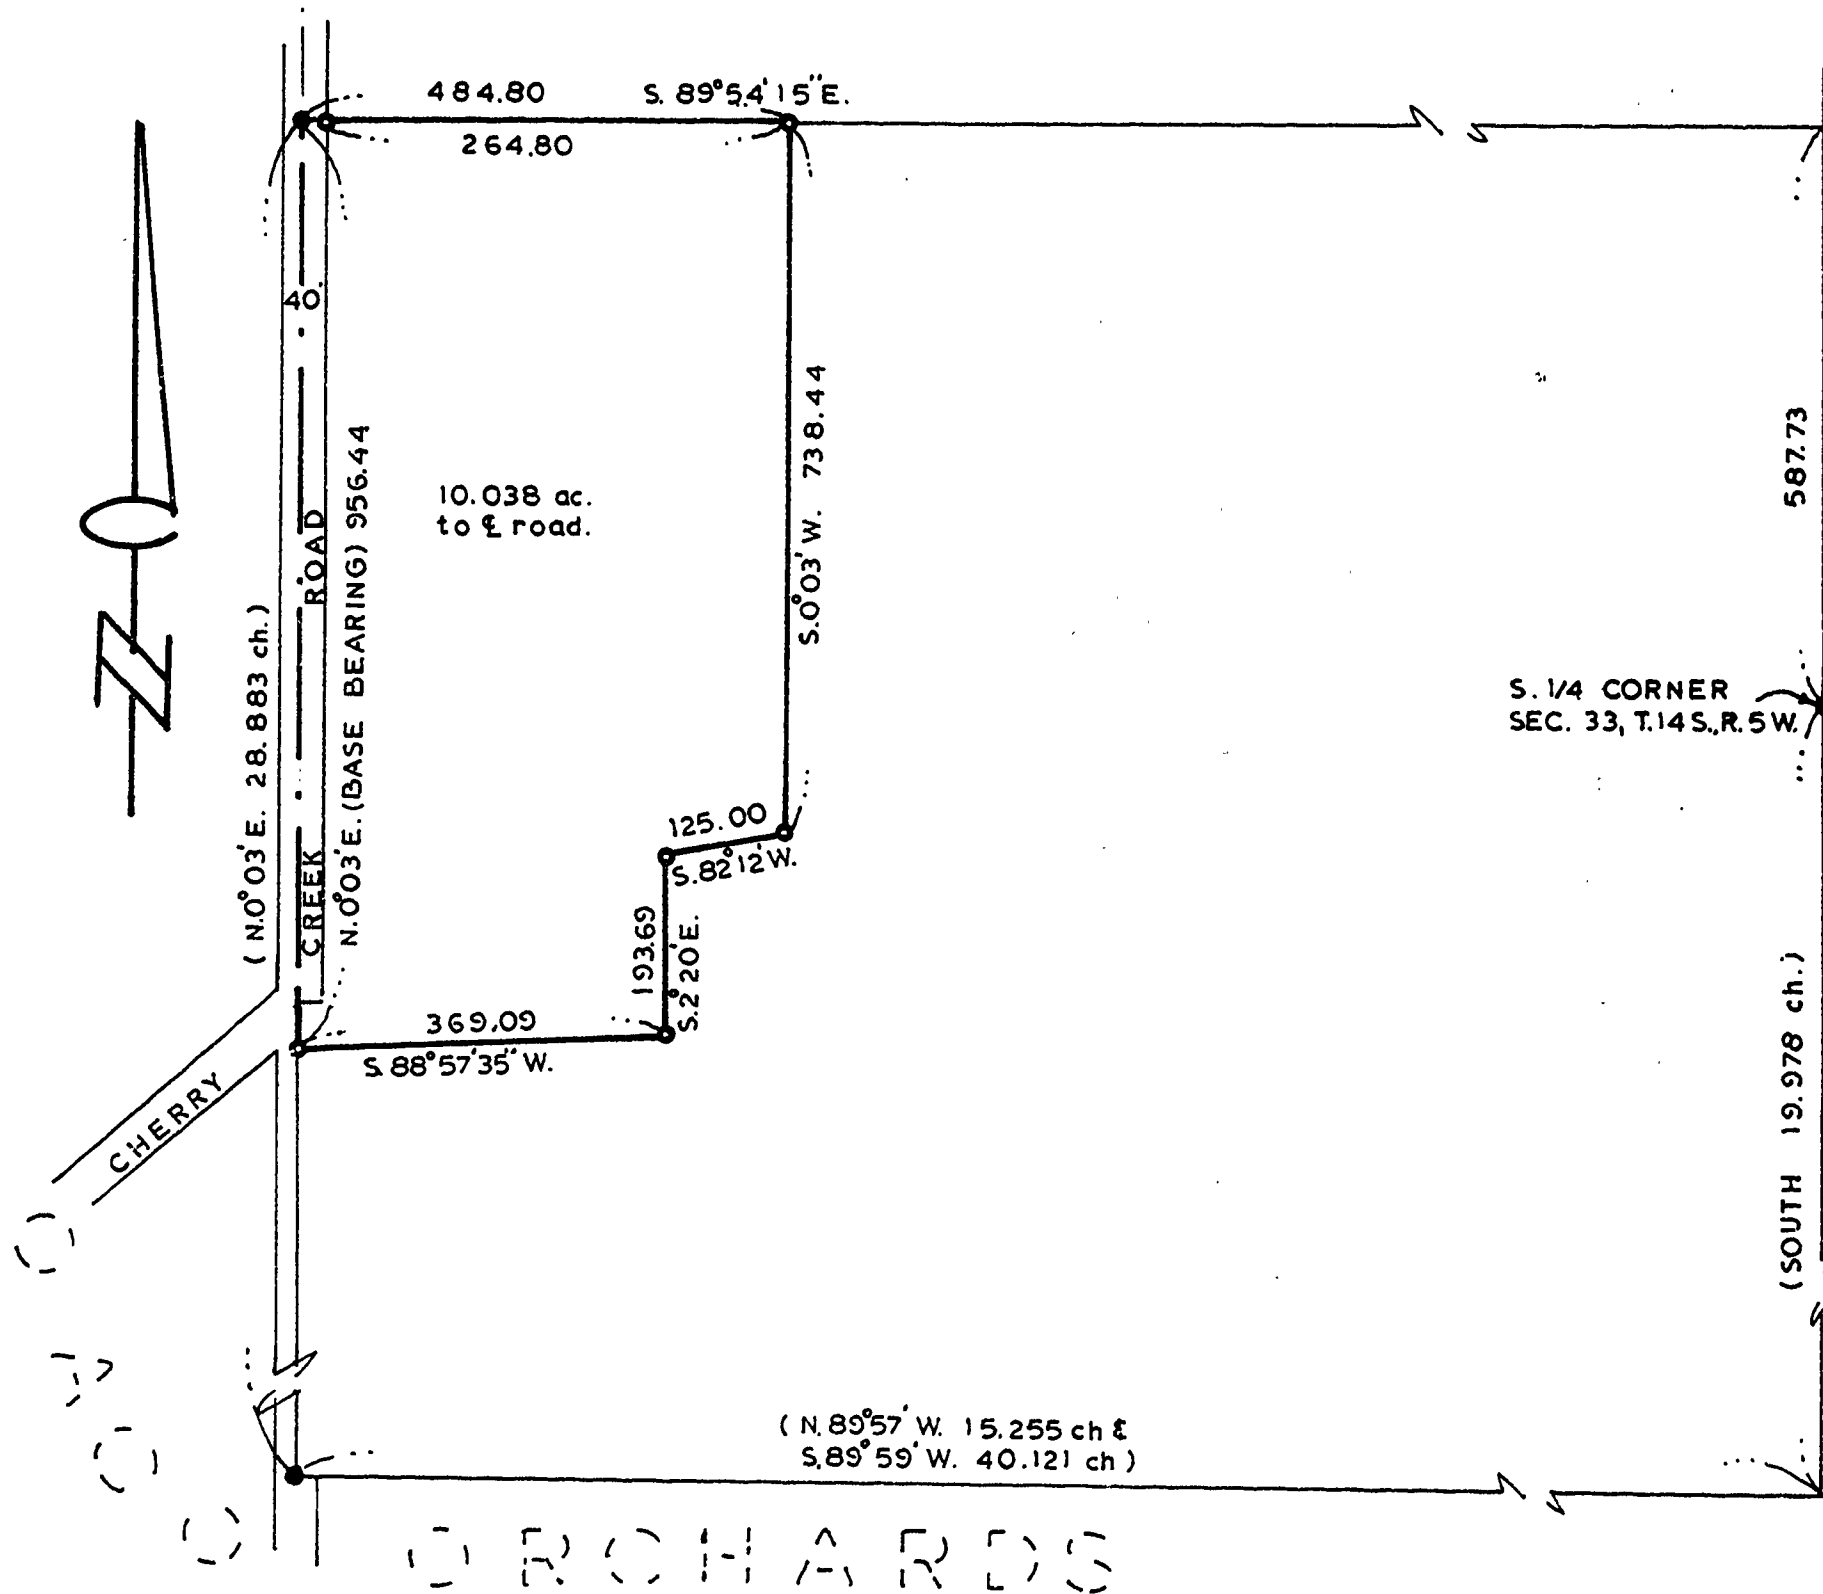

REGISTERED
OREGON
LAND SURVEYOR

R. S. Castleberry
HARRISBURG, OREGON

JULY 9, 1965
R. S. Castleberry
684

— LEGEND —

- 3/4" IRON PIPE FOUND
- 5/8" IRON ROD SET