

5306

Record of Survey

for

C.E. JONES

at the


Southeast corner of Section 26

T12S R5W WB&M

Benton Co. Oregon

Scale 1" = 100' January 11, 1972

Bearings from Solar Observation

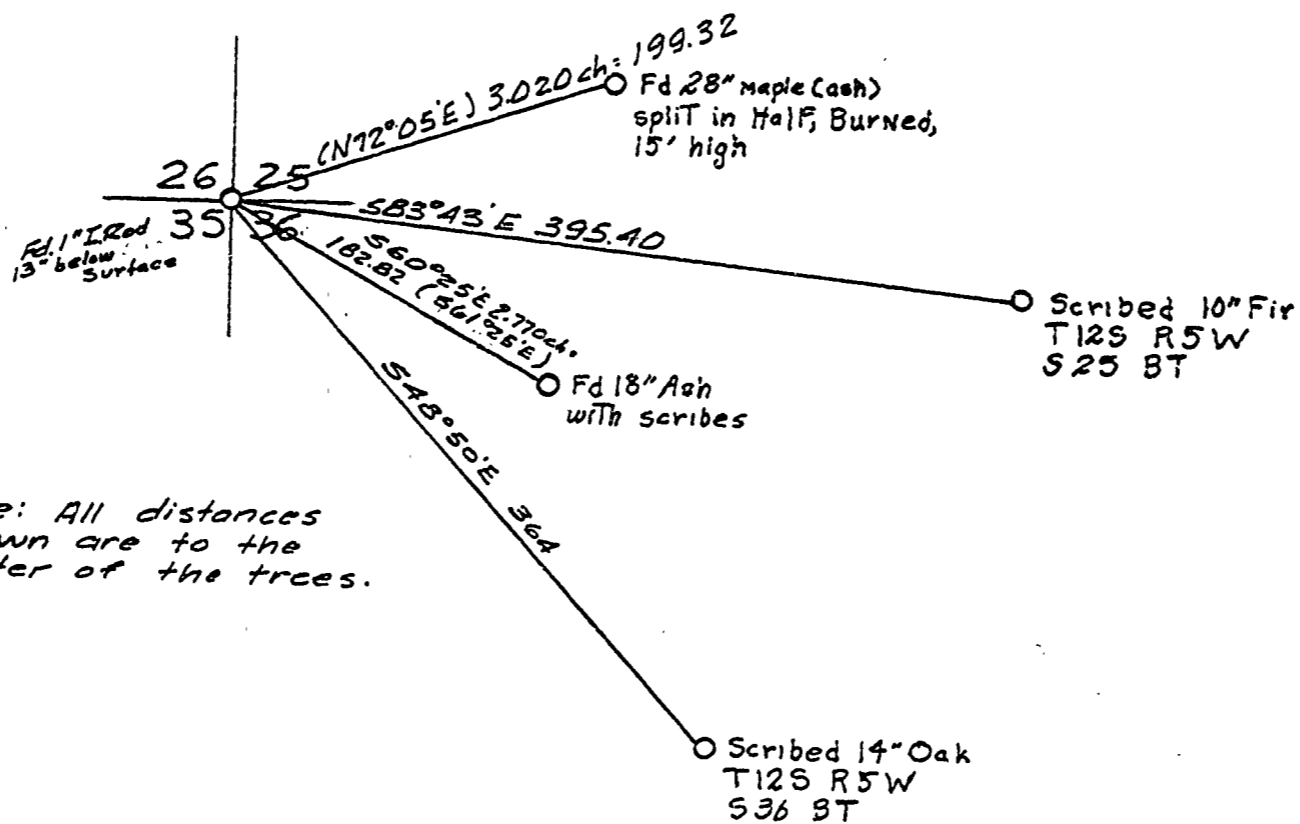

Note: All distances shown are to the center of the trees.

Parentheses indicate information from County Survey records or deeds.

REGISTERED PROFESSIONAL LAND SURVEYOR

Verle C. Moore

OREGON MAY 13, 1960 VERLE C. MOORE 501