

CS 5474

SURVEY FOR: BILL NORED

IN BLOCK 11, LOT 6 of JOHNSONS' ADDITION  
TO CORVALLIS, BENTON COUNTY, OREGON


SCALE 1" = 10'

JUNE 4, 1973

REGISTERED  
PROFESSIONAL  
LAND SURVEYOR

*Fred I. Lemke*

OREGON  
MAY 2, 1958  
FRED I. LEMKE  
443

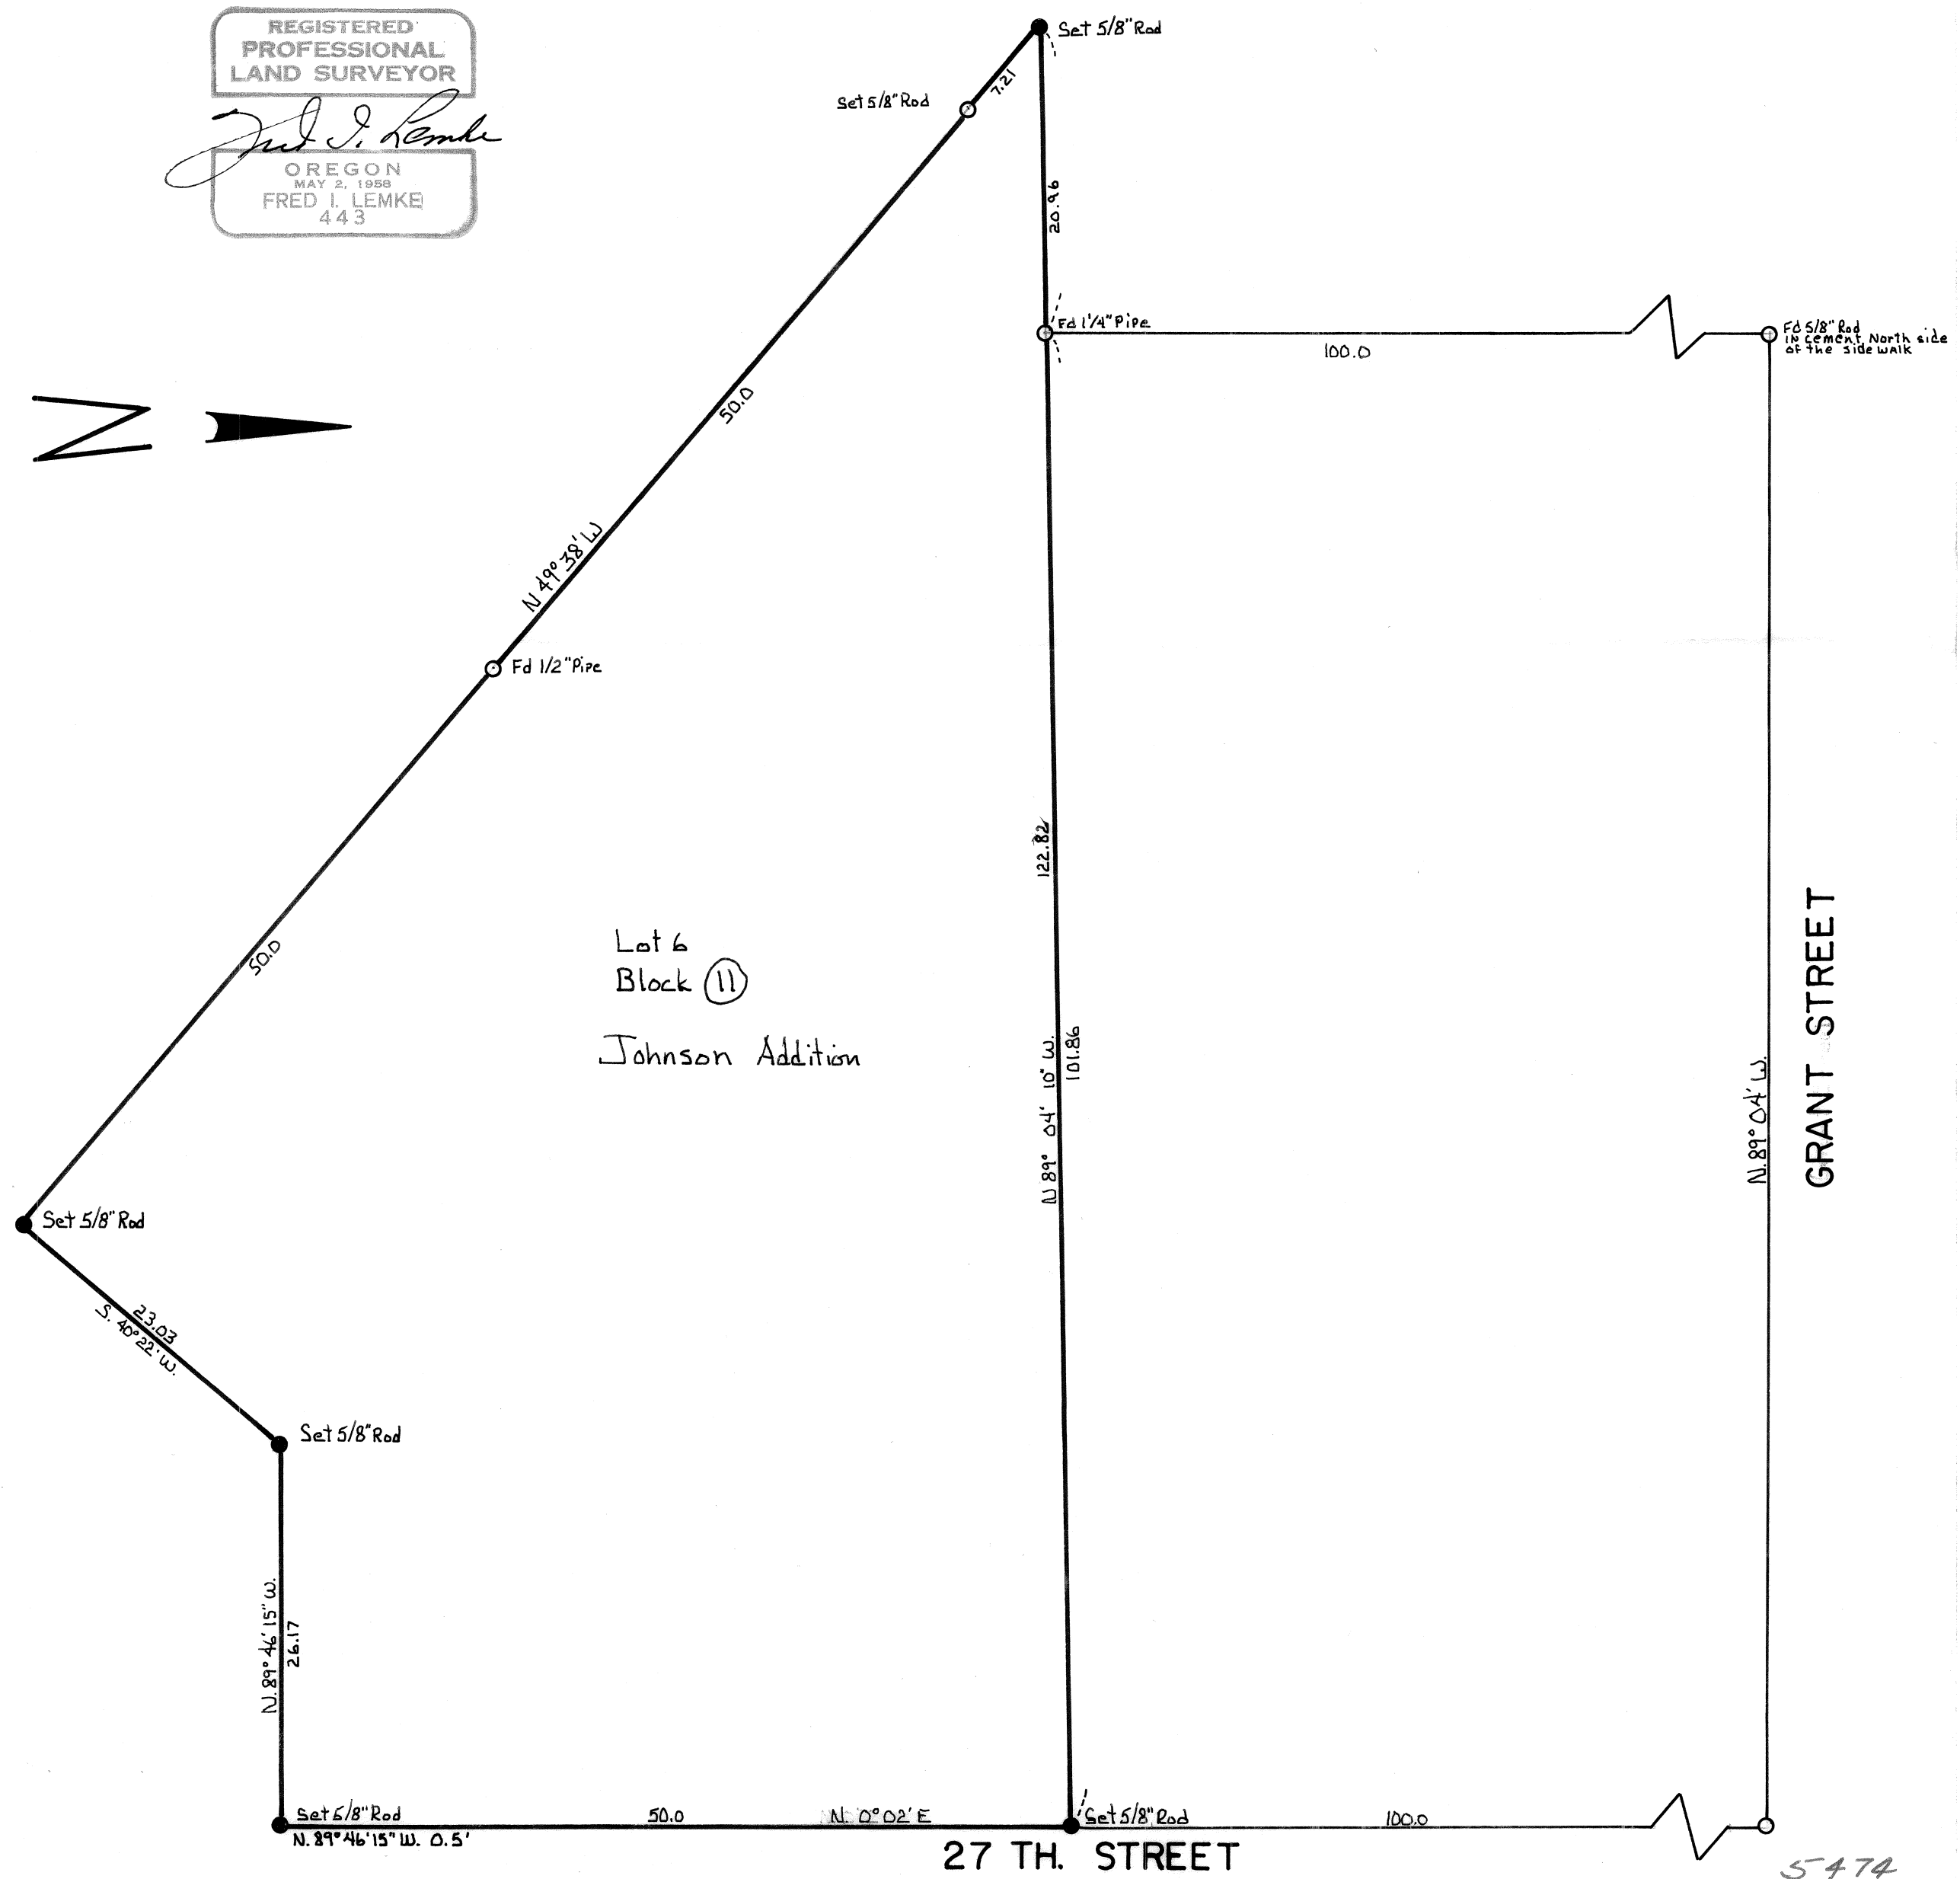

Lot 6  
Block 11  
Johnson Addition

GRANT STREET

27 TH. STREET

5474

5474