

C S 5526
SURVEY FOR: E.F. CARVER

In ISLAND ACRES, On Kiger Island


Township 12 South, Range 5 West of The W.M.

Benton County, Oregon

Scale 1" = 330'

JUNE 22, 1973

Ref. material C.S. 86 & 186 & Island Acres Plat.

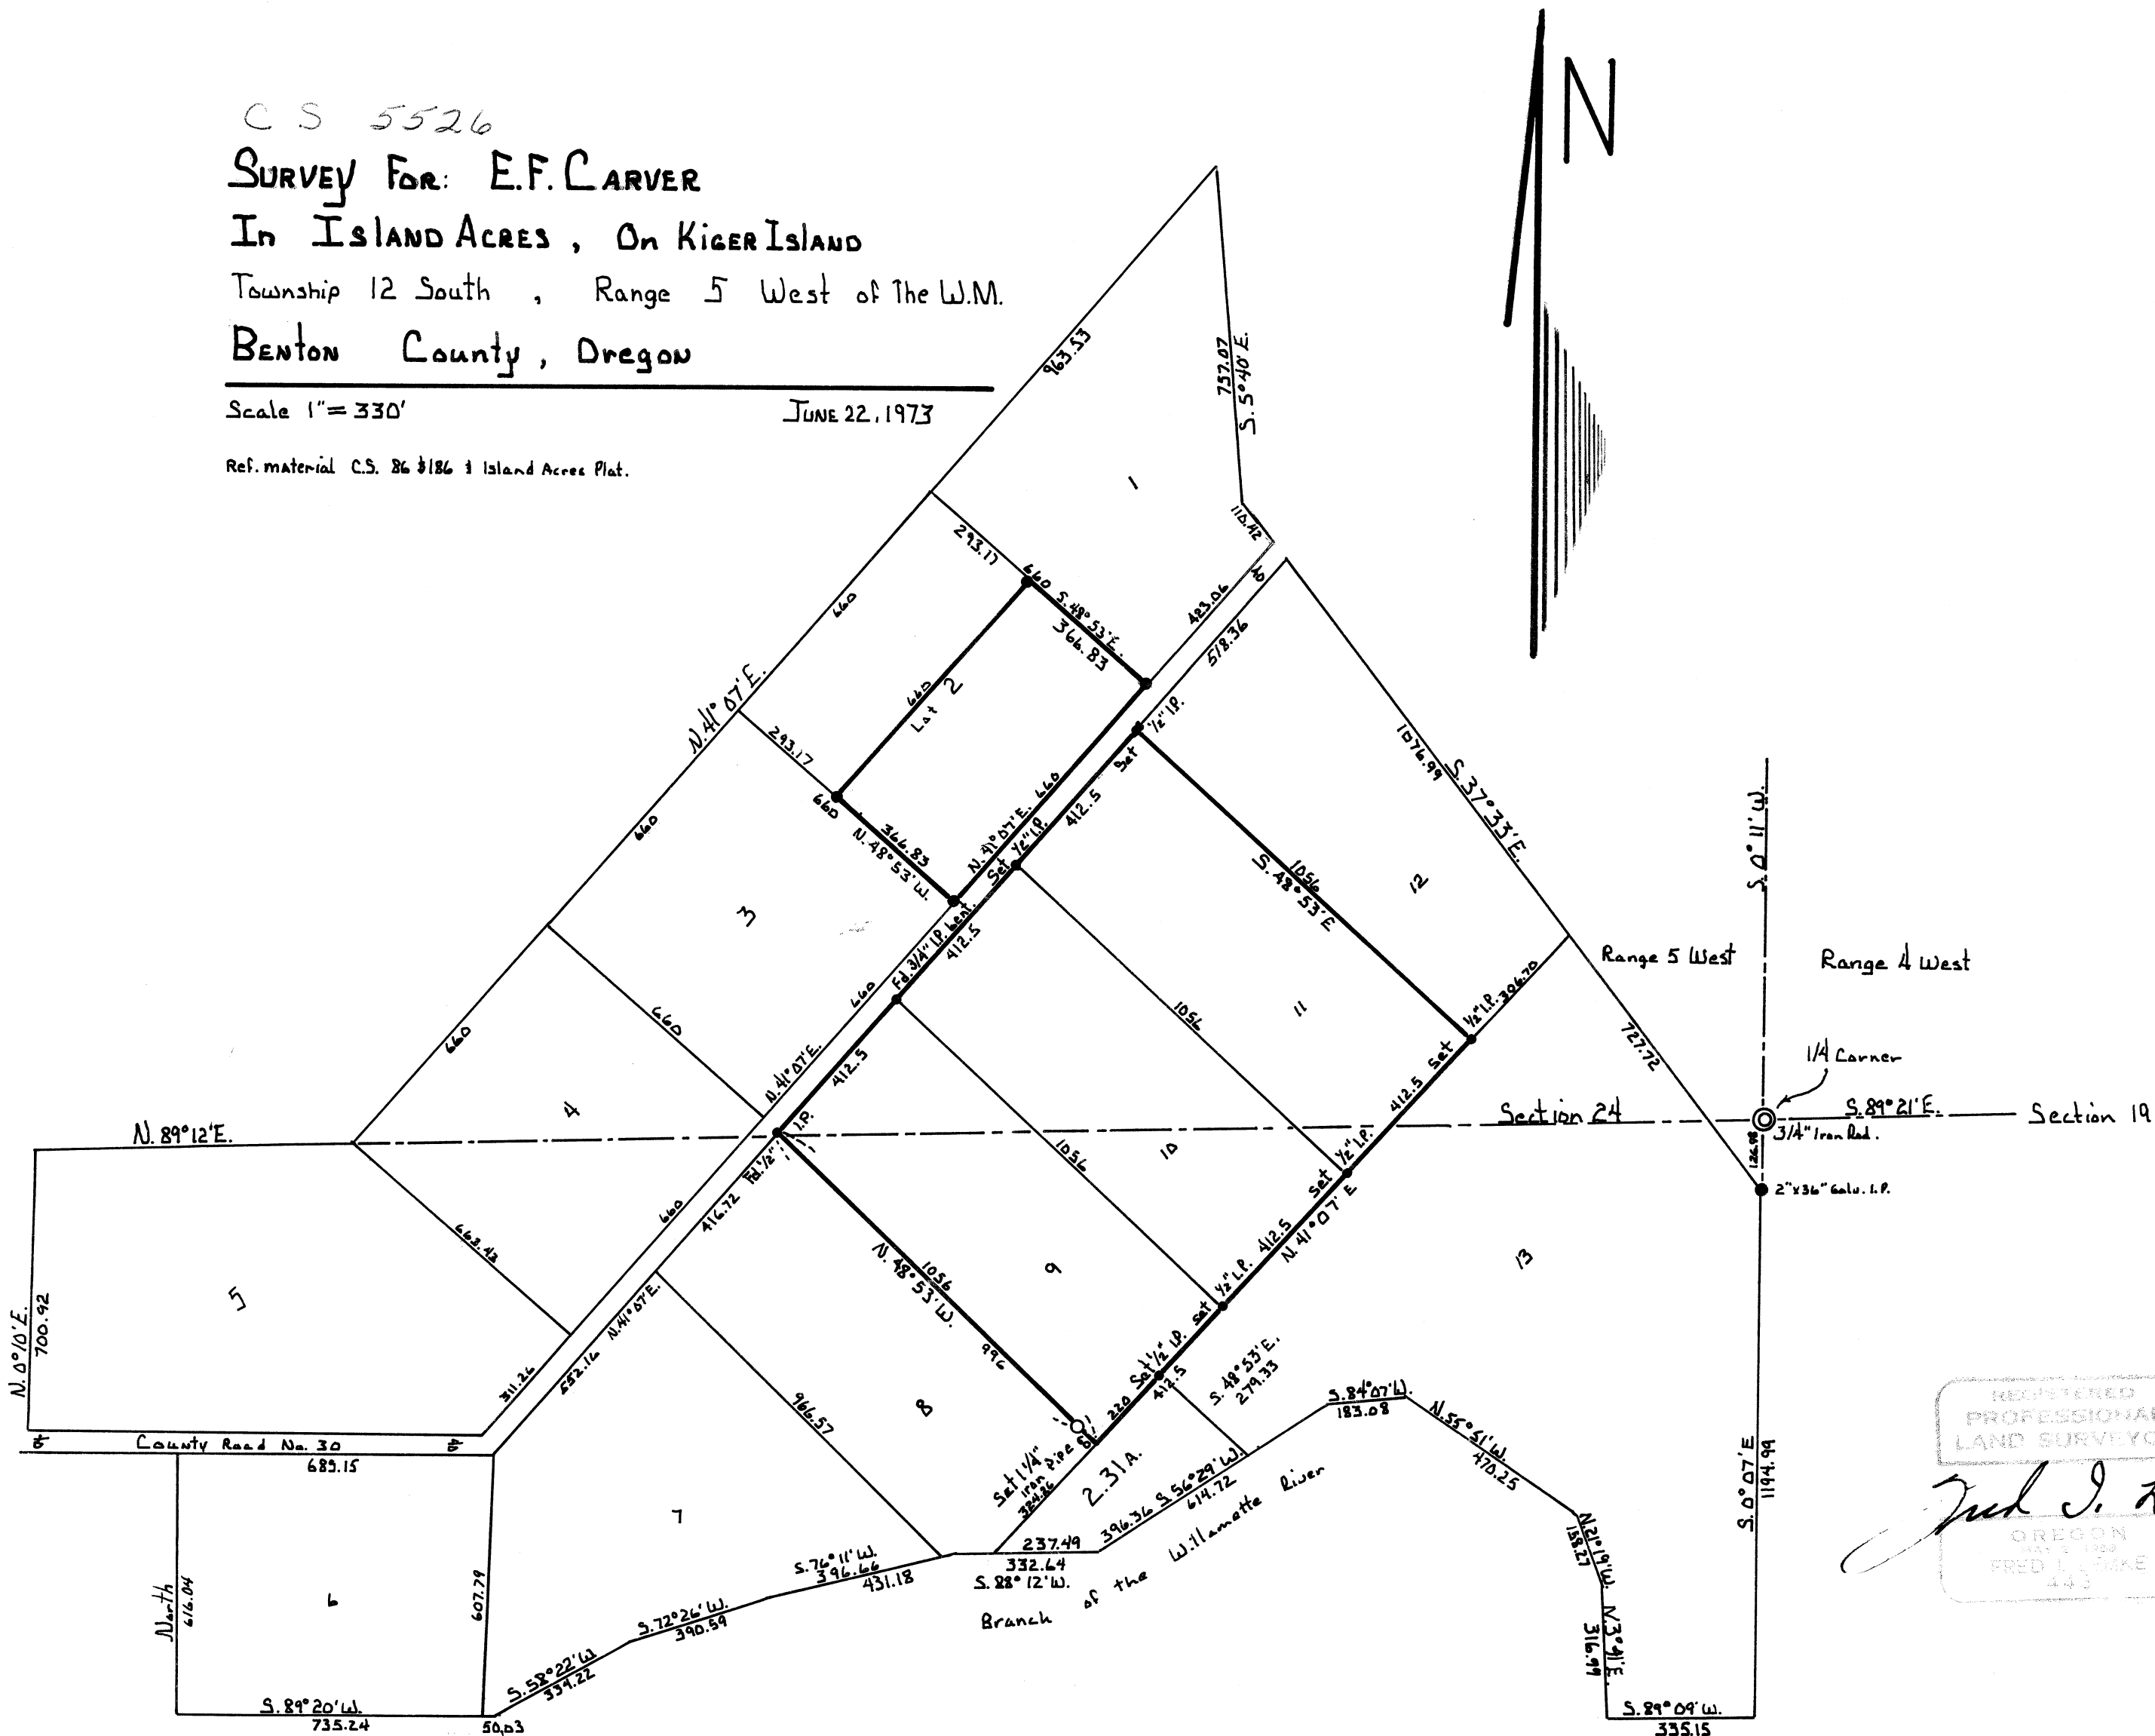

REGISTERED
PROFESSIONAL
LAND SURVEYOR

OREGON
MAY 2, 1969
FRED J. LEMAE
443

Fred J. Lemae