

CS 5541

SURVEY FOR MARVIN C. ELLIS  
IN THE EDWIN A. ABBEY D.L.C. NO. 51  
T. 12 S. R. 5 W. of the WM.  
BENTON COUNTY, OREGON

SCALE 1" = 50'



MARCH 30, 1973

JOB NUMBER 73-19

REGISTERED  
PROFESSIONAL  
LAND SURVEYOR

*Fred J. Lemke*

OREGON  
MAY 2, 1958  
FRED J. LEMKE  
443

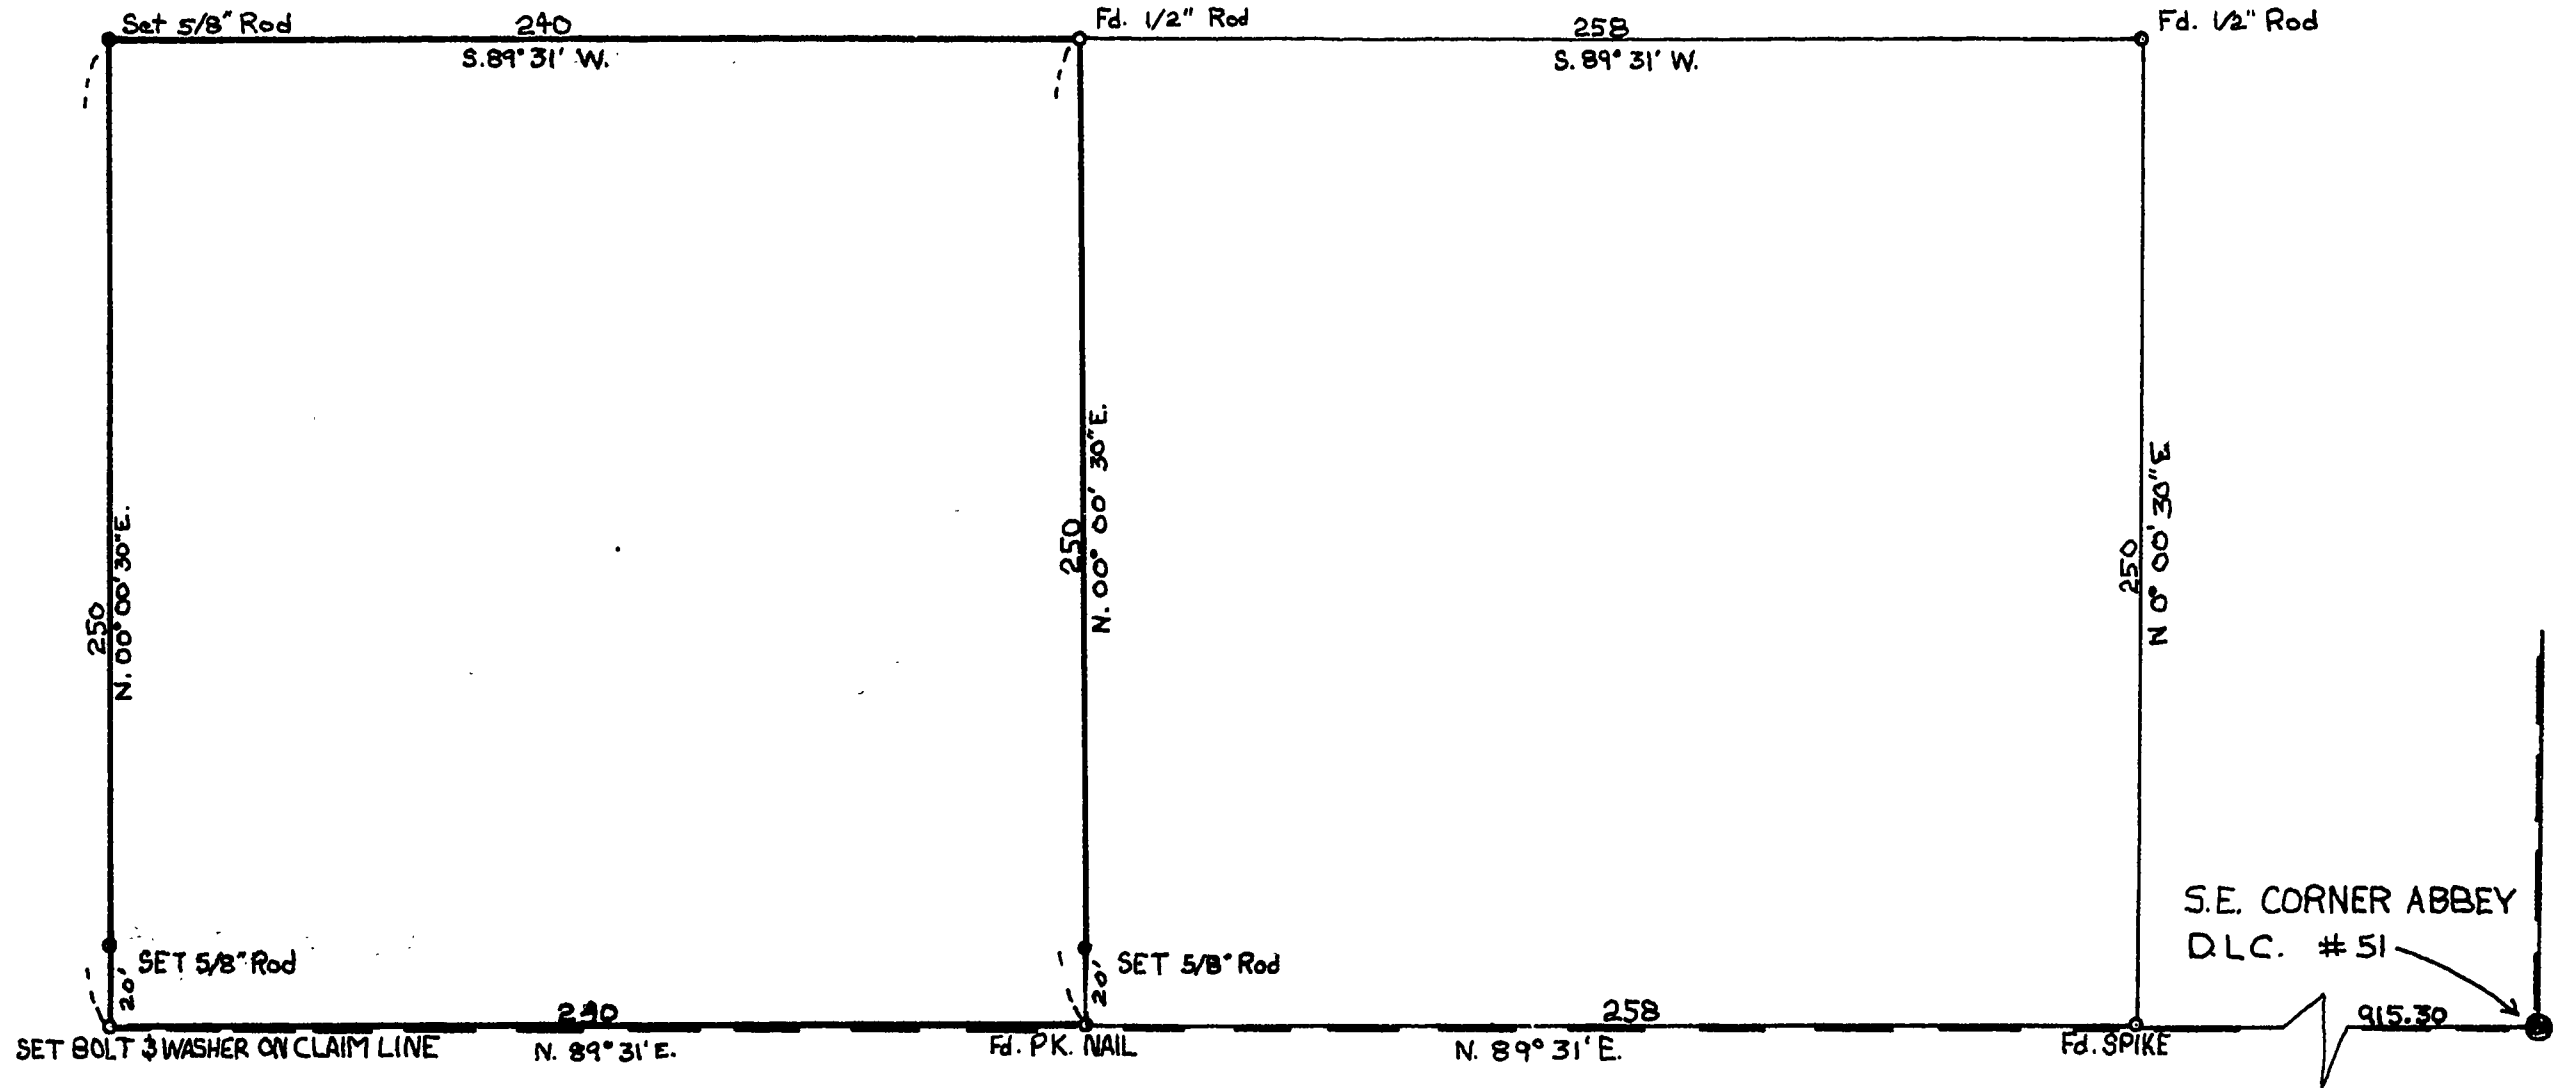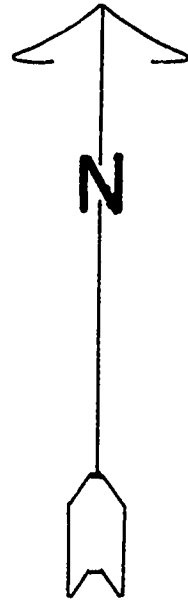

DWG. NO. 701