

C.S. 5577

RECORD OF SURVEY


FOR ALAN DAPP

IN The Northwest 1/4, Section 15

Township 11 South, Range 5 West, W. M.

Benton County, Oregon August, 1973

Scale: 1" = 100'

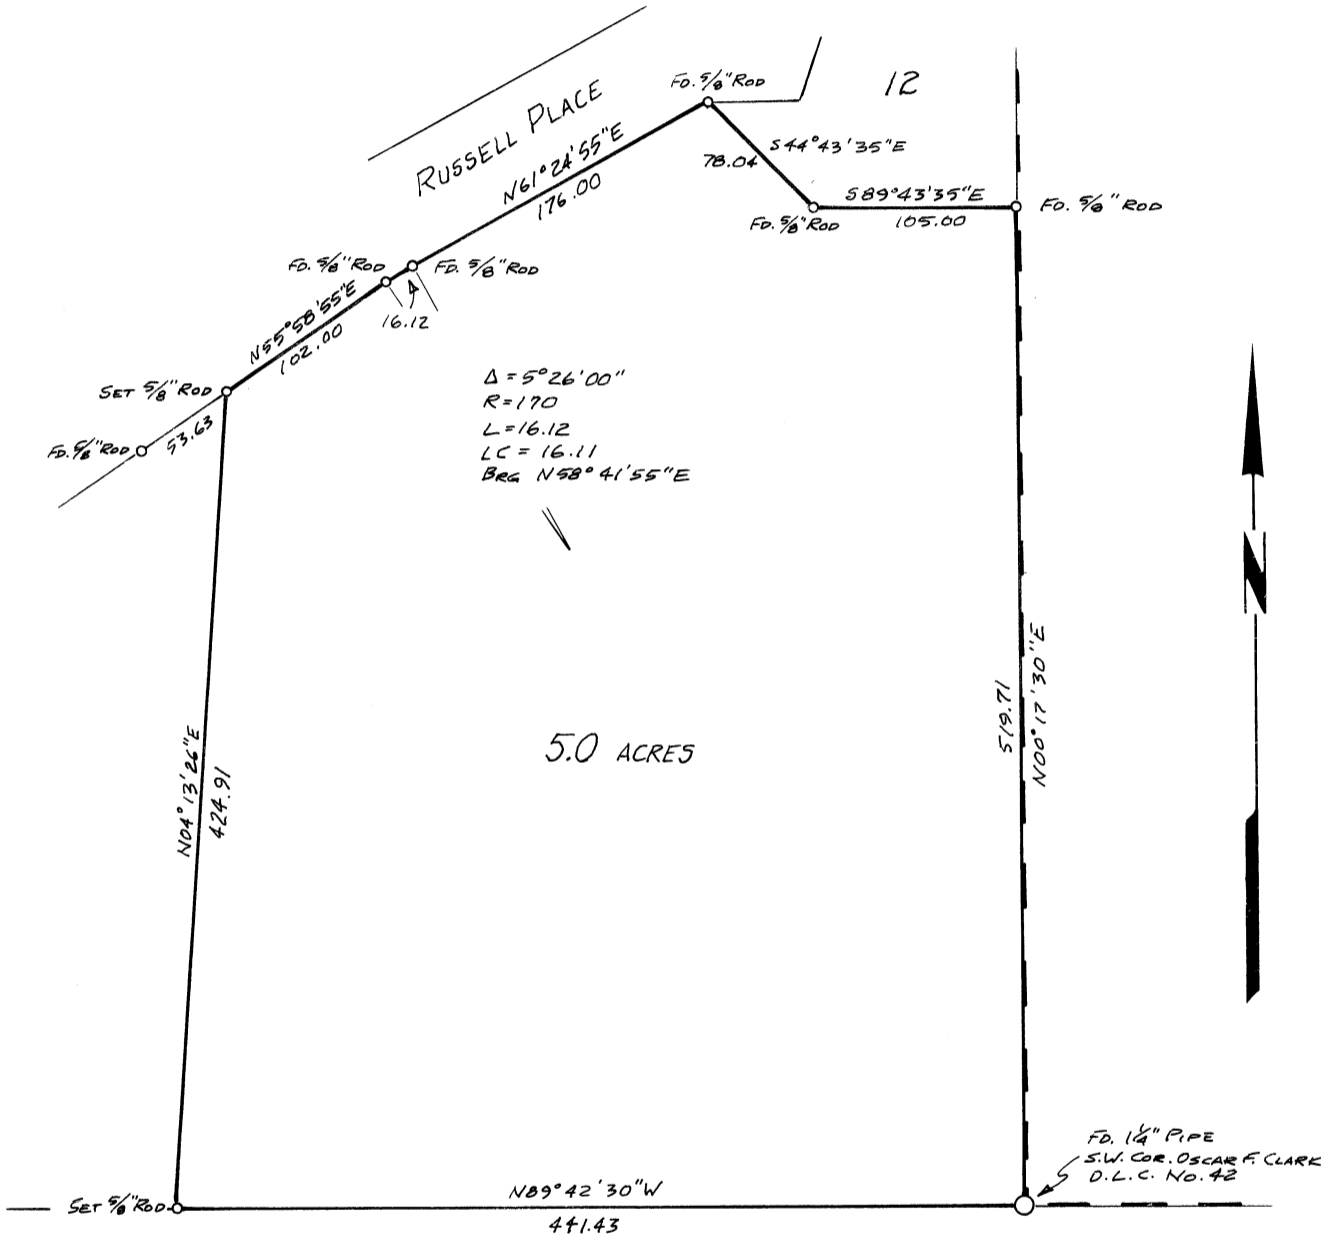

REGISTERED
PROFESSIONAL
LAND SURVEYOR

Nick A. Yinger

OREGON
JULY 12, 1963
NICK A. YINGER
876