


5614

DARREL D. CLEVELAND  
 IN WILLIAM J. JOHNSON D.L.C. 63  
 NE 1/4 SEC. 27, T. 10 S., R. 4 W., W.M.  
 BENTON COUNTY, OREGON  
 Scale: 1" = 100'  
 January 9, 1974

Orris A. Carnegie  
 R.P.L.S. No. 213

5614

Based on  
C.S. 4857

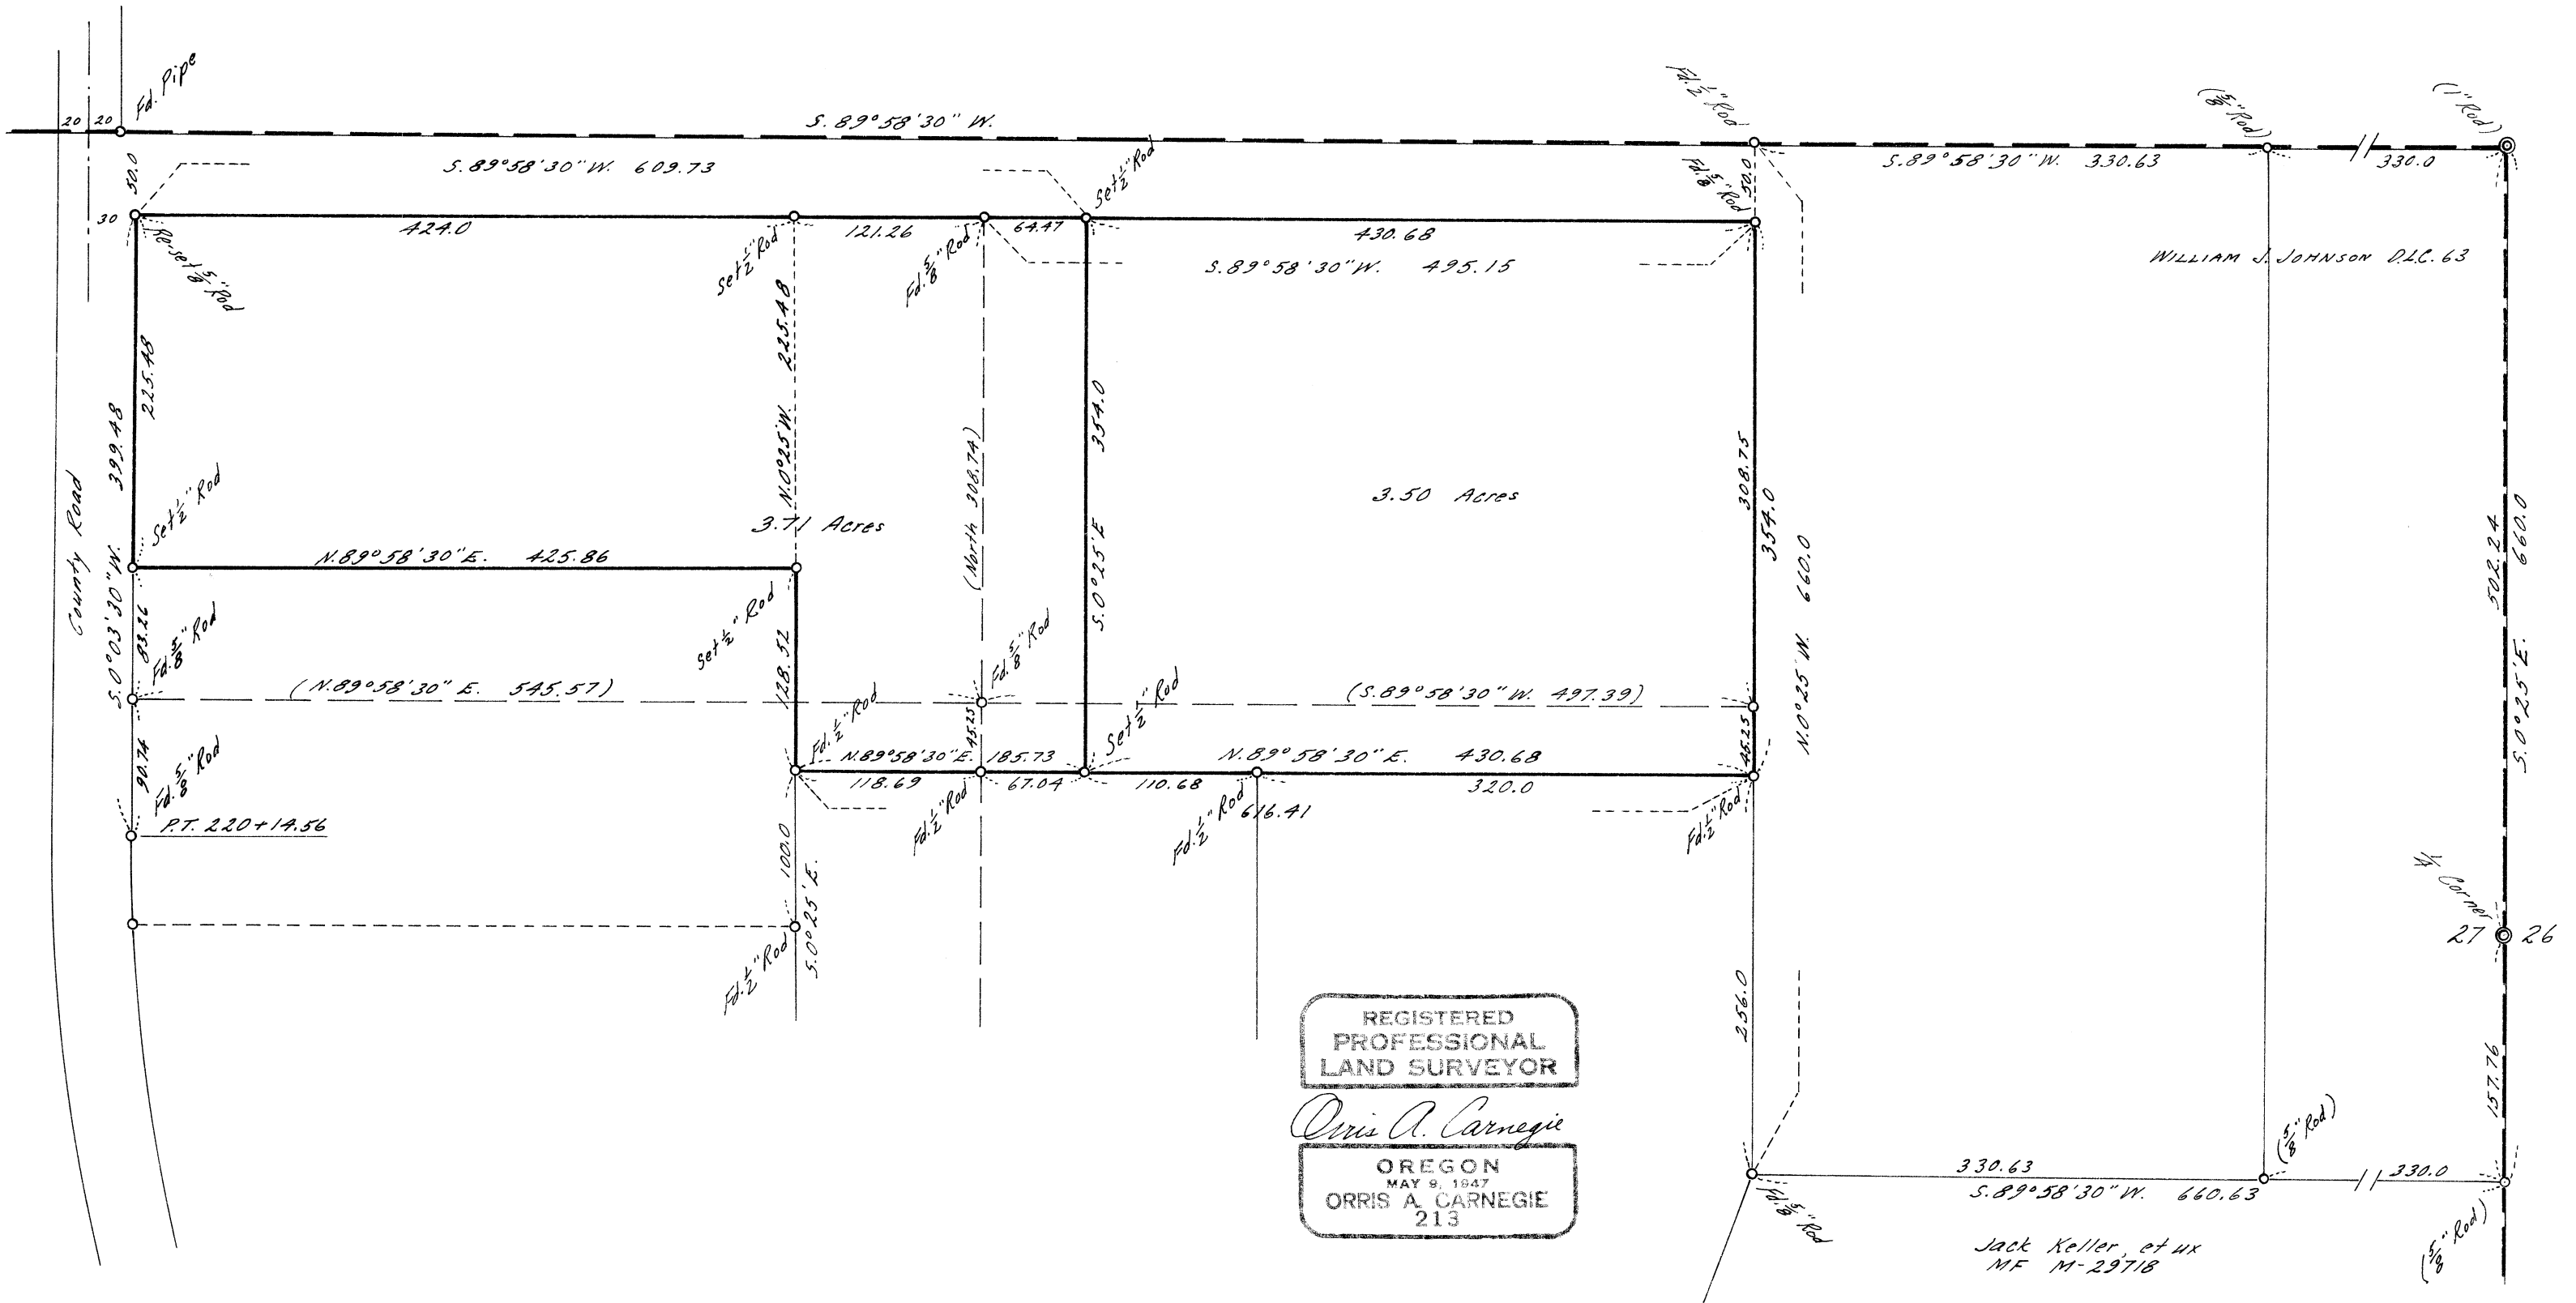

5614