


SURVEY FOR: BEARDSLEY & GRANT  
 IN TRACTS 6 & 7 LINCOLN TRACTS  
 CORVALLIS, BENTON COUNTY, OR.  
 MARCH, 1974 SCALE 1" = 50'  
 5662

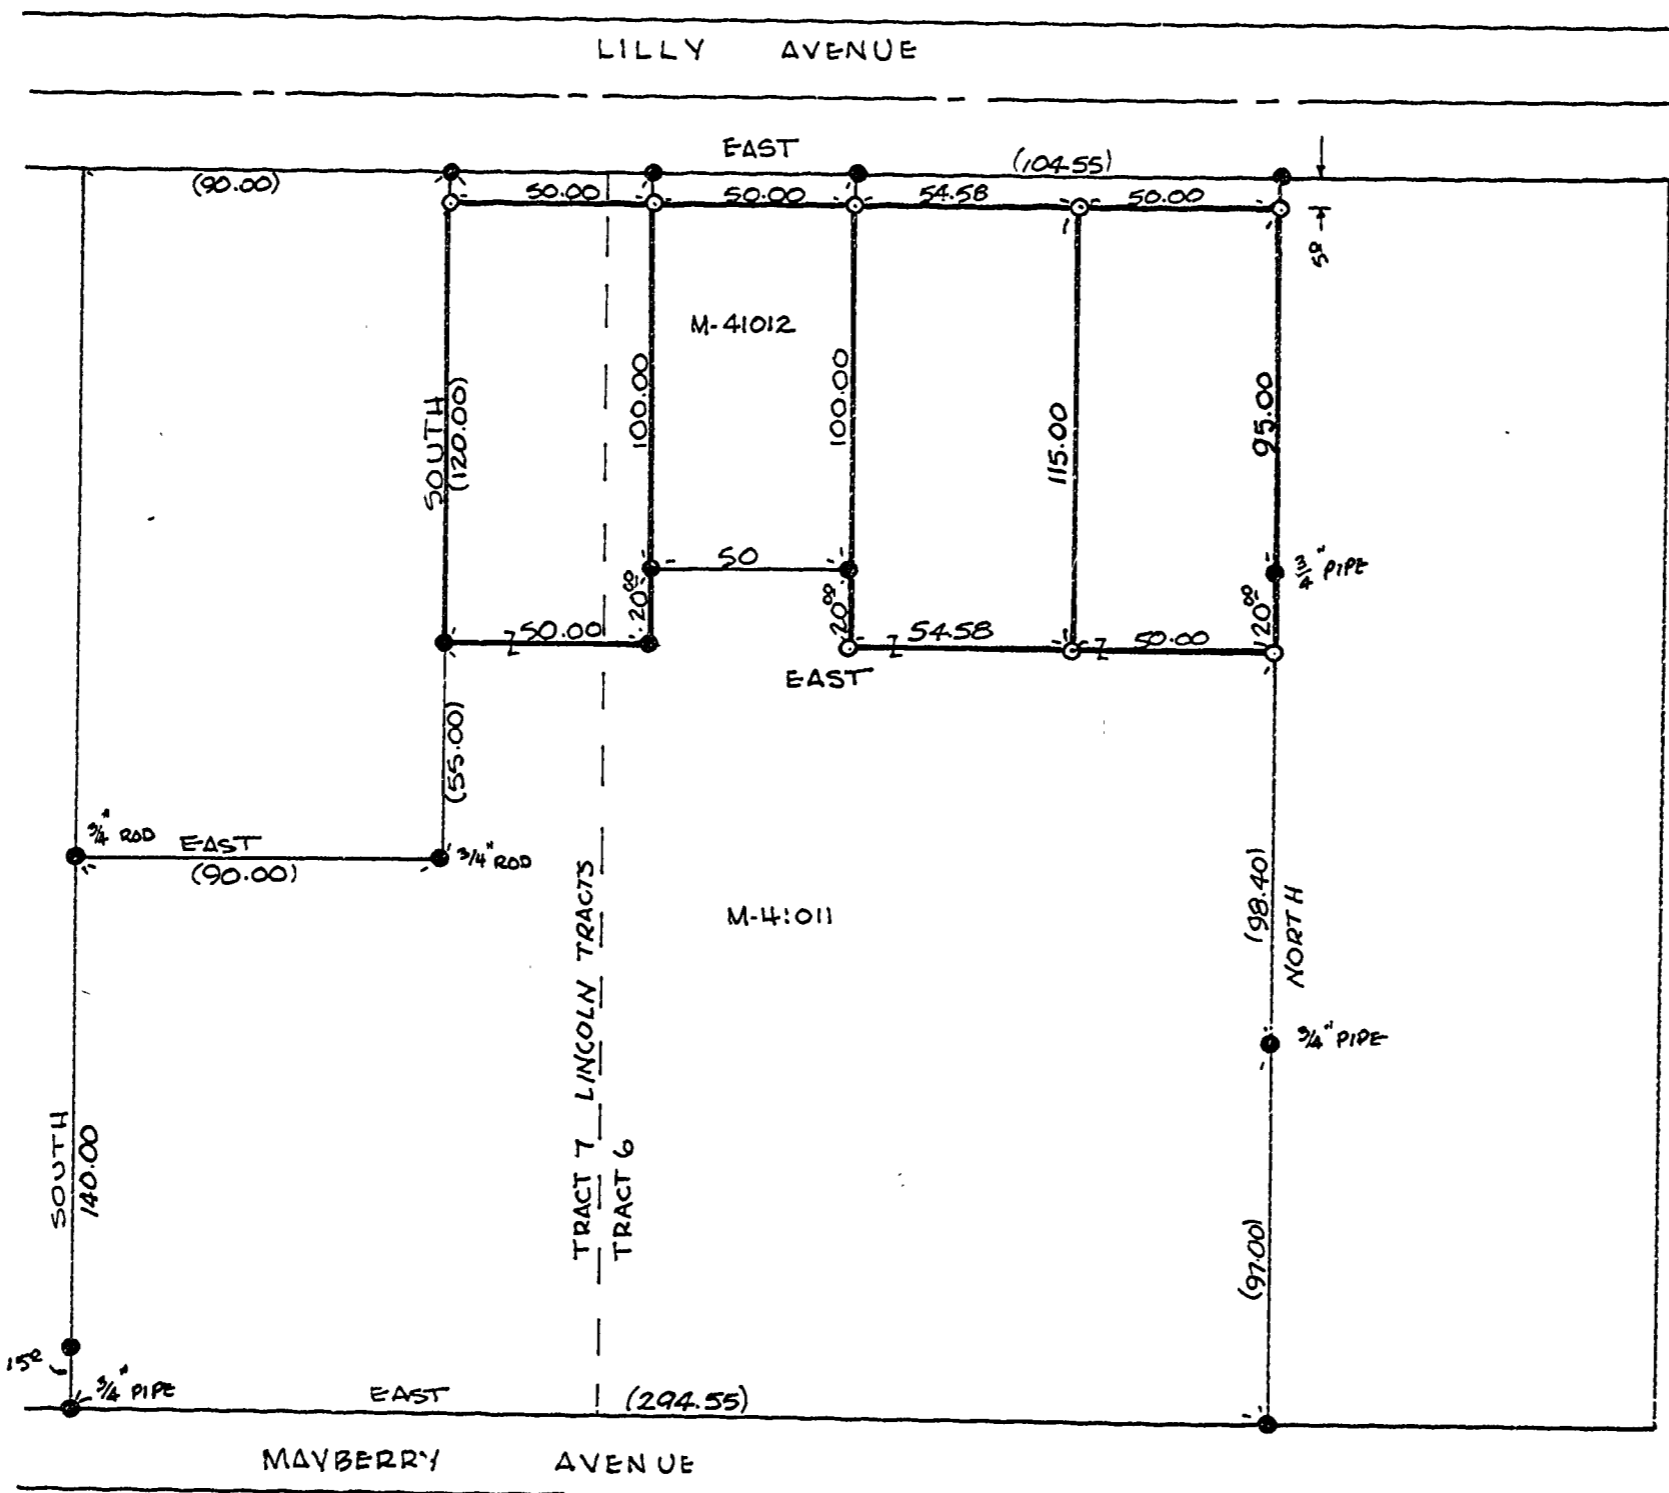

○ 5/16" RODS SET  
 ● 3/8" RODS FOUND  
 ALL OTHERS NOTED

REGISTERED  
 PROFESSIONAL  
 LAND SURVEYOR  
*Tom O. McCullough*  
 OREGON  
 JULY 19, 1954  
 TOM O. McCULLOUGH  
 650

McCULLOUGH, BRYANT & ASSOCIATES  
 CORVALLIS, OREGON  
 89-2