

BETHEL VERNON

E-W & SEC. 35, T.13 S., R.8 W., W.M.
BENTON COUNTY, ORE.

SCALE : 1" = 500' MAY 7, 1974


5671

BERT W. UDELL R.P.E. #2301
BY ARNOLD BRUBAKER R.L.S. #992

REGISTERED
PROFESSIONAL
LAND SURVEYOR

Arnold Brubaker

OREGON
JULY 12, 1973
ARNOLD BRUBAKER
992

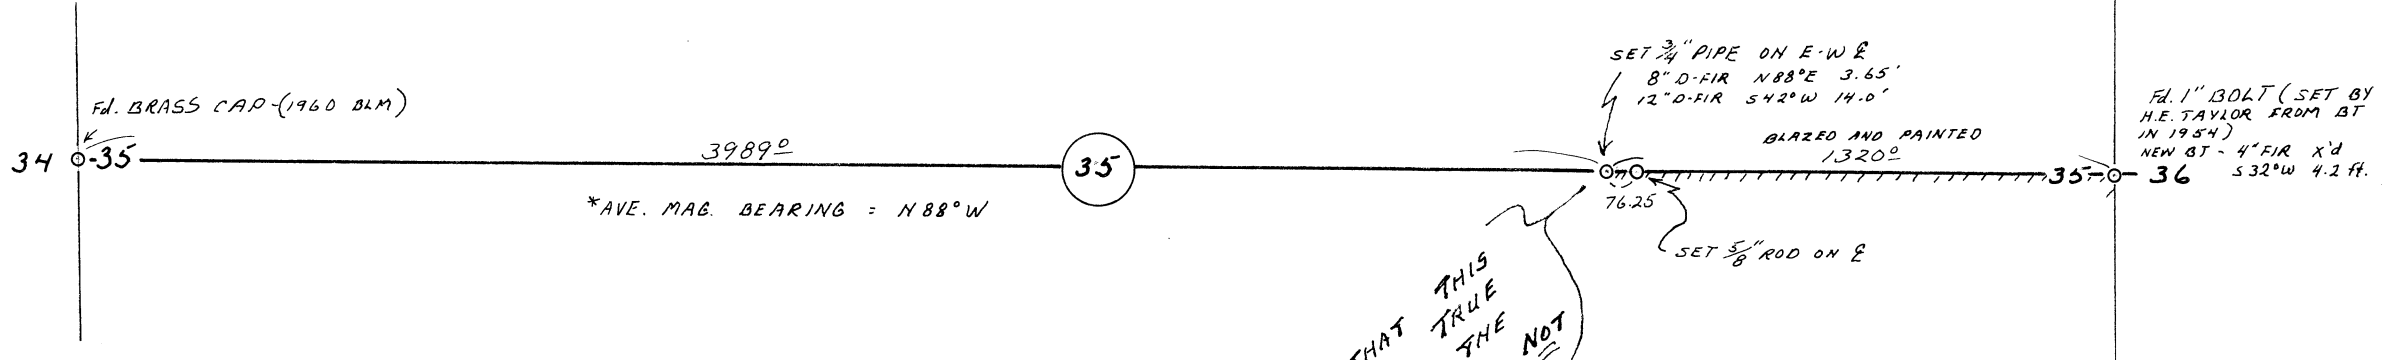

NOTE THAT THIS
IS NOT A TRUE
COR. AS THE
16 SECTION WAS
SUB-DIVIDED

NOT