

05811

RECORD OF SURVEY


FOR HAROLD NELSON

IN The JOHN ROBINSON D. L. C. No. 44

Township 11 South, Range 5 West, W. M.

Benton County, Oregon February, 1975

Scale: 1" = 50'

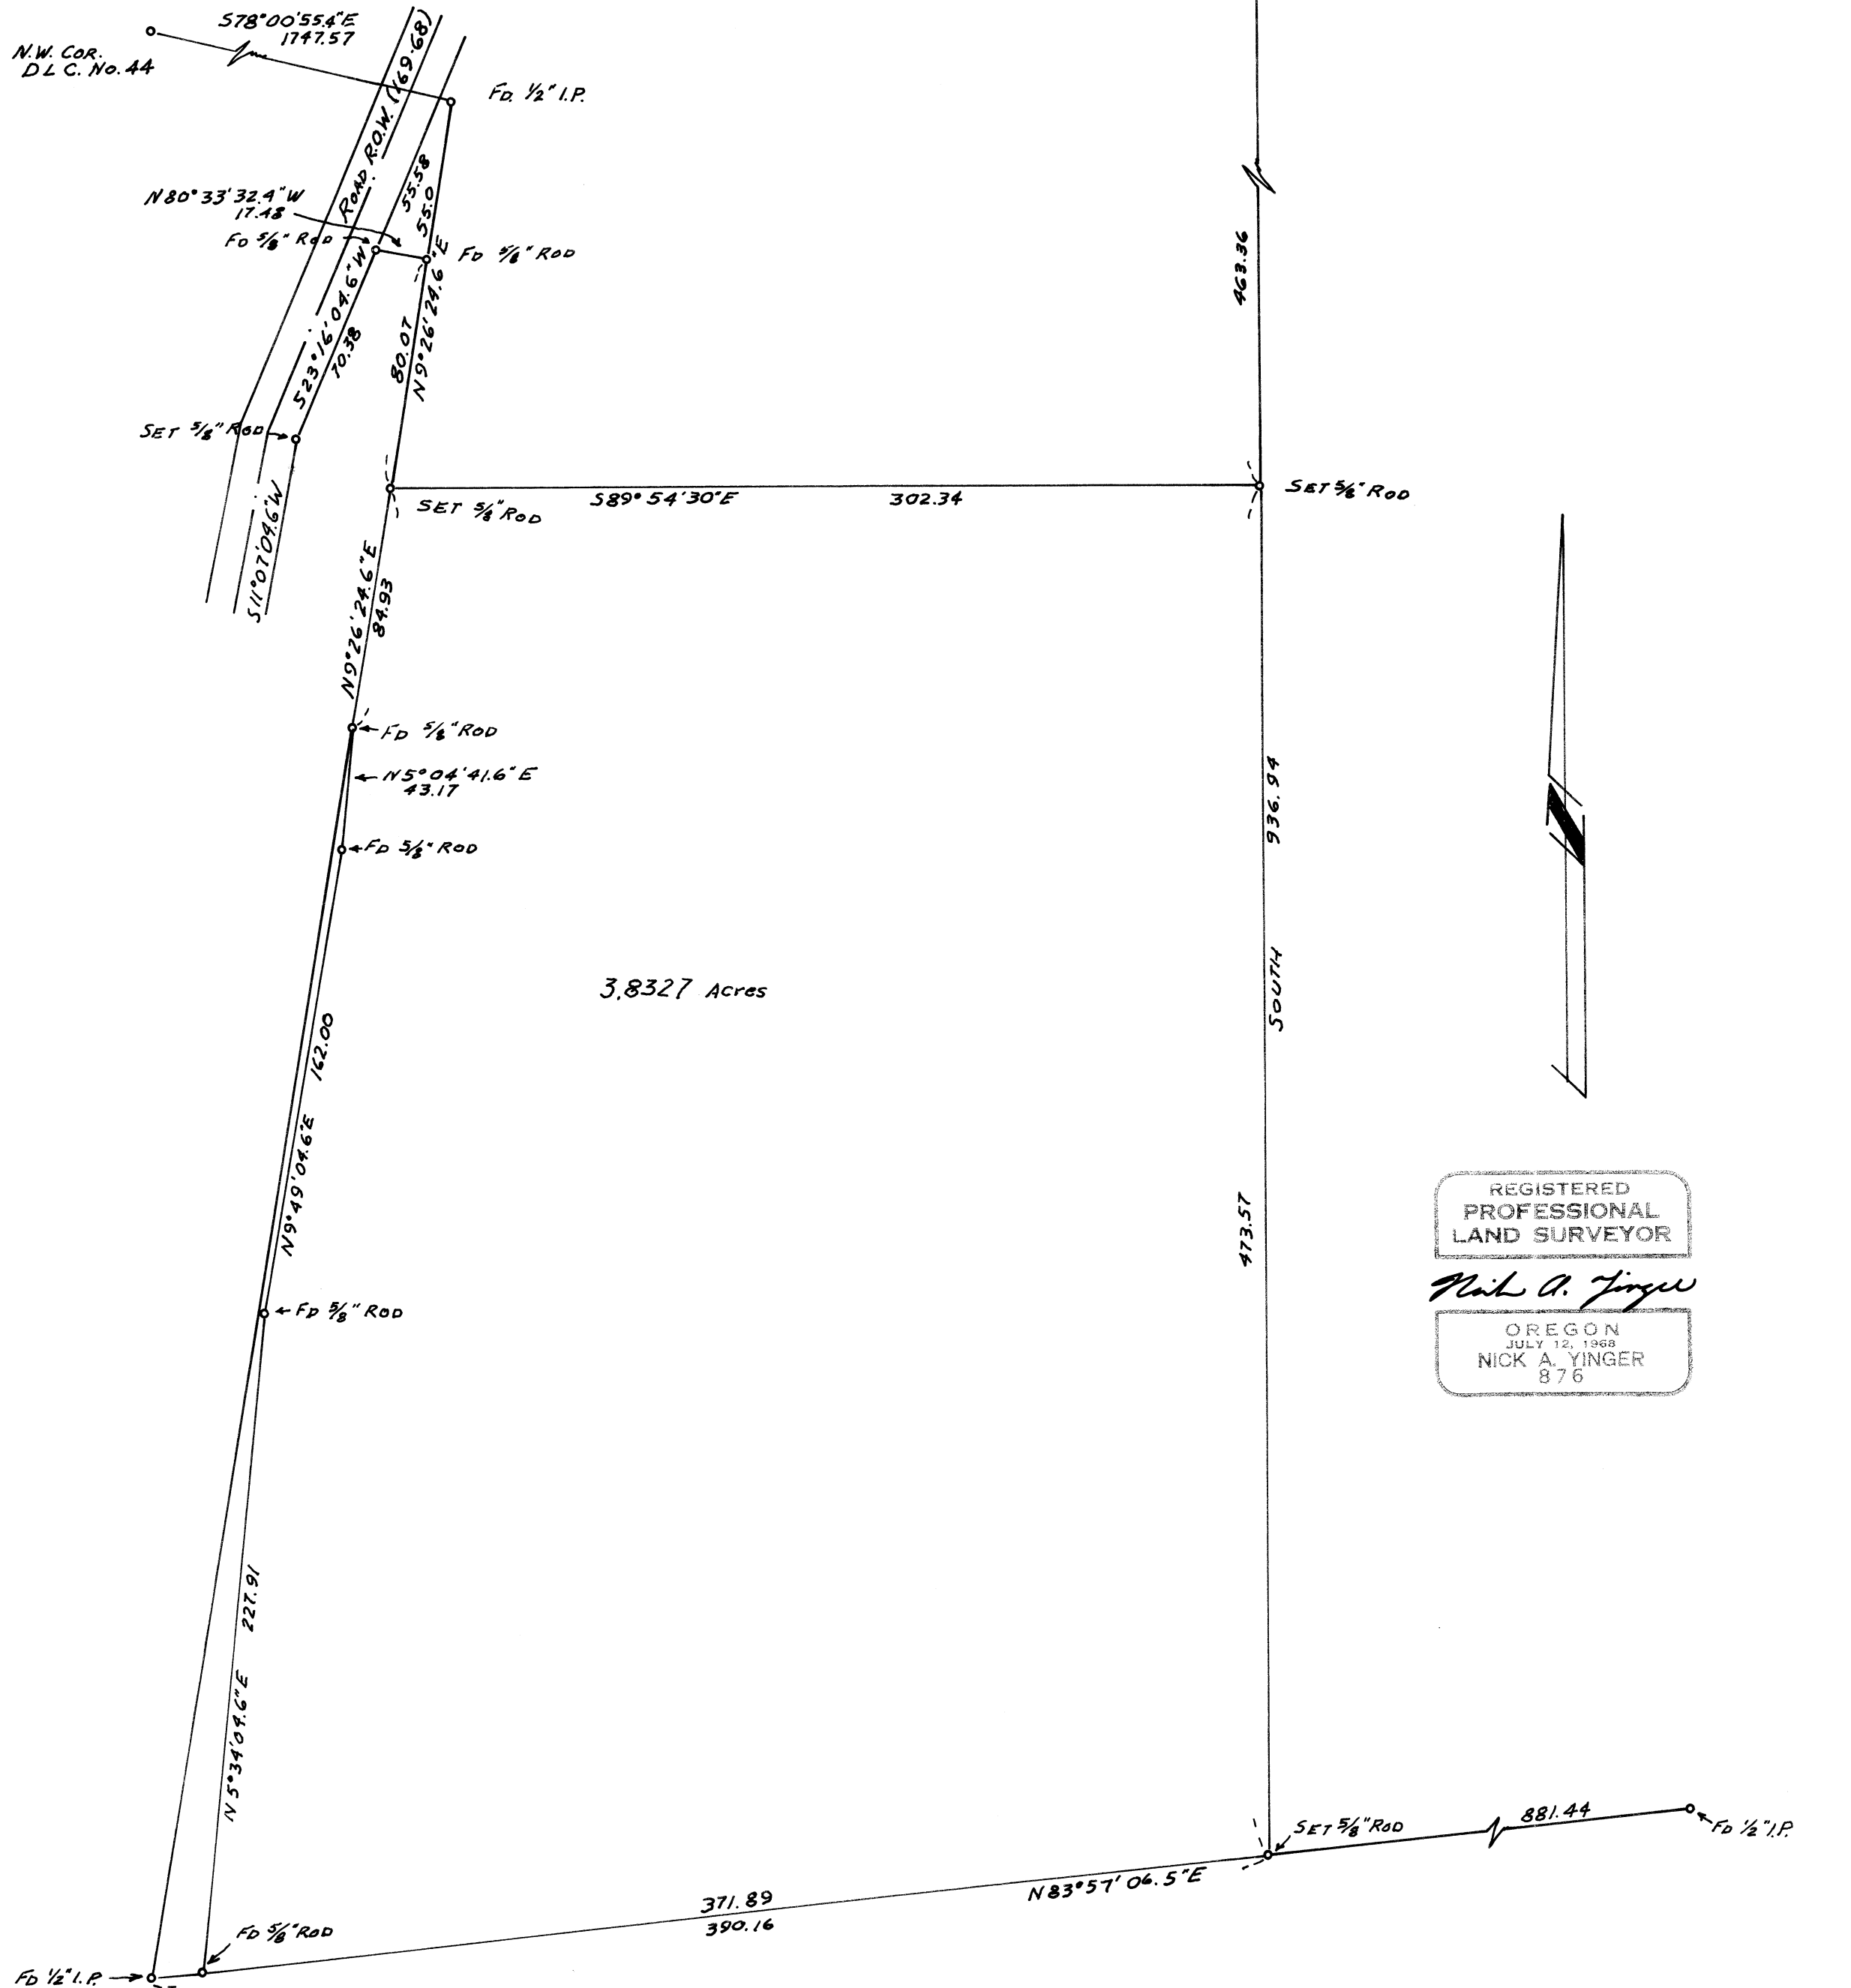

REGISTERED PROFESSIONAL LAND SURVEYOR

Nick A. Yinger

OREGON
JULY 12, 1968
NICK A. YINGER
876

5811

5811

5811

5811