

05881


DAVID L. & PAMELA E. DIEDERICH

Lot 4, Bl. 1, Laura Vista Acres Subdivision
Sec. 35, T.10 S., R.4 W., W. M.
Benton County, Oregon

Scale: 1" = 30'
May 23, 1975

Orris A. Carnegie
Reg. Prof. Land Surveyor

Based on
dedicated
plat

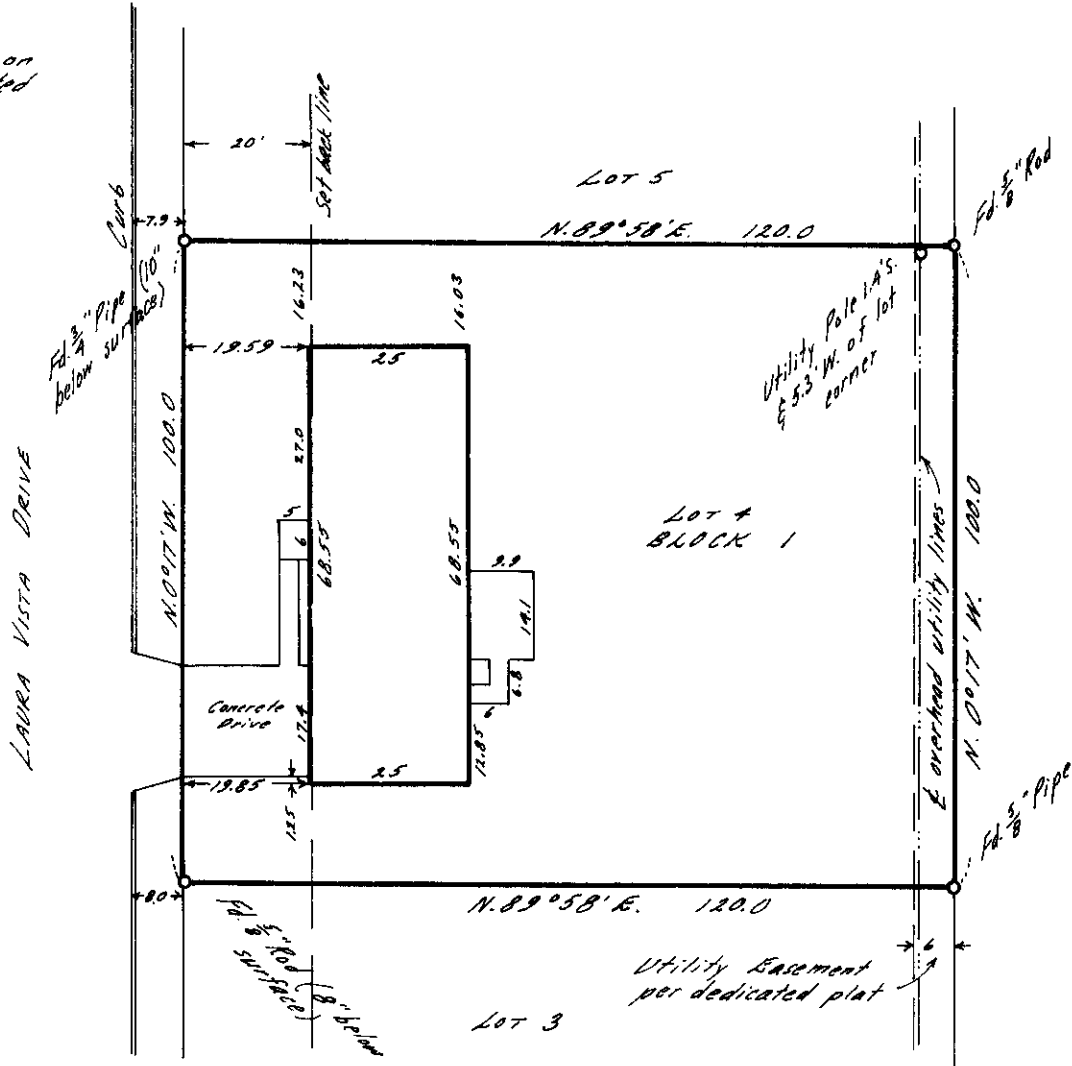

Address: 1783 N. W. Laura Vista Drive, Albany, Oregon.

Description: Lot 4, Block 1, LAURA VISTA ACRES SUBDIVISION,
Benton County, Oregon.

Certificate: I certify that I have surveyed the herein described
property and that I find the improvements shown to
be on the premises in question and that they do not
overlap or encroach on the property adjacent thereto,
except as shown on the map.

REGISTERED
PROFESSIONAL
LAND SURVEYOR

Orris A. Carnegie

OREGON
MAY 9, 1947
ORRIS A. CARNEGIE
213