

05801

RECORD OF SURVEY FOR

**ROY WOODARD**


LOT 159, BLOCK 40

BROWN'S ADDITION, PHILOMATH, OREGON

SCALE 1" = 30'

APRIL 1, 1975

- FOUND 3/4" PIPE
- SET 1/2" ROD

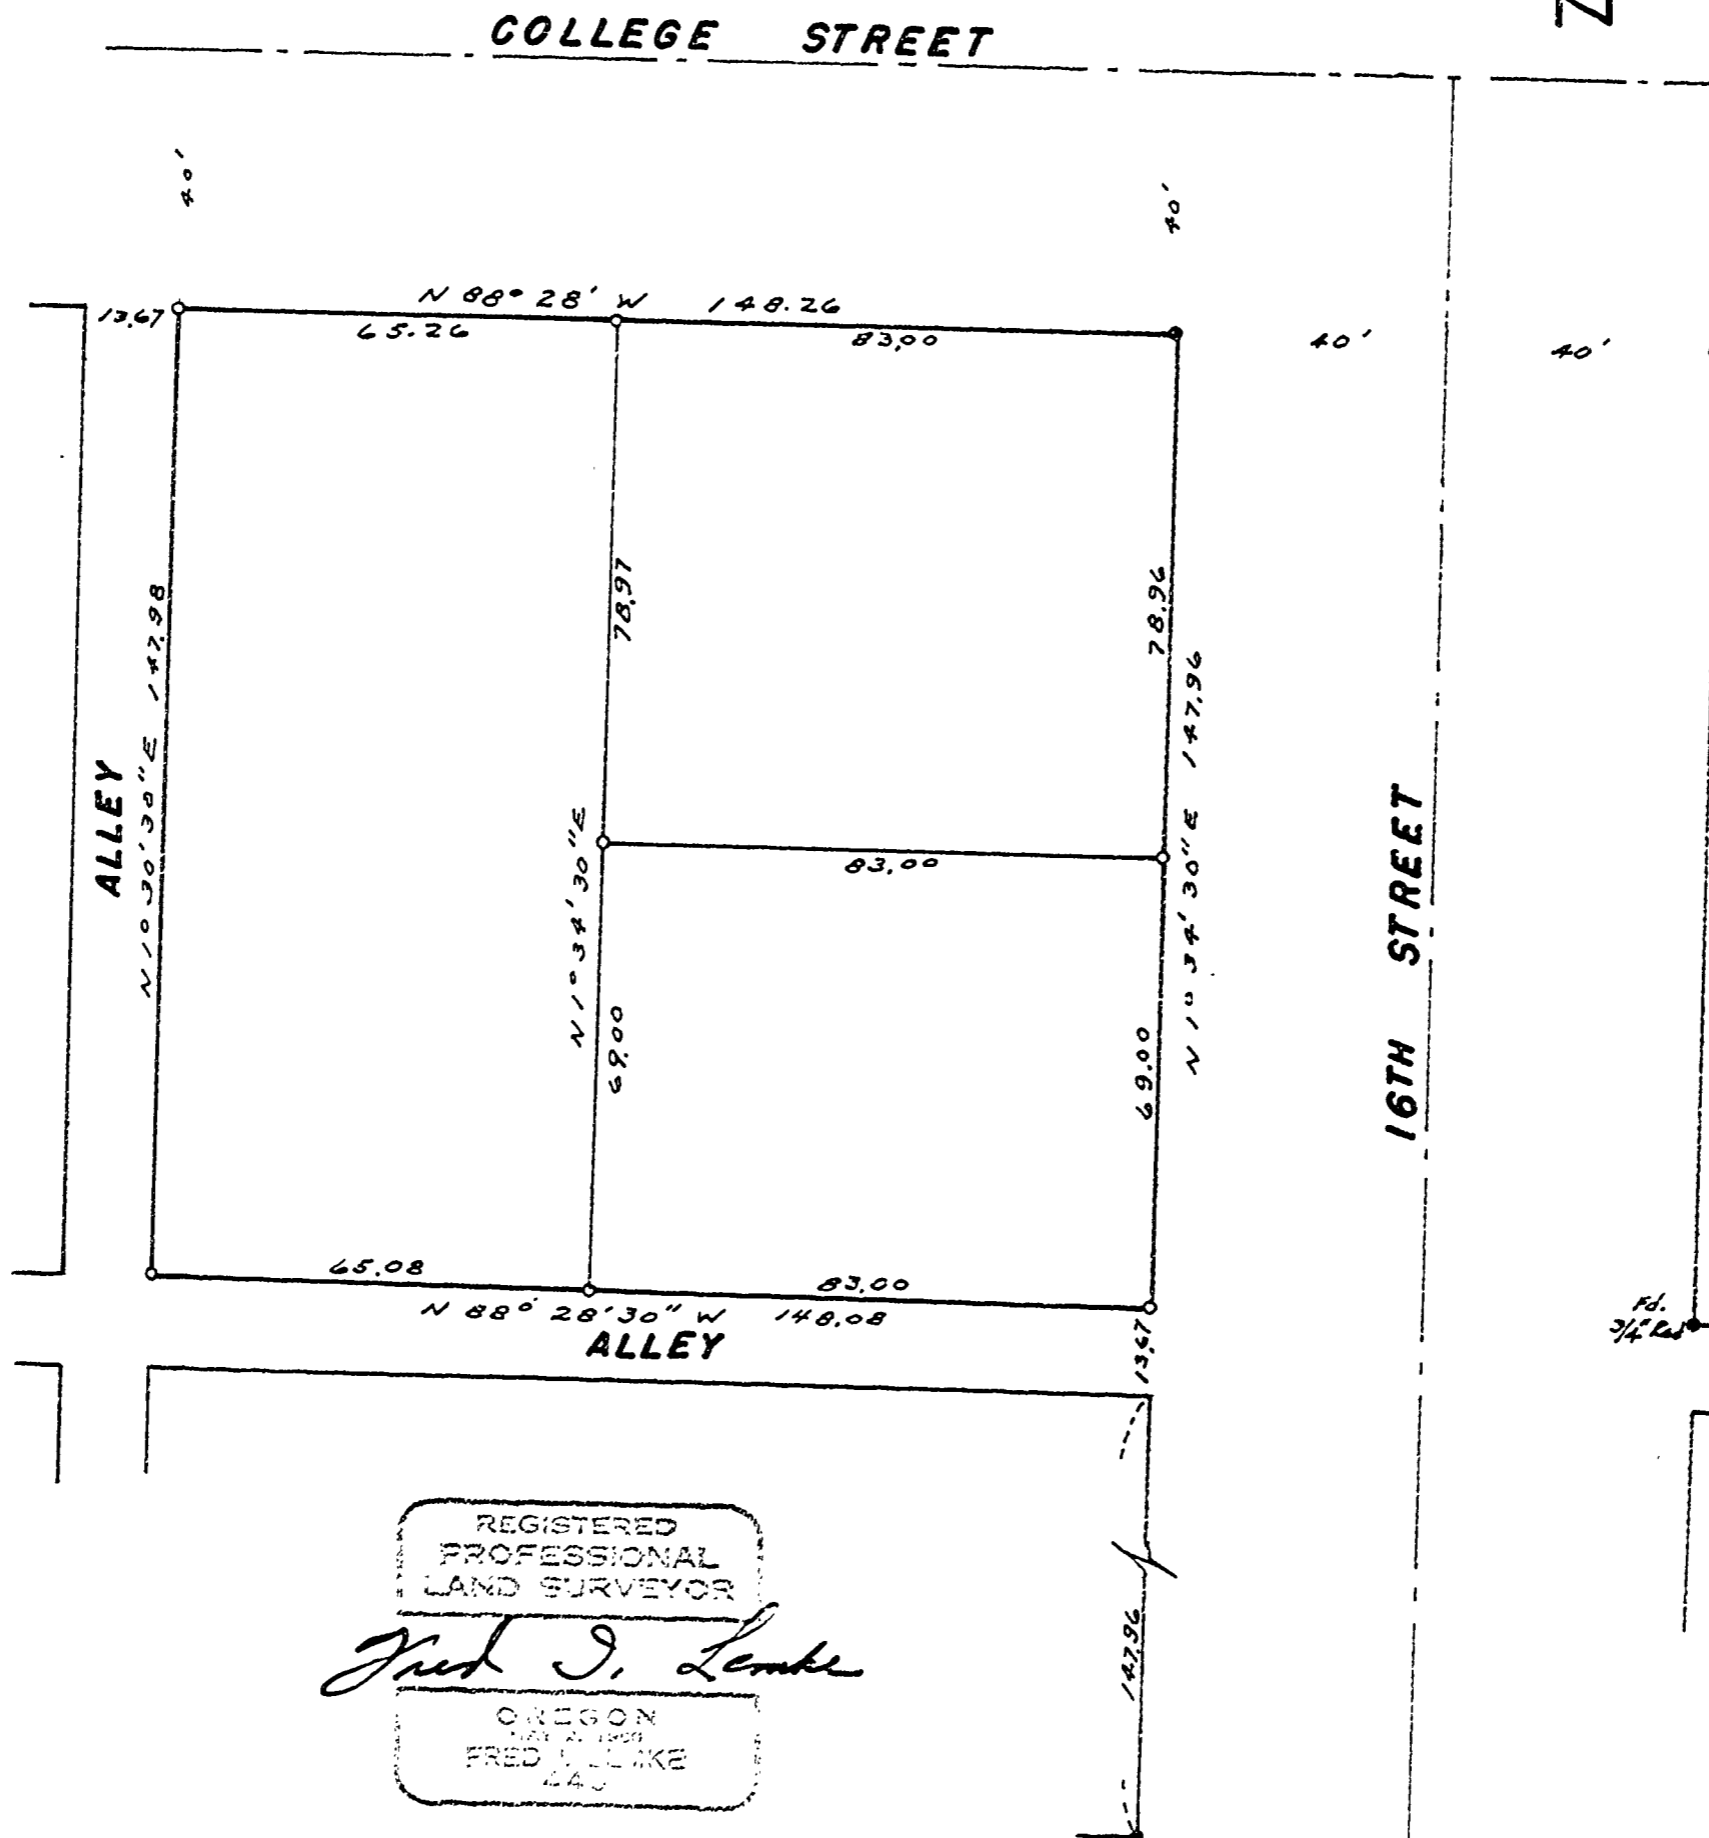

REGISTERED  
PROFESSIONAL  
LAND SURVEYOR

*Fred J. Lenke*

OREGON  
MAY 21 1959  
FRED J. LENKE  
243