

RECORD OF SURVEY

FOR CITY OF CORVALLIS, PUBLIC WORKS DEPT., UTILITIES DIVISION


IN Sections 29 & 30, Township 11 South, Range 4 West, W.M.

Benton County, Oregon 9 July 1975

Scale: 1" = 400'

5897

5897

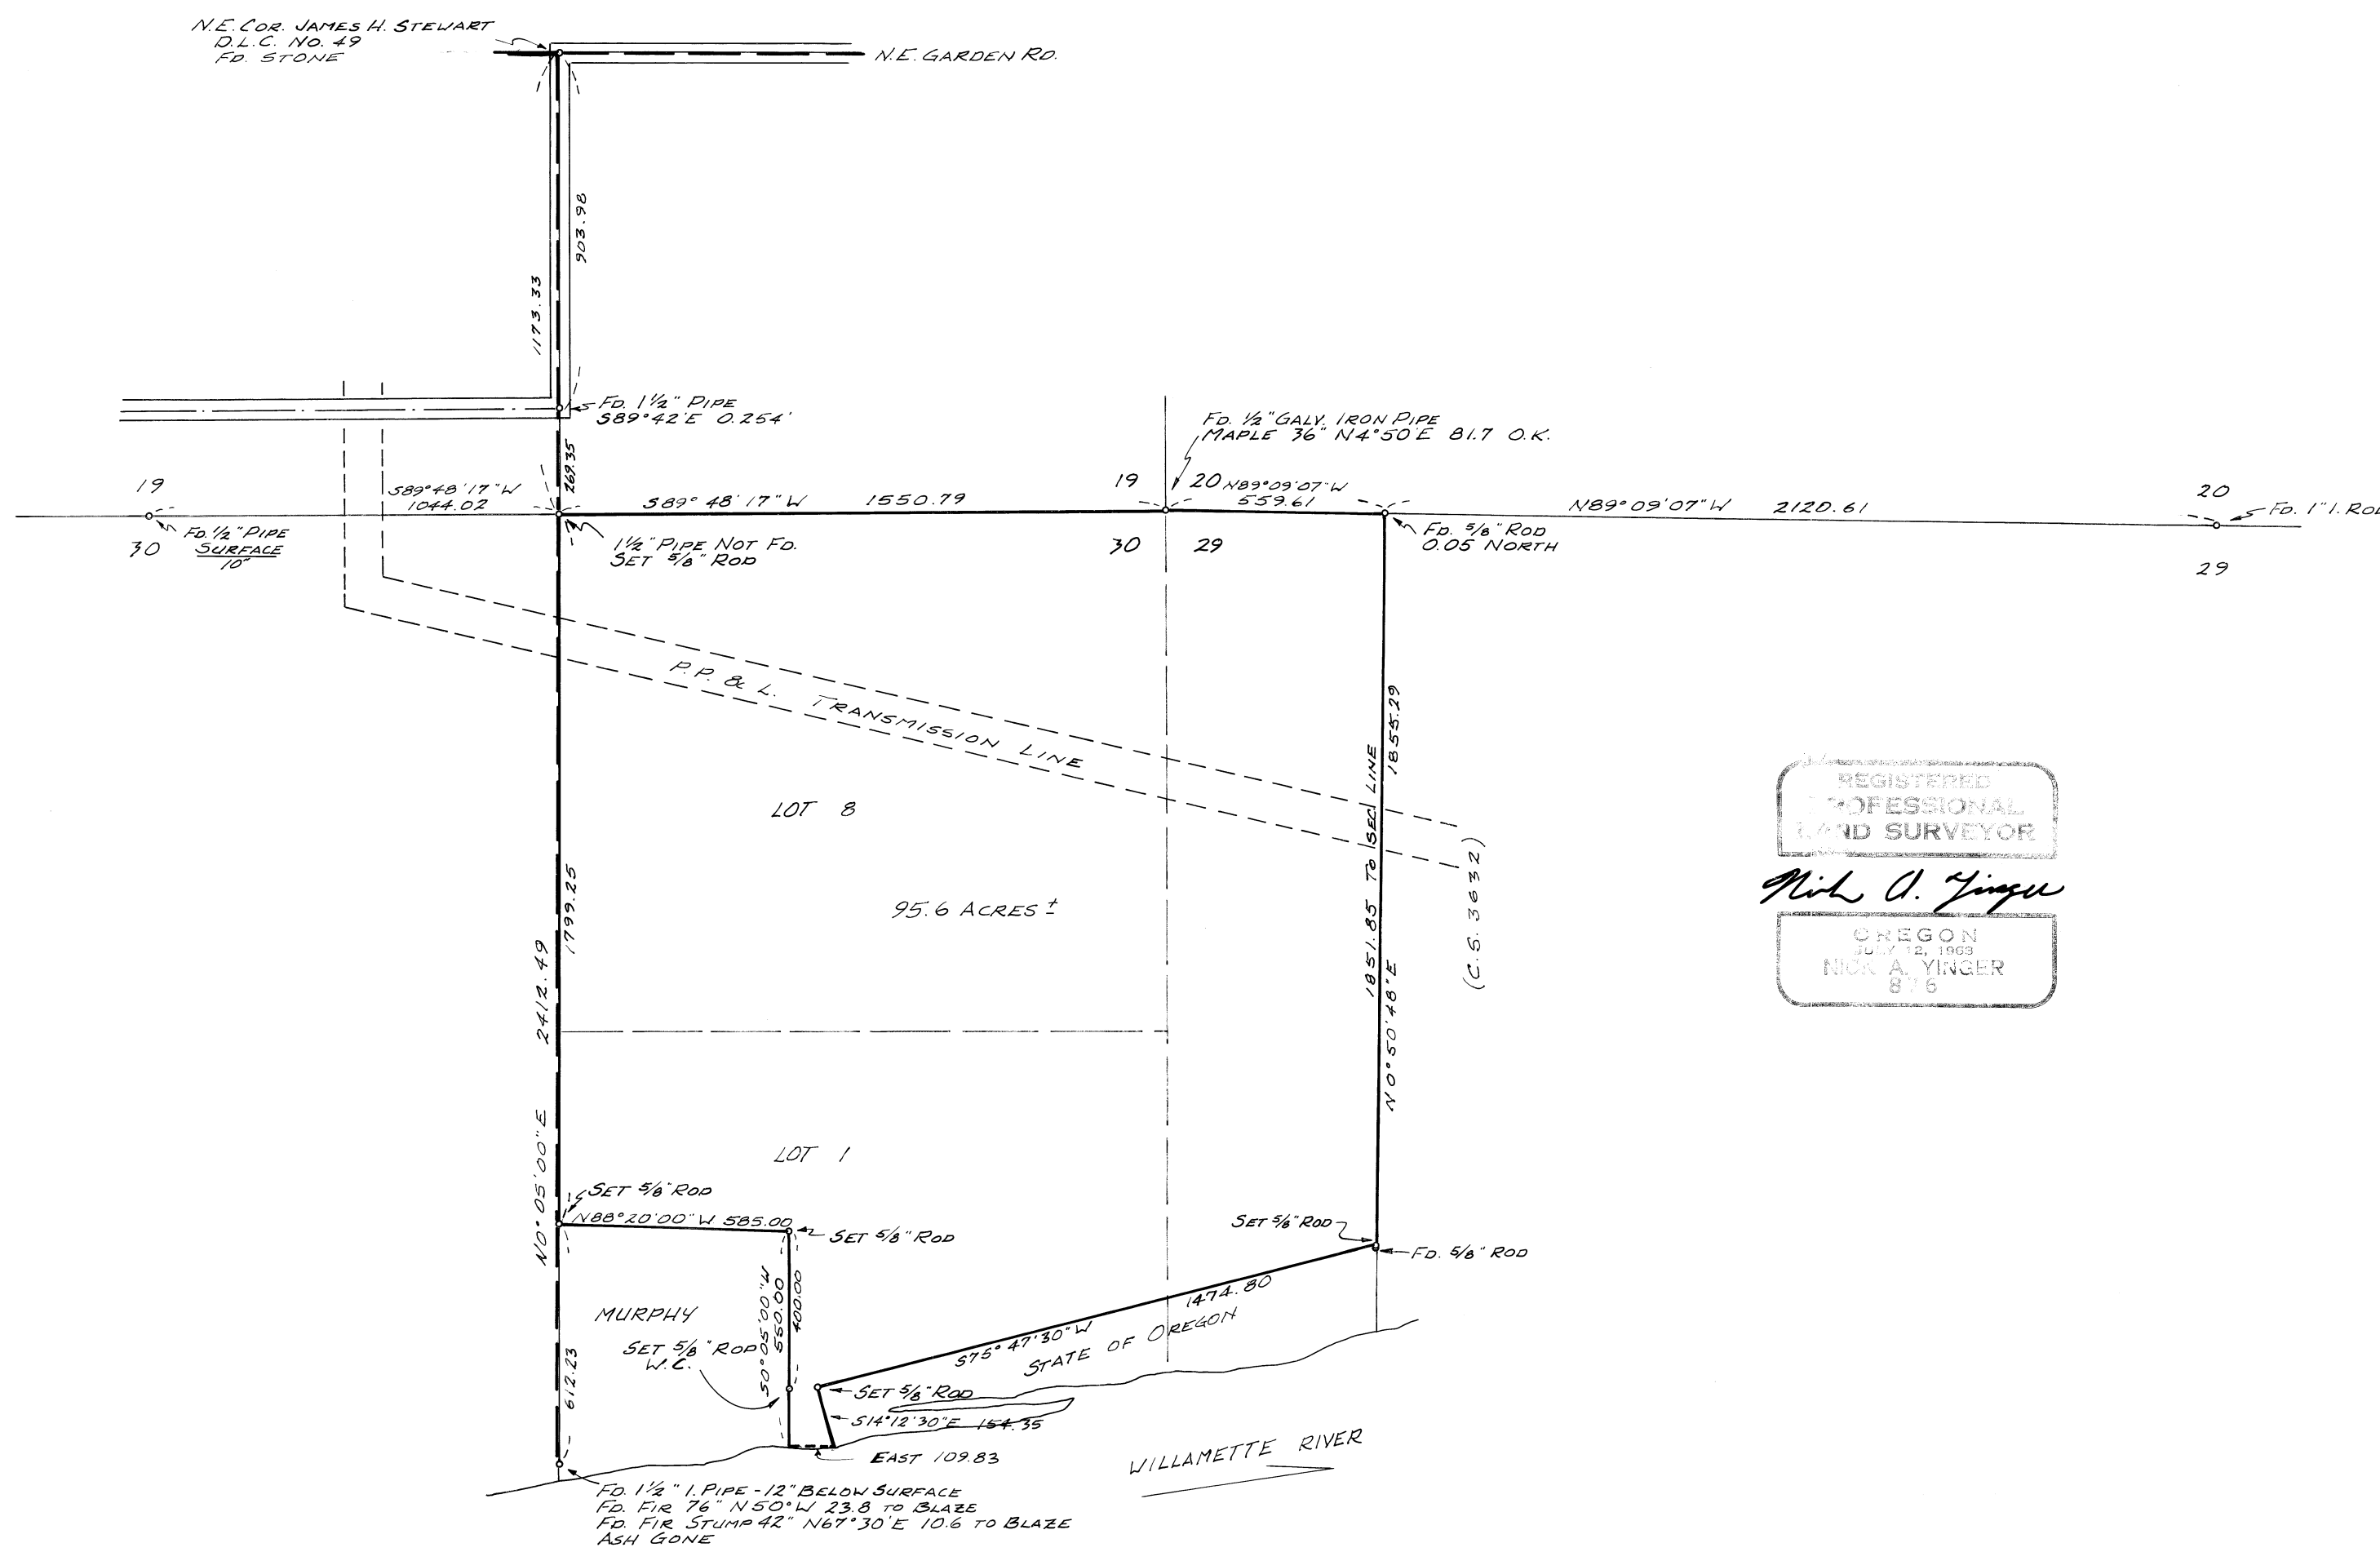

REGISTERED
PROFESSIONAL
LAND SURVEYOR

Nick A. Yinger

OREGON
JULY 12, 1969
NICK A. YINGER
816

5897