


C.S. 05955
 FOR
 DAN POST
 IN
 SECTION 26, T10S., R4W., W.M
 BENTON COUNTY, OREGON

SCALE 1" = 100'

SEPT. 18, 1975

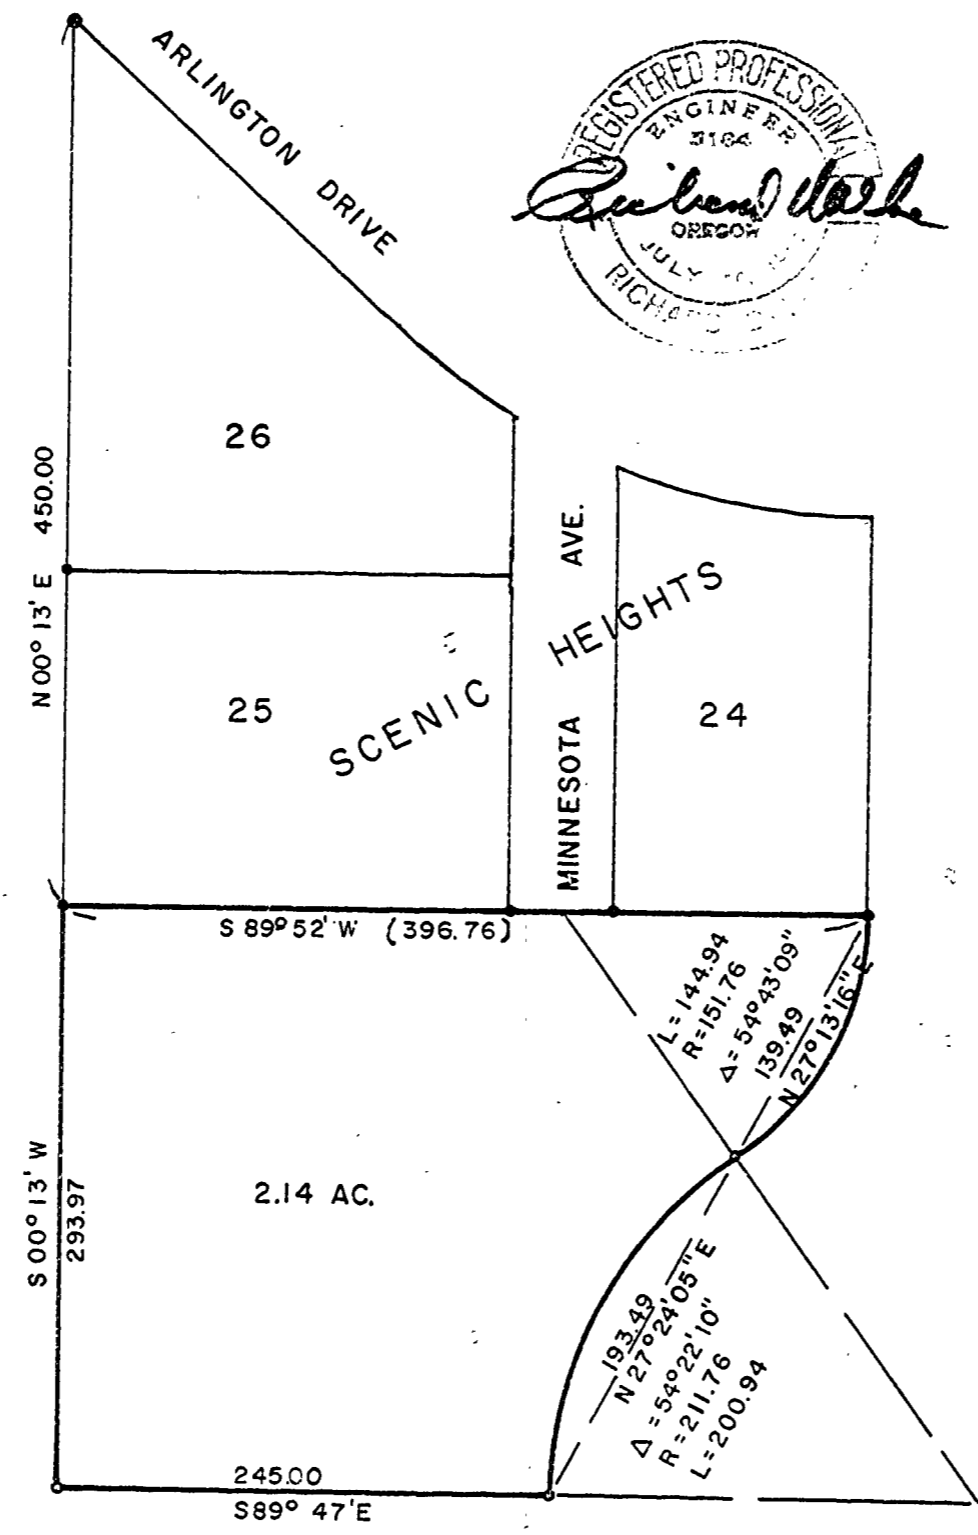

- FOUND MONUMENT OF RECORD
- SET 5/8" IRON ROD