

05961

RECORD OF SURVEY


FOR **NORMA THOMPSON**

IN The JAMES BENNETT D.L.C. No. 45

Township 12 South, Range 5 West, W. M.

Benton County, Oregon October, 1975

Scale: 1" = 100'

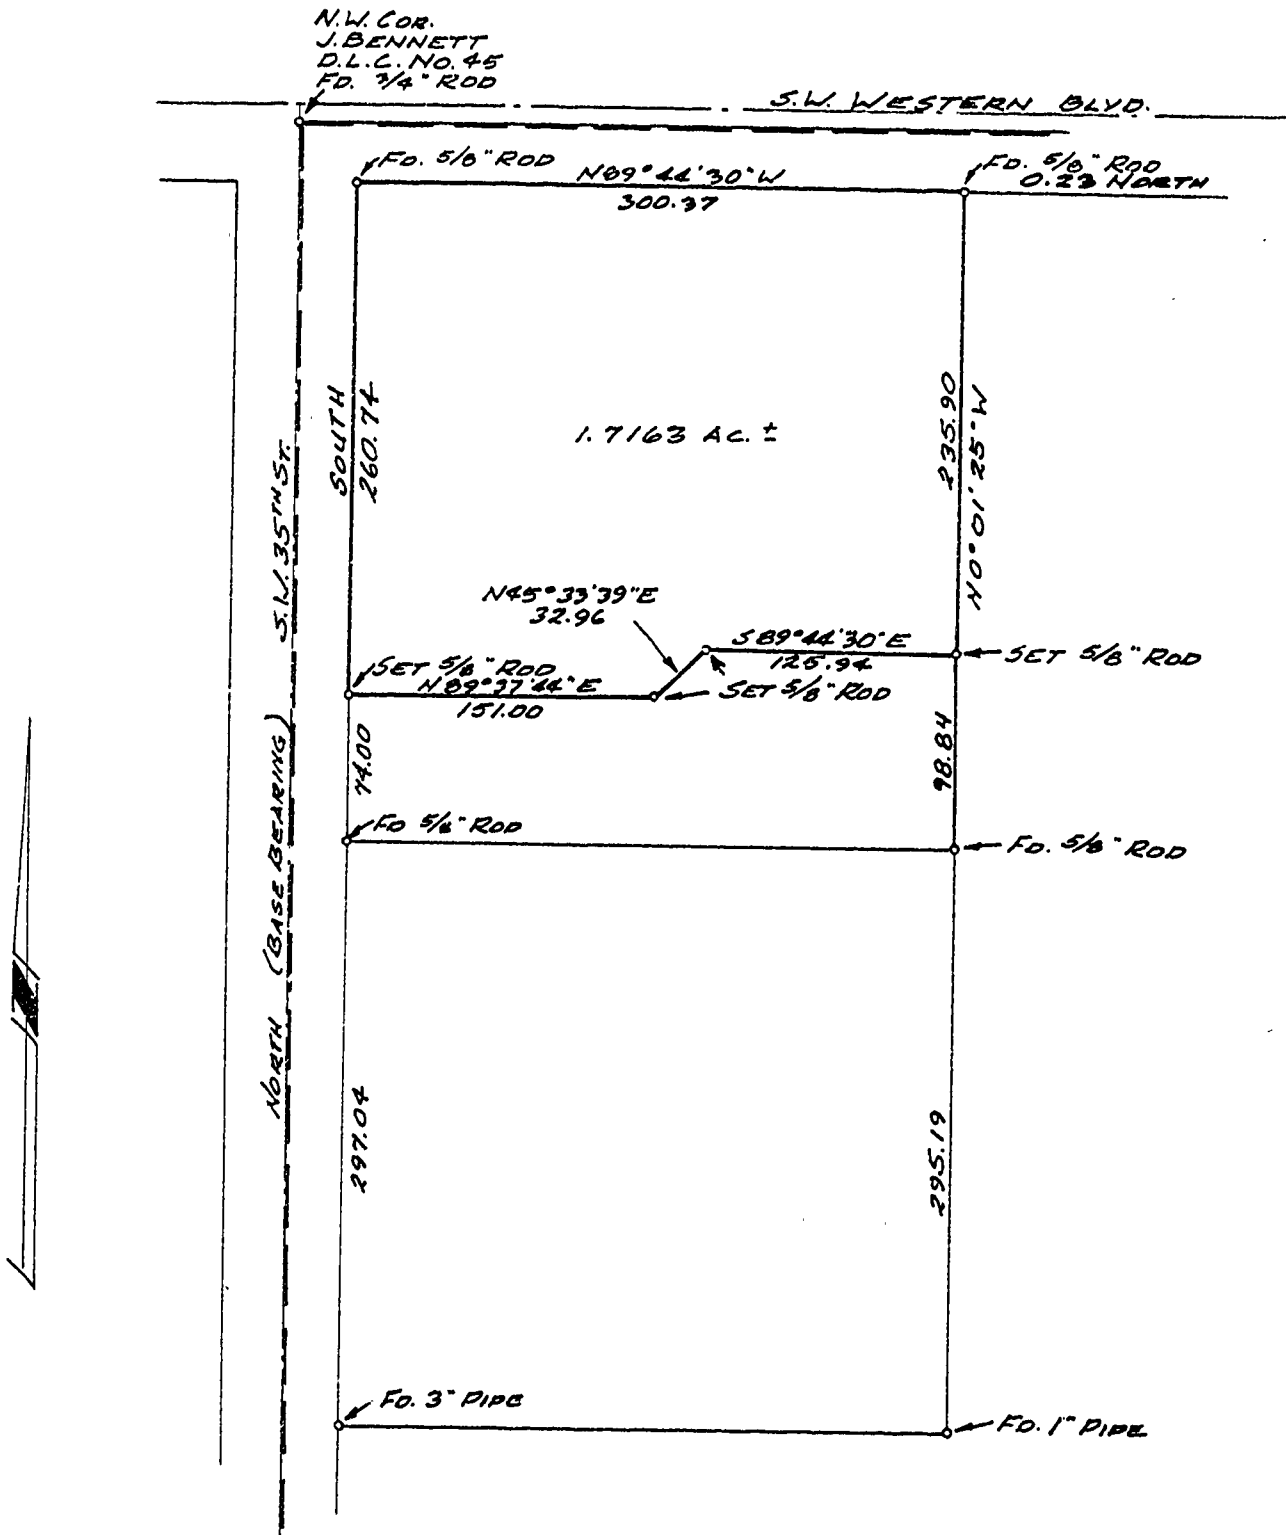

REGISTERED
PROFESSIONAL
LAND SURVEYOR

Nick A. Yinger

OREGON
JULY 12, 1963
NICK A. YINGER
876