


● INDICATES 1" IRON PIPE FOUND EXCEPT AS INDICATED  
 ○ INDICATES 5/8" X 30" IRON ROD SET

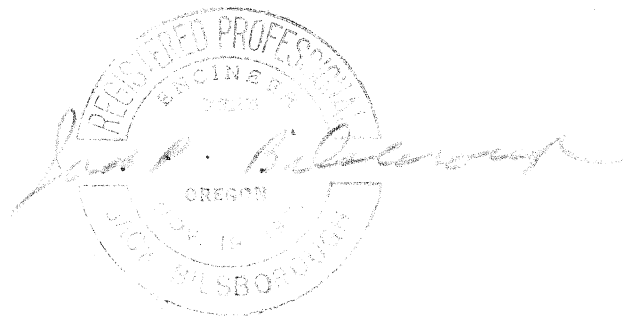

05976

REGIONAL ENGINEERING & DEVELOPMENT CO., CORVALLIS, OREGON		
MAP OF SURVEY FOR CARVEL W. WOOD IN SEC. 4, T.11S., R.5W., W.M., BENTON CO., OREGON		
DES.	DWN.	CKD.
DATE 12-16-75	SCALE 1" = 100'	SHEET 1 OF 1