


05985  
 RECORD OF SURVEY  
 FOR **JOHN PICKETT**  
 IN Section 22, Township 14 South, Range 6 W., W. M  
 Benton County, Oregon December 1975  
 Scale: 1" = 200'

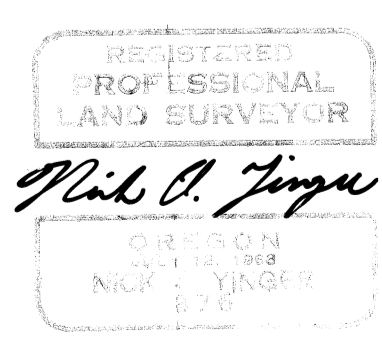

5985