

06070

RECORD OF SURVEY

FOR VERN MADES



IN The WILLIAM F. DIXON D.L.C. No. 50

SEC 35 Township II South, Range 5 West, W.M.

Corvallis, Oregon 28 April, 1975

BUCHANAN ST.

Scale: 1" = 50'

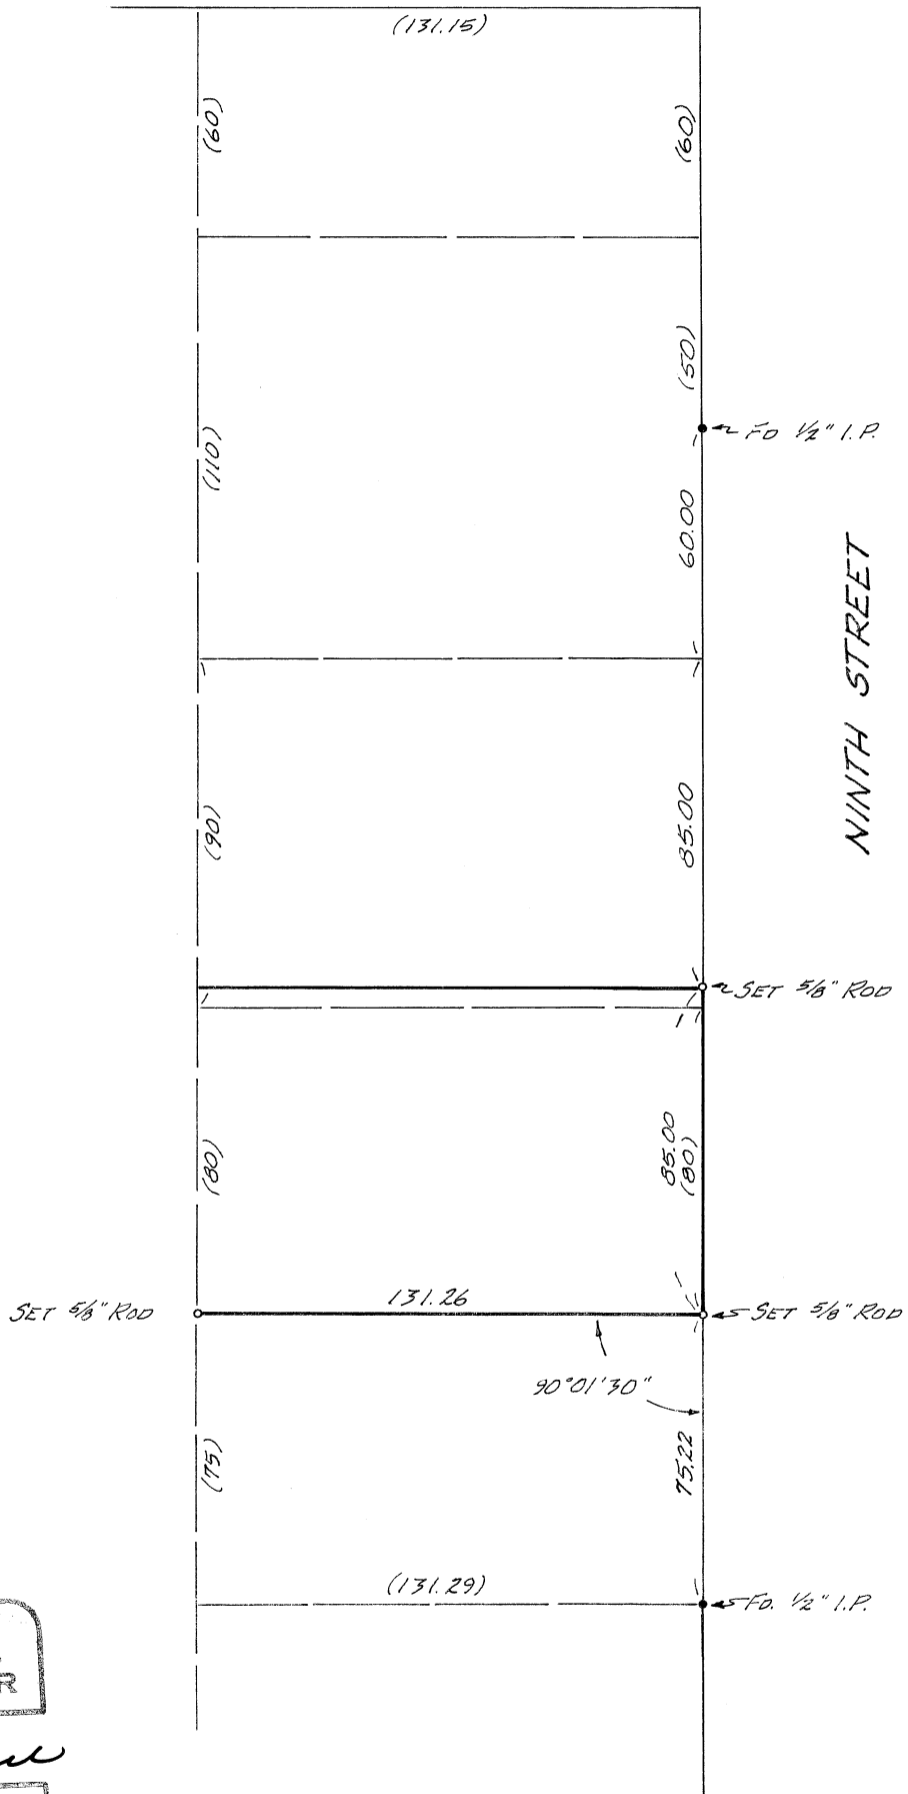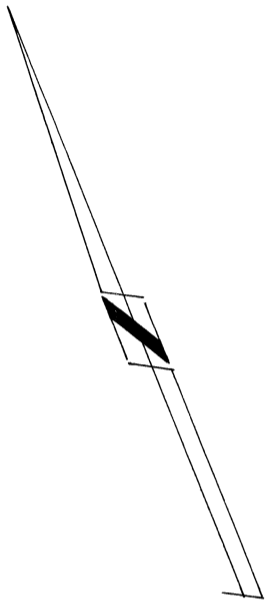

REGISTERED
PROFESSIONAL
LAND SURVEYOR

Nick A. Yinger

OREGON
JULY 12, 1905
NICK A. YINGER
876